

PUB. SEWER STATUS VERIFIED BY NA

7/29/03 Flu 1pm
NOT READY

ISSUE DATE: 7/15/03

P 519051

APPROVAL DATE: 8/1/03

A REPAIR

PERMIT

INDEXED

ON-SITE SEWAGE DISPOSAL SYSTEM
HOWARD COUNTY HEALTH DEPARTMENT
BUREAU OF ENVIRONMENTAL HEALTH

04-312546

Hatfields Equipment IS PERMITTED TO INSTALL ALTER

ADDRESS: 13785 Burntwoods Road, Glenelg PHONE NUMBER: 301-854-6172

SUBDIVISION: Gwenlee Estates LOT NUMBER: 7, Blk B, S

ADDRESS: 14081 Gared Drive PROPERTY OWNER: Paul Johnson

SEPTIC TANK CAPACITY (GALLONS): Existing 1250

PUMP CHAMBER CAPACITY (GALLONS): N/A

NUMBER OF BEDROOMS: 4

SQUARE FEET PER BEDROOM: 180

LINEAR FEET OF TRENCH REQUIRED: 140 total, Existing 70' + 70' new trench

TRENCHES:	Trench to be 2 feet wide. Inlet ⁴ / ₂ feet below original grade. Bottom maximum depth ⁸ / ₂ feet below original grade. Effective area begins at ⁴ / ₂ feet below original grade. <u>4</u> feet of stone below distribution pipe.
LOCATION:	<u>Run 2-70' trenches from distribution box.</u> <u>Allow Dry well to rest for future.</u>
PURPOSE:	Septic system has failed. Call for inspection when the ground is opened so sanitarian can recommend repair.


PLANS APPROVED: KN DATE: 7/15/03

- NOTE: PERMIT VOID AFTER 2 YEARS
- NOTE: CONTRACTOR RESPONSIBLE FOR SCHEDULING A PRE-CONSTRUCTION INSPECTION FOR ALL INSTALLATIONS
- NOTE: WATERTIGHT SEPTIC TANKS REQUIRED
- NOTE: ALL PARTS OF SEPTIC SYSTEM SHALL BE 100 FEET FROM ANY WATER WELL
- NOTE: MANHOLE RISERS REQUIRED ON ALL SEPTIC TANKS AND PUMP CHAMBERS

NEITHER THE HOWARD COUNTY COUNCIL NOR THE HEALTH DEPARTMENT IS RESPONSIBLE FOR THE SUCCESSFUL OPERATION OF ANY SYSTEM PERMITTEE RESPONSIBLE FOR OBTAINING FINAL APPROVAL ON THIS PERMIT CALL 410-313-2640 FOR INSPECTION OF SEPTIC SYSTEM

519051

NOT TO SCALE

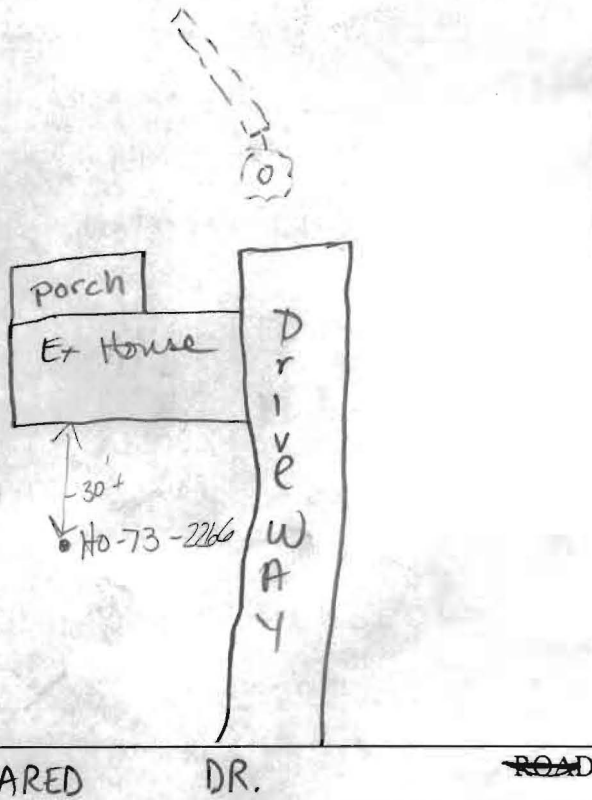

TRENCH/DRAINFIELD DATA		
WIDTH	INLET	BOTTOM
_____	_____	_____
NUMBER OF TRENCHES _____		
TOTAL LENGTH _____		
ABSORPTION AREA _____		
DISTRIBUTION BOX LEVEL _____		
DISTRIBUTION BOX BAFFLE _____		
DISTRIBUTION BOX PORT _____		

SEPTIC TANK DATA	
SEPTIC TANK 1 LEVEL	<u>EX tank</u>
CAPACITY	<u>1250</u> GAL
SEAM LOC	<u>?</u>
TANK LID DEPTH	_____
BAFFLES	_____
BAFFLE FILTER	_____
MANHOLE LOC	_____
6" PORT LOC	_____
WATERTIGHT TEST	_____
SEPTIC TANK 2 LEVEL	<u>N/A</u>
CAPACITY	_____ GAL
SEAM LOC	_____
TANK LID DEPTH	_____
BAFFLES	_____
BAFFLE FILTER	_____
MANHOLE LOC	_____
6" PORT LOC	_____
WATERTIGHT TEST	<input checked="" type="checkbox"/>

PRE-CONSTRUCTION 7/15/03 See Site insp. sheet for perc hole location, OLD notes state drywell inlet @ 5', we measured
 INSTALLATION 4 1/2'. May deep trench. spec's to Inlet at 5' bottom at 9' if needed (KN) 8/1/03 See attached illustration faxed by Hatfields (KN)

FINAL INSPECTOR Kacie Noonan

DATE OF APPROVAL 8/1/03