

SYSTEM TO BE INSTALLED FIRST
BEFORE BUILDING PERMIT IS
SIGNED.

PERMIT

SEWAGE DISPOSAL SYSTEM

MARYLAND STATE DEPARTMENT OF HEALTH

HOWARD COUNTY

P 21470
A 20493

ELLICOTT CITY
DISTRICT 6th
DATE 5/1/75

INDEXED

7/10/75

Jack Fyock IS PERMITTED TO INSTALL ALTER

ADDRESS Ten Oaks Road, Glenelg, Maryland PHONE 286-2939

A SEWAGE DISPOSAL SYSTEM LOCATED AT _____

SUBDIVISION _____ ROAD Harding Road LOT _____

PROPERTY OWNER Mr. Fred Tinetti

ADDRESS 11451 Harding Road, Laurel, Maryland

SPECIFICATIONS 3 bedrooms

DRAIN FIELD _____ DEPTH _____ FEET, BOTTOM AREA _____ SQ. FT.

SEEPAGE PITS _____ ABSORBENT SIDE-WALL AREA _____ SQ. FT.

SEPTIC TANK CAPACITY 1000 GALLONS

FOR GARBAGE GRINDER, INCREASE DISPOSAL AREA 22% & TANK CAPACITY 50%.

OTHER DRY WELL - 400 sq. ft. absorbent sidewall area to begin at 3 ft. below original grade. Maximum depth is 13 ft. Locate dry well 25 ft. from rear property line and 40 ft. from right side line as seen from Harding Road. INSTALL SYSTEM FIRST. Well to be installed on opposite knoll (high part of lot).

NOTE: ALL PIPE FROM HOUSE TO DISPOSAL AREA MUST BE CAST IRON.
PERMIT VOID AFTER THREE YEARS.

NOTE: INSTALL STAND PIPE ON SEPTIC TANK AND DRY WELL. STAND PIPES MUST BE 6 INCHES IN DIAMETER. CAST IRON, CONCRETE OR TERRA COTTA ACCEPTED.

PLANS APPROVED BY Robert V. Torre DATE 10/23/74

FILL SEPTIC TANK AND DISTRIBUTION BOX WITH WATER BEFORE CALLING FOR AN INSPECTION. COVER NO WORK UNTIL INSPECTED AND APPROVED.


NEITHER THE HOWARD COUNTY COMMISSIONERS NOR THE HEALTH DEPARTMENT IS RESPONSIBLE FOR THE SUCCESSFUL OPERATION OF ANY SYSTEM.

A 20493

20493

8/12/75 TANK NOT YET HOOKED UP
TALKED TO MR. KRUEGER
WELL NOT YET INSTALLED

9/24/76 Saw small section of pipe about 4
feet from house - section was cut off

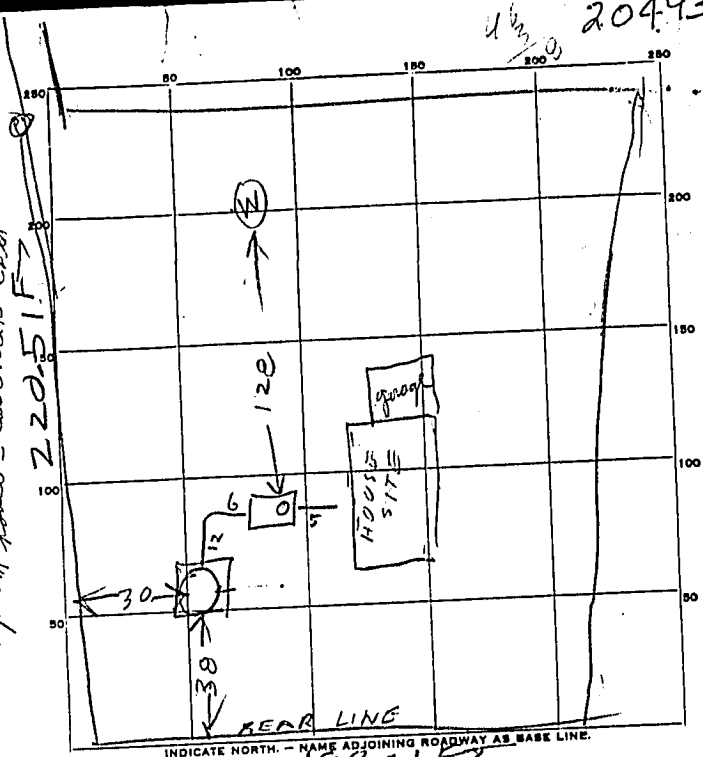

1 1/2
41

PERMIT CARD _____

SEPTIC TANK, LEVEL OK 1000 CONCRETE CLEANOUTS OK

DISTRIBUTION BOX, LEVEL TOP 12 1 FT below grade

TILE FIELD, DEPTH _____ FT. TRENCH WIDTH _____ FT.

GRAVEL DEPTH _____ IN. TOTAL LENGTH _____ FT.

NUMBER OF TRENCHES _____ TOTAL BOTTOM AREA _____

SEEPAGE PITS, INSIDE DIAMETER 12 FT. DEPTH BELOW INLET M FT.

ABSORBENT AREA 217 SQ. FT. COUNTING STONE 392

15
14
14
14
14
56
352

REMARKS 5/14/75 - DRY WELL INLET 3 FT BELOW GRADE

PERIMETER DW 56 FT 392 sq ft and well down

OK TO ISSUE BLDG PERMIT CALL FOR

INSPECTION OF HOUSE SEWER WHEN IT IS

HOOKEED TO HOUSE. NO WATER WELL SEEN RH

7/10/75 STILL NOT HOOKEED TO HOUSE BLDG HOUSE STARTED

WATER WELL NOT INSTALLED COVER TANK & R.W. RH

DATE SYSTEM APPROVED _____ INSPECTOR _____