

PUB. SEWER STATUS VERIFIED BY \_\_\_\_\_

ISSUE DATE: 10/4/05

P 523423

APPROVAL DATE: 11/2/05

A 519063-D (REPAIR)

# PERMIT INDEXED

Tax ID # 04-313844

## ON-SITE SEWAGE DISPOSAL SYSTEM HOWARD COUNTY HEALTH DEPARTMENT BUREAU OF ENVIRONMENTAL HEALTH

Dun-Rite Septic Tank Service IS PERMITTED TO INSTALL  ALTER

ADDRESS: 15300 Parrish Road, Upperco, MD 21155 PHONE NUMBER: 410-461-3255

SUBDIVISION: Nursery View LOT NUMBER: 6

ADDRESS: 17316 Old Frederick Road PROPERTY OWNER: Patricia Spilman

SEPTIC TANK CAPACITY (GALLONS): Existing 3' Wide

PUMP CHAMBER CAPACITY (GALLONS): N/A Inlet 4.5'

NUMBER OF BEDROOMS: 5 Bottom 6.5'

SQUARE FEET PER BEDROOM: 240 2' Stone Below Pipe

LINEAR FEET OF TRENCH REQUIRED: 248 3 Trenches

TRENCHES:	Trench to be _____ feet wide. Inlet _____ feet below original grade. Bottom maximum depth _____ feet below original grade. Effective area begins at _____ feet below original grade. _____ feet of stone below distribution pipe.
LOCATION:	
PURPOSE:	Existing septic system has failed. Call for inspection when ground is opened so sanitarian can recommend repair.


PLANS APPROVED: \_\_\_\_\_ DATE: \_\_\_\_\_

- NOTE: PERMIT VOID AFTER 2 YEARS
- NOTE: CONTRACTOR RESPONSIBLE FOR SCHEDULING A PRE-CONSTRUCTION INSPECTION FOR ALL INSTALLATIONS
- NOTE: WATERTIGHT SEPTIC TANKS REQUIRED
- NOTE: ALL PARTS OF SEPTIC SYSTEM SHALL BE 100 FEET FROM ANY WATER WELL
- NOTE: MANHOLE RISERS REQUIRED ON ALL SEPTIC TANKS AND PUMP CHAMBERS

**NEITHER THE HOWARD COUNTY COUNCIL OR THE HEALTH DEPARTMENT IS RESPONSIBLE FOR THE SUCCESSFUL OPERATION OF ANY SYSTEM PERMITTEE RESPONSIBLE FOR OBTAINING FINAL APPROVAL ON THIS PERMIT CALL 410-313-2640 FOR INSPECTION OF SEPTIC SYSTEM**

A519063-D

NOT TO SCALE

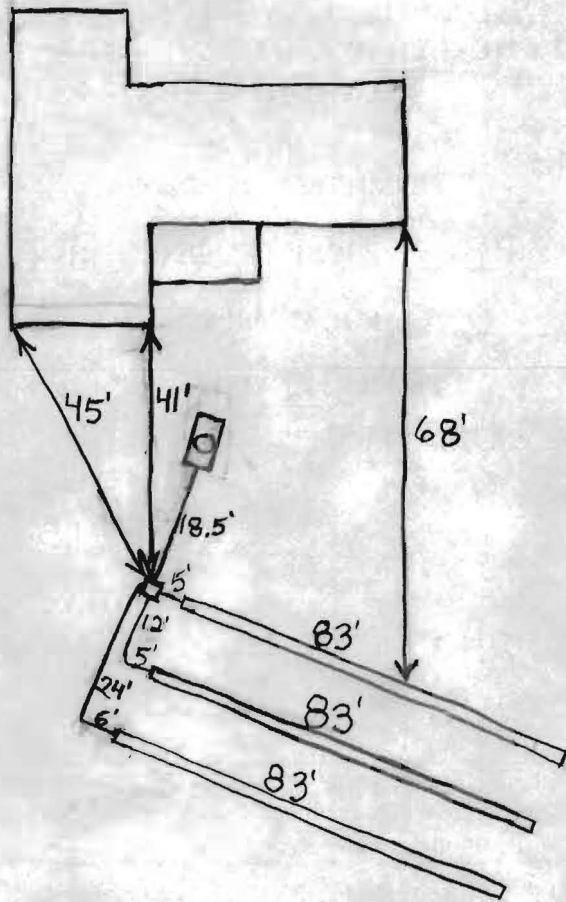

TRENCH/DRAINFIELD DATA		
WIDTH	INLET	BOTTOM
3'	4.5-6'	6.5-8'
NUMBER OF TRENCHES		3
TOTAL LENGTH		249
ABSORPTION AREA		747 + Sidewalk
DISTRIBUTION BOX LEVEL		Levelers
DISTRIBUTION BOX BAFFLE		Yes
DISTRIBUTION BOX PORT		No

SEPTIC TANK DATA	
SEPTIC TANK 1 LEVEL	
CAPACITY	_____ GAL
SEAM LOC	Midseam
TANK LID DEPTH	2.5'
BAFFLES	Rear
BAFFLE FILTER	No
MANHOLE LOC	Middle
6" PORT LOC	None
WATERTIGHT TEST	
SEPTIC TANK 2 LEVEL N/A	
CAPACITY	_____ GAL
SEAM LOC	_____
TANK LID DEPTH	_____
BAFFLES	_____
BAFFLE FILTER	_____
MANHOLE LOC	_____
6" PORT LOC	_____
WATERTIGHT TEST	

PRE-CONSTRUCTION 10/18/05 Install 3 trenches. Start the top trench ~ 10'-15' downhill of the swimming pool. Stay 100' from the homeowner's well and the neighbors well. Stay uphill of the 2 existing trenches. (BB)

INSTALLATION 11/1/05 Top 2 trenches done and installed off contour. Ends of trenches 1.5' too deep. Told installer to keep bottom trench on contour. (BB) 11/2/05 Third trench installed on contour at correct depth. (BB)


FINAL INSPECTOR B. Baper DATE OF APPROVAL 11/2/05

CONSUMER INFORMATION NOTES:

1. This plan is a benefit to a consumer insofar as it is required by a lender or a title insurance company or its agent in connection with contemplated transfer, financing or re-financing.
2. This plan is not to be relied upon for the establishment or location of fences, garages, buildings, or other existing or future improvements.
3. This plan does not provide for the accurate identification of property boundary lines, but such identification may not be required for the transfer of title or securing financing or re-financing.
4. Building line and/or Flood Zone information is taken from available sources and is subject to interpretation of originator.

Notes


1. Flood zone "C" per H.U.D. panel No. 240044-0006B
2. Setback distances as shown to the principal structure from property lines are approximate. The level of accuracy for this drawing should be taken to be no greater than plus or minus 2 Feet.

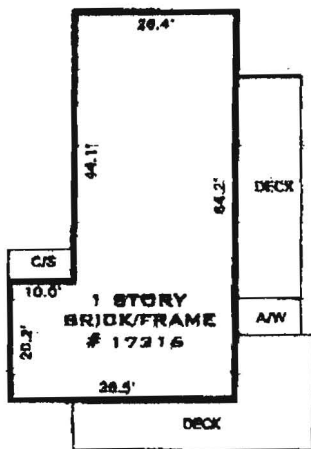

DETAIL

SCALE: 1" = 30'

OLD FREDERICK ROAD

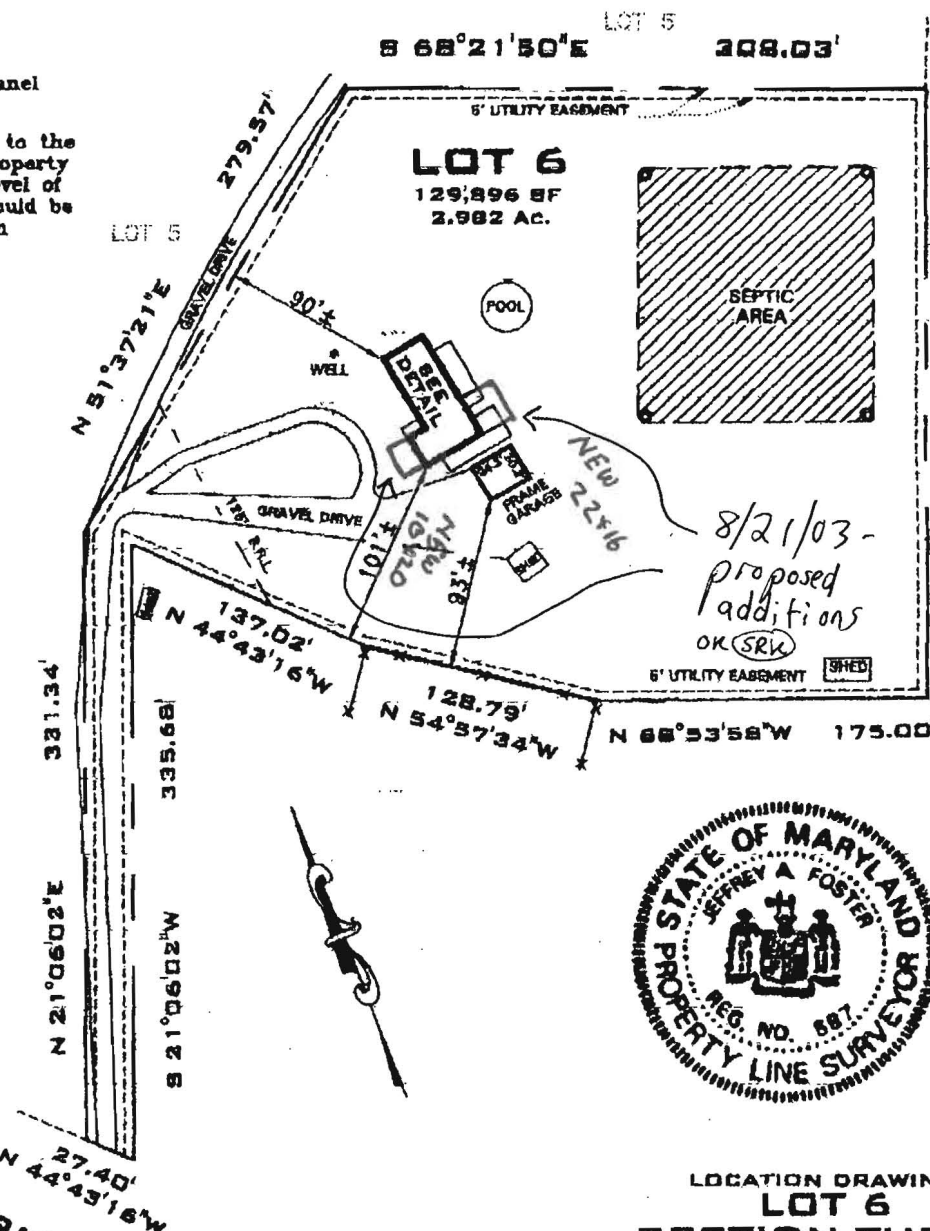

LOCATION DRAWING  
**LOT 6**  
**SECTION THREE**  
**NURSERY VIEW**  
 HOWARD COUNTY, MARYLAND

SURVEYOR'S CERTIFICATE

"THE INFORMATION SHOWN HEREON HAS BEEN BASED UPON THE RESULTS OF A FIELD INSPECTION PURSUANT TO THE DEED OR PLAT OF RECORD. EXISTING STRUCTURES SHOWN HAVE BEEN FIELD LOCATED BASED UPON MEASUREMENTS FROM PROPERTY MARKERS FOUND OR FROM EVIDENCE OF LINES OF APPARENT OCCUPATION."

*Jeffrey A. Foster*  
 MARYLAND PROPERTY LINE SURVEYOR REG. NO. 587

REFERENCES

PLAT BK. 27  
 PLAT NO. 39

LIBER  
 FOLIO



**SNIDER & ASSOCIATES**  
 SURVEYORS - ENGINEERS  
 LAND PLANNING CONSULTANTS  
 2 Professional Drive, Suite 216  
 Gaithersburg, Maryland 20879  
 301/948-5100, Fax 301/948-1286

DATE OF LOCATIONS	SCALE: 1"=100'
WALL CHECK:	DRAWN BY: F.A.
HSE. LOC.: 08-08-2000	JOB NO.: 2000-8357

PUB. SEWER STATUS VERIFIED BY \_\_\_\_\_

ISSUE DATE: \_\_\_\_\_

APPROVAL DATE: \_\_\_\_\_

**PERMIT**  
**INDEXED**

P Re-indexed

A 519063-D

**ON-SITE SEWAGE DISPOSAL SYSTEM**  
**HOWARD COUNTY HEALTH DEPARTMENT**  
**BUREAU OF ENVIRONMENTAL HEALTH**

**04-313844**

IS PERMITTED TO INSTALL  ALTER

ADDRESS: \_\_\_\_\_ PHONE NUMBER: \_\_\_\_\_

SUBDIVISION: Nursery View LOT NUMBER: 6

ADDRESS: 17316 Old Frederick Road PROPERTY OWNER: Patricia Spilman

SEPTIC TANK CAPACITY (GALLONS): \_\_\_\_\_

PUMP CHAMBER CAPACITY (GALLONS): \_\_\_\_\_

NUMBER OF BEDROOMS: \_\_\_\_\_

SQUARE FEET PER BEDROOM: \_\_\_\_\_

LINEAR FEET OF TRENCH REQUIRED: \_\_\_\_\_

TRENCHES:	Trench to be _____ feet wide. Inlet _____ feet below original grade. Bottom maximum depth _____ feet below original grade. Effective area begins at _____ feet below original grade. _____ feet of stone below distribution pipe.
LOCATION:	
PURPOSE:	File re-indexed

PLANS APPROVED: \_\_\_\_\_ DATE: \_\_\_\_\_

- NOTE: PERMIT VOID AFTER 2 YEARS
- NOTE: CONTRACTOR RESPONSIBLE FOR SCHEDULING A PRE-CONSTRUCTION INSPECTION FOR ALL INSTALLATIONS
- NOTE: WATERTIGHT SEPTIC TANKS REQUIRED
- NOTE: ALL PARTS OF SEPTIC SYSTEM SHALL BE 100 FEET FROM ANY WATER WELL
- NOTE: MANHOLE RISERS REQUIRED ON ALL SEPTIC TANKS AND PUMP CHAMBERS

**NEITHER THE HOWARD COUNTY COUNCIL NOR THE HEALTH DEPARTMENT IS RESPONSIBLE FOR THE SUCCESSFUL OPERATION OF ANY SYSTEM PERMITTEE RESPONSIBLE FOR OBTAINING FINAL APPROVAL ON THIS PERMIT CALL 410-313-2640 FOR INSPECTION OF SEPTIC SYSTEM**

A 519063-D