

2349

SEQUENCE NO. (MDE USE ONLY)

STATE OF MARYLAND APPLICATION FOR PERMIT TO DRILL WELL please type

STATE PERMIT NUMBER

HO-94-4508 fill in this form completely

Date Received (APA) 11-23-04

OWNER INFORMATION

Thompson DACE BLD 6300 WOODSIDE CT Columbia MD 21046


LOCATION OF WELL

Howard COUNTY 21 Pindell Woods 23 SUBDIVISION Preservation Parcel E. SECTION 44 46 LOT 48 50 SIMPSONVILLE 52 NEAREST TOWN 71 MILES FROM TOWN 3

DRILLER INFORMATION

Ralph E MAYNE MSD 117 Driller's Name 76 License No. 81 RALPH E. MAYNE INC Firm Name 17024 Hardy Rd. Mt Airy Md. 21071 Address Signature Date 11-7-04

DIRECTION OF WELL FROM TOWN (CIRCLE BOX)

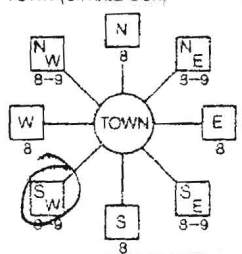

NEAR WHAT ROAD

ON WHICH SIDE OF ROAD (CIRCLE APPROPRIATE BOX) NORTH WEST EAST SOUTH DISTANCE FROM ROAD 396 ENTER FT OR MI TAX MAP 41 BLK 8 PARCEL E

WELL INFORMATION APPROX. PUMPING RATE 80 (GAL. PER MIN.) AVERAGE DAILY QUANTITY NEEDED 30 (GAL PER DAY)

USE FOR WATER (CIRCLE APPROPRIATE BOX)

- DOMESTIC POTABLE SUPPLY & RESIDENTIAL IRRIGATION FARMING (LIVESTOCK WATERING & AGRICULTURAL IRRIGATION INDUSTRIAL, COMMERCIAL, DEWATERING PUBLIC WATER SUPPLY WELL TEST OBSERVATION MONITORING GEO-THERMAL

NOT TO BE FILLED IN BY DRILLER HEALTH DEPARTMENT APPROVAL

Howard W 11059-02 COUNTY NAME COUNTY NO. STATE SIGNATURE DATE ISSUED 11/29/04 TO Nufan 11/29/05 EXP. DATE NORTH GRID 487 000 EAST GRID 0323 000

APPROXIMATE DEPTH OF WELL 60 FEET APPROXIMATE DIAMETER OF WELL 6 INCH NEAREST TOWN

METHOD OF DRILLING (circle one)

BORED (or Augered) JETTED Jetted & DRIVEN AIR-ROTARY AIR-PERCussion ROTARY (Hydraulic Rotary) CABLE REVERSE-ROTARY Drive-POINT

REPLACEMENT OR DEEPEMED WELLS (CIRCLE APPROPRIATE BOX)

- THIS WELL WILL NOT REPLACE AN EXISTING WELL THIS WELL WILL REPLACE A WELL THAT WILL BE ABANDONED AND SEALED THIS WELL WILL REPLACE A WELL THAT WILL BE USED AS A STANDBY CONTACT LOCAL APPROVING AUTHORITY FOR POLICY ON STANDBY WELLS THIS WELL WILL DEEPEM AN EXISTING WELL

PERMIT NUMBER OF WELL TO BE REPLACED OR DEEPEMED (IF AVAILABLE)

Not to be filled in by driller (MDE OR COUNTY USE ONLY)

APPROX PERMIT NUMBER G PERMIT NO. HO-94-4508


SHOW MAJOR FEATURES OF BOX & LOCATE WELL WITH AN X

SOURCES OF DRILLING WATER

WRITE THE BOX NUMBER FROM THE MAP HERE

E 4500823 N 820487

DRAW A SKETCH BELOW SHOWING LOCATION OF WELL IN RELATION TO NEARBY TOWNS AND ROADS AND GIVE DISTANCE FROM WELL TO NEAREST ROAD JUNCTION

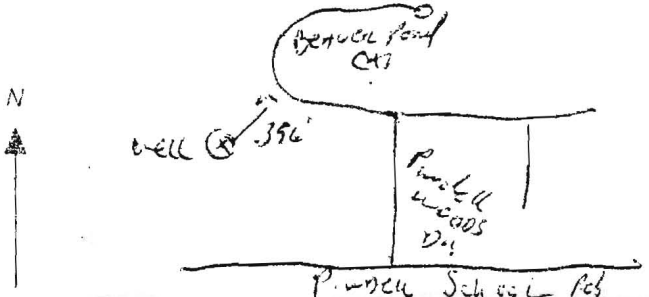

SPECIAL CONDITIONS