

NO FEE PAID RE-ESTABLISH OLD PERC

# APPLICATION

## PERCOLATION TESTING

NO FEE PAID

A 519071

P \_\_\_\_\_

HOWARD COUNTY HEALTH DEPARTMENT  
BUREAU OF ENVIRONMENTAL HEALTH  
3525-H ELLICOTT MILLS DRIVE/ELLICOTT CITY, MARYLAND 21043  
TELEPHONE: 313-2640

DISTRICT \_\_\_\_\_

DATE 7/30/2003

TO: THE COUNTY HEALTH OFFICER  
ELLICOTT CITY, MARYLAND

I HEREBY APPLY FOR THE NECESSARY TEST PRIOR TO APPLICATION FOR PERMIT TO CONSTRUCT (OR RECONSTRUCT) A SEWAGE DISPOSAL SYSTEM.

PROPERTY OWNER HOWARD S. KRIEGER  
40 LINDA POCHOD  
ADDRESS 2938 JESSUP ROAD PHONE 410 799-0315  
JESSUP MD 20794

AGENT OR PROSPECTIVE BUYER BRUCE JAFFE  
ADDRESS 11628 LOG JUMP TRAIL PHONE 301 596-0222  
ELLICOTT CITY MD 21042

PROPERTY LOCATION:  
SUBDIVISION CLARKSVILLE OVERLOOK 3461 LOT NO. 2  
RECORDED IN 1976 PLAT # 6992

ROAD AND DESCRIPTION 12900 BRIGHTON DAM ROAD  
12840  
\*REESTABLISH SEWAGE AREA

TAX MAP 34 PARCEL # 362

SIZE OF LOT 1.81 AC TYPE BLDG. SFD  
(SINGLE FAMILY DWELLING OR COMMERCIAL)

THE SYSTEM INSTALLED UNDER THIS APPLICATION IS ACCEPTABLE ONLY UNTIL PUBLIC FACILITIES BECOME AVAILABLE. I FULLY UNDERSTAND THE FEE CONNECTED WITH THE FILING OF THIS PERC TEST APPLICATION IS NON-REFUNDABLE UNDER ANY CIRCUMSTANCES. I ALSO AGREE TO COMPLY WITH ALL M.O.S.H.A. REQUIREMENTS IN TESTING THIS LOT. [Signature]  
(SIGNATURE OF APPLICANT)

APPROVED BY \_\_\_\_\_ FOR \_\_\_\_\_ DATE \_\_\_\_\_

DISAPPROVED BY \_\_\_\_\_ FOR \_\_\_\_\_ DATE \_\_\_\_\_

HOLD PENDING FURTHER TESTS \_\_\_\_\_

REASONS FOR REJECTION OR HOLDING \_\_\_\_\_

PERCOLATION TEST PLAT/PRELIMINARY PLAT - TITLE OR I.D. # \_\_\_\_\_ DATE \_\_\_\_\_

SITE DEVELOPMENT PLAN/FINAL PLAT - TITLE OR I.D. # \_\_\_\_\_ DATE \_\_\_\_\_

# THIS IS NOT A PERMIT

COUNTY #


SOIL PROFILE

0' 6100  
 Brown Loam 1'  
 Yellow Clay Loam 3'  
 Red Clay 1/2' 30-40% Heavy Quartz  
 Yellow Yellow Brown Siloam 7'  
 HARD QUARTZ 1 1/2'

6103  
 Brown Loam 8"  
 Yellow Clay Loam  
 Red Clay Loam 1 1/2'

6104  
 Brown Loam 1 1/2'  
 Red Clay Loam 6 1/2'

6101  
 Brown Siloam  
 Siloam 13'

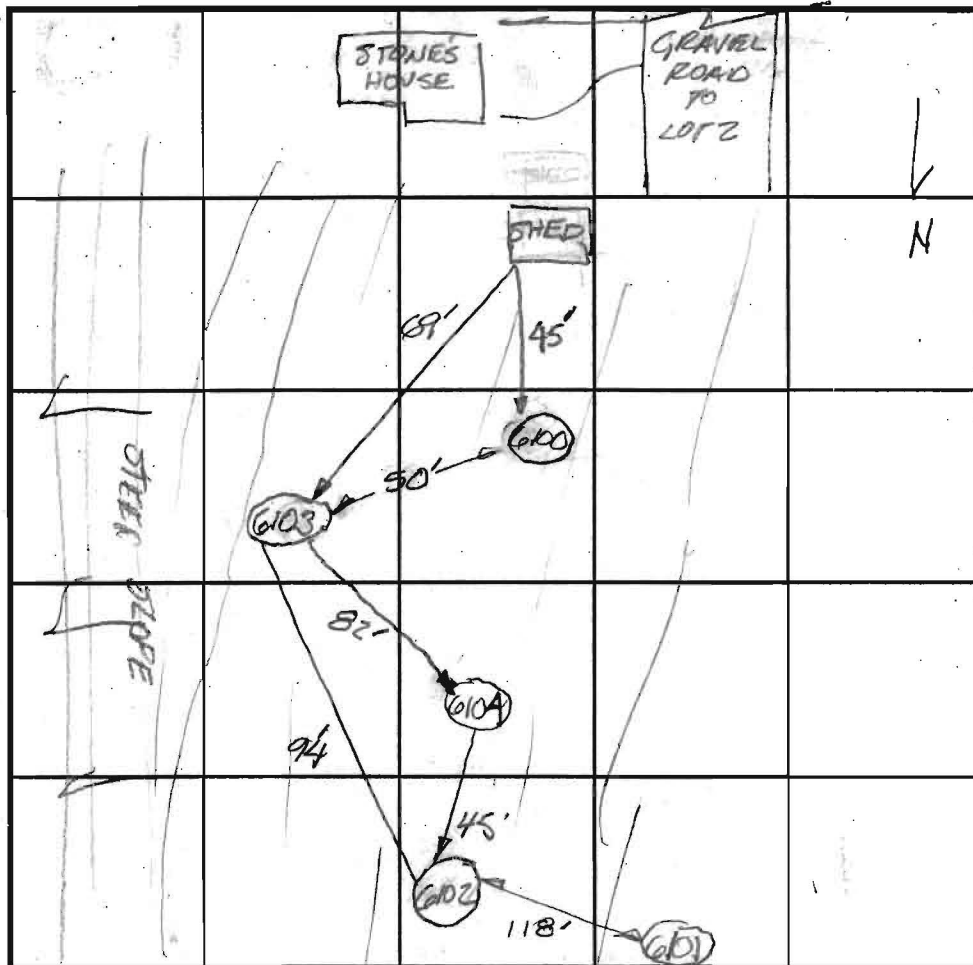

SOIL PROFILE

0' 6102  
 Brown Loam 1'  
 Yellow Clay Loam 5'  
 Yellow Brown Siloam 15'  
 L590 Cobble Quartz

6101  
 Brown Loam 1'  
 Yellow Clay Loam 6'  
 Yellow Brown Siloam 13'

INDICATE NORTH - NAME ADJOINING ROADWAY AS BASE LINE.

DATE	TEST NO.	DEPTH	PRE-WET		TEST - 1" DROP		TIME
			START	STOP	START	STOP	
10/16/03	6100	7' / 11'	9:53	10:00	10:00	10:17	17min
	6103	7' / 12'	11:03	11:05	11:05	11:08	2min
	6104	7' / 13'	11:33	11:37	11:37	11:44	7min
	6102	Visual OK					
	6101	Visual OK					

REMARKS \*Bottom of trench no shallower than 7'  
 TYPE OF SOIL \_\_\_\_\_  
 TESTED BY F ALFONSO ALSO PRESENT JIM KNISLEY / BACKHOE  
WALT HAMMOND  
BOTTIE JARRISON  
 TRENCH DESIGN DATA: AVERAGE PERCOLATION TIME 9min TRENCH WIDTH 3  
 INLET DEPTH 4' MAXIMUM BOTTOM DEPTH 7' SQ. FT./BEDROOM 210