

Partial inspection

PERMIT

P. 1254
A. 1012

SEWAGE DISPOSAL SYSTEM

MARYLAND STATE DEPARTMENT OF HEALTH

HOWARD COUNTY

ELLIOTT CITY

INDEXED

DISTRICT 5

DATE 1/30/66

Wilson Construction Co. IS PERMITTED TO INSTALL E ALTER

RESS. 563 Chapel Avenue, Elliott City, Md. PHONE ED 5-2225

WAGE DISPOSAL SYSTEM LOCATED AT _____

DIVISION Storm Drain ROAD Evergreen Way LOT 10 BL. A

PROPERTY OWNER Corvill, Inc.

ADDRESS _____

REQUIREMENTS = 4 bedrooms

DRAIN FIELD _____ DEPTH _____ FEET, BOTTOM AREA _____ SQ. FT.

SEEPAGE PITS _____ ABSORBENT SIDE-WALL AREA _____ SQ. FT.

SEPTIC TANK CAPACITY 1000 GALLONS

FOR GARBAGE GRINDER, INCREASE DISPOSAL AREA 50% & TANK CAPACITY 50%.


OTHER dry well - 112 sq. ft. absorbent sidewall area below inlet pipe
per bedroom. Inlet pipe to be no deeper than 4 ft. below original grade.
Locate dry well 115 ft. from back lot line and 17 ft. from right side line
as lot is seen when facing it from Evergreen Way.

PERMIT APPROVED BY E. Fletcher DATE 9/16/65

1. SEPTIC TANK AND DISTRIBUTION BOX WITH WATER BEFORE CALLING FOR AN INSPECTION. COVER NO WORK UNTIL INSPECTED AND APPROVED.

NEITHER THE HOWARD COUNTY COMMISSIONERS NOR THE HEALTH DEPARTMENT IS RESPONSIBLE FOR THE SUCCESSFUL OPERATION OF ANY SYSTEM.

A 10412

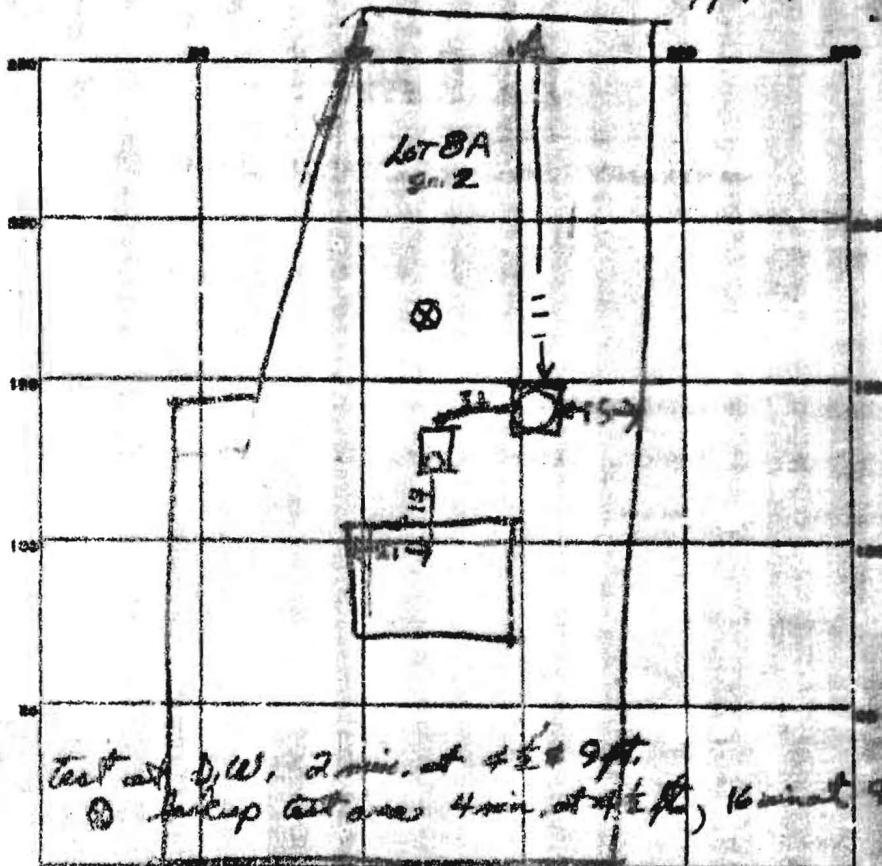

37
3
(1)

6/29/65 Test at D.W. 2 min. at 4 1/2 ft.
 (X) Backup test area 4 min. at 4 1/2 ft., 16 min. at 9 ft. R.D.F.

INDICATE NORTH - BASE LINGUISTIC ROADWAY TO BEAN LINE
 EVERGREEN VALLEY

PERMIT CARD _____

SEPTIC TANK LEVEL OK _____

DISTRIBUTION BOX LEVEL _____

PILE FIELD, DEPTH _____ FT. TRENCH WIDTH _____ FT.

GRAVEL DEPTH _____ IN. TOTAL LENGTH _____ FT.

NUMBER OF TRENCHES _____ TOTAL BOTTOM AREA _____

SEEPAGE PITS, INSIDE DIAMETER 12 FT. DEPTH BELOW INLET 10 FT.

ABSORBENT AREA 600 sq. ft. Counting stone

REMARKS 7/7/66 3:15 PM BH - Dry Well in at 4 1/2 FT
below grade Perimeter of Dry Well = 60 FT
10x60 = 600 sq ft. and well was constructed
the water will jet.

DATE SYSTEM APPROVED 7/11/66 INSPECTOR The. man. the.