

8/26/03 2pm F/u / Final

PUB. SEWER STATUS VERIFIED BY \_\_\_\_\_

ISSUE DATE:

P 519080

APPROVAL DATE:

8/26/03

**PERMIT  
INDEXED**

A REPAIR

**ON-SITE SEWAGE DISPOSAL SYSTEM  
HOWARD COUNTY HEALTH DEPARTMENT  
BUREAU OF ENVIRONMENTAL HEALTH**

**05-414539**

Hatfields

IS PERMITTED TO INSTALL  ALTER

ADDRESS: \_\_\_\_\_ PHONE NUMBER: 410-531-6773

SUBDIVISION: The Woods LOT NUMBER: 1

ADDRESS: 13782 Brighton Dam Road PROPERTY OWNER: Keith Ives

SEPTIC TANK CAPACITY (GALLONS): Ex. 750 & existing dry well

PUMP CHAMBER CAPACITY (GALLONS): N/A

NUMBER OF BEDROOMS: 3

SQUARE FEET PER BEDROOM: 180

LINEAR FEET OF TRENCH REQUIRED: 180

TRENCHES:	Trench to be 3.0 feet wide. Inlet <sup>4'</sup> feet below original grade. Bottom maximum depth 6.0 feet below original grade. Effective area begins at 4.0 feet below original grade. 2.0 feet of stone below distribution pipe.
LOCATION:	Maintain dry well for additional storage and effluent settling. Run a dist. Box and two- 90' long trenches on contour 12'etc. Check integrity of baffles in septic tank and also septic line from house to s.t., and s.t. to dry well.
PURPOSE:	Septic system has failed. Call for inspection when the ground is opened so sanitarian can recommend repair.

PLANS APPROVED: KN DATE: 8/13/03

- NOTE: PERMIT VOID AFTER 2 YEARS
- NOTE: CONTRACTOR RESPONSIBLE FOR SCHEDULING A PRE-CONSTRUCTION INSPECTION FOR ALL INSTALLATIONS
- NOTE: WATERTIGHT SEPTIC TANKS REQUIRED
- NOTE: ALL PARTS OF SEPTIC SYSTEM SHALL BE 100 FEET FROM ANY WATER WELL
- NOTE: MANHOLE RISERS REQUIRED ON ALL SEPTIC TANKS AND PUMP CHAMBERS

**NEITHER THE HOWARD COUNTY COUNCIL NOR THE HEALTH DEPARTMENT IS RESPONSIBLE FOR THE SUCCESSFUL OPERATION OF ANY SYSTEM PERMITTEE RESPONSIBLE FOR OBTAINING FINAL APPROVAL ON THIS PERMIT**


**CALL 410-313-2640 FOR INSPECTION OF SEPTIC SYSTEM**

**BUILDING PERMIT SIGNED AND RETURNED**

8-13-03 800142 807- Rm Addition + Sun Room

PS 19080

NOT TO SCALE

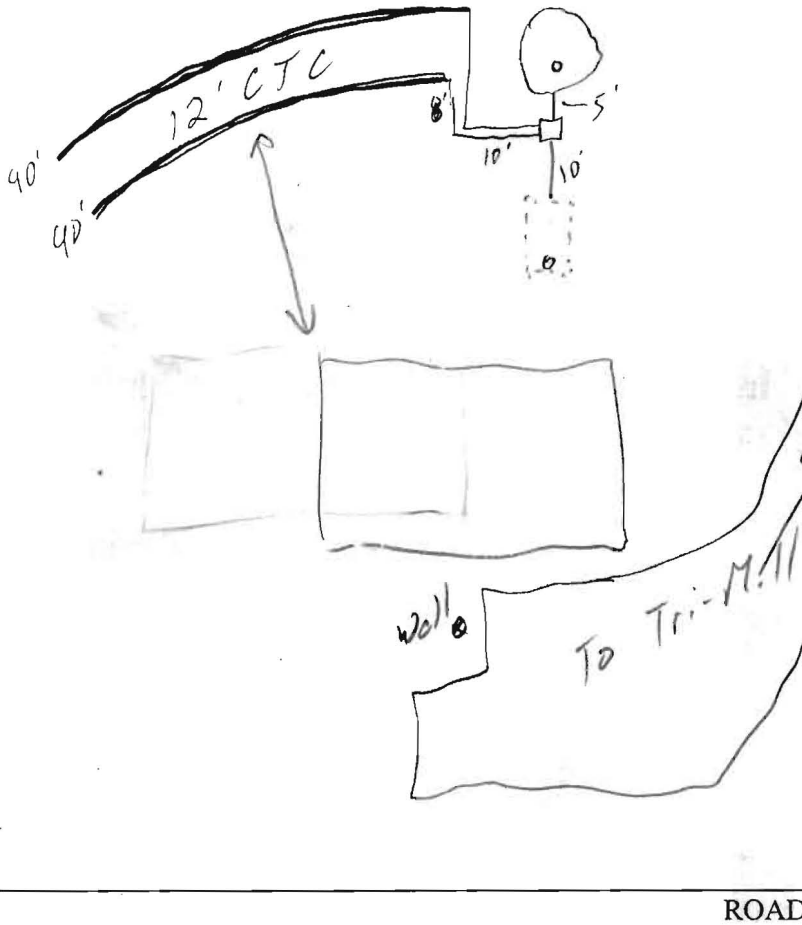

TRENCH/DRAINFIELD DATA		
WIDTH	INLET	BOTTOM
3'	4'	6'
NUMBER OF TRENCHES		2
TOTAL LENGTH		180'
ABSORPTION AREA		540 <sup>sq</sup>
DISTRIBUTION BOX LEVEL		<input checked="" type="checkbox"/>
DISTRIBUTION BOX BAFFLE		<input checked="" type="checkbox"/>
DISTRIBUTION BOX PORT		NA

SEPTIC TANK DATA	
SEPTIC TANK 1 LEVEL	existing
CAPACITY	Ex 750 GAL
SEAM LOC	MID
TANK LID DEPTH	1'
BAFFLES	OK
BAFFLE FILTER	NA
MANHOLE LOC	No
6" PORT LOC	Front
WATERTIGHT TEST	NA
SEPTIC TANK 2 LEVEL	
CAPACITY	_____ GAL
SEAM LOC	_____
TANK LID DEPTH	_____
BAFFLES	NA
BAFFLE FILTER	_____
MANHOLE LOC	_____
6" PORT LOC	_____
WATERTIGHT TEST	_____

PRE-CONSTRUCTION See prev notes

INSTALLATION 8/26/03 - OK to cover all work (50)


FINAL INSPECTOR [Signature]

DATE OF APPROVAL 8/26/03

BUILDING PERMIT SIGNED AND RETURNED

*Penny E. Borenstein, M.D., M.P.H., Health Officer*

**F A X**

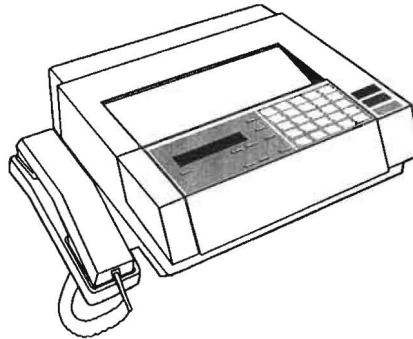

SENT  
WATER  
SAMPLE  
LIST

Date 10/15/02  
To TIM  
Department \_\_\_\_\_  
FAX # 410-691-6771

From KC  
Telephone 410-313-2669 FAX (410) 313-2648  
# Of Pages 2 (including cover page)

Comments Greg Mellon informed me that a septic contractor needs to inspect the system. Our records indicate the initial system is currently being used - installed in early 60s.  
\* recommend repair. (KN)

**CONFIDENTIALITY NOTICE**  
"WARNING: UNAUTHORIZED INTERCEPTION OF THIS TELEPHONIC COMMUNICATION COULD BE A VIOLATION OF FEDERAL AND MARYLAND LAW"  
The documents accompanying this telecopy transmission contain confidential information belonging to the sender which is legally privileged. The information is intended only for the use of the individual or entity named above. If you are not the intended recipient, you are hereby notified that any discourse, copying, distribution or the taking of any action in reliance on the contents of this telephonic information is strictly prohibited. If you have received this telecopy in error, please immediately notify sender by telephone to arrange for return of the original documents to us.