

8/10/60
15

APPLICATION

A.C. 2815

P. 1914

SEWAGE DISPOSAL TESTING

MARYLAND STATE DEPARTMENT OF HEALTH

HOWARD COUNTY

ELLICOTT CITY

DISTRICT 5th

one 9 ft dia x 12 ft dry well below the inlet. Test dry well 40 ft behind the garage in front tented. 75 gal of test tank. DATE 8/10/60

TO: THE COUNTY HEALTH OFFICER
ELLICOTT CITY, MARYLAND

I, HEREBY, APPLY FOR THE NECESSARY TESTS IN ORDER TO CONSTRUCT (OR RECONSTRUCT) A SEWAGE DISPOSAL SYSTEM.

PROPERTY OWNER Francis E. Ellis

ADDRESS 14505 Hilpin Rd. Silver Spring PHONE MA 2 0212
c/o Edwin M. Wilkerson

PROPERTY LOCATION:

SUBDIVISION _____ LOT NO. _____

ROAD AND DESCRIPTION Brighton Dam Rd. - 100 yds. past intersection
(Wilson Home on right) of Harding Mill Rd. on right side

OCCUPANT Same PHONE _____

PERSON TO CONSTRUCT SYSTEM Claude G. Gault

ADDRESS _____ PHONE _____

SIZE OF LOT 23A TYPE BLDG. res. 13
NUMBER OF ROOMS _____

IF NOT SINGLE RESIDENCE DESCRIBE _____

✓ SIGNATURE OF APPLICANT Edwin M. Wilkerson


APPROVED BY J. Herzig FOR Dry Well DATE 8-11-60
(KIND OF SYSTEM)

REJECTED BY _____ FOR _____ DATE _____
(KIND OF SYSTEM)

HOLD PENDING FURTHER TESTS _____ DATE _____

REASONS FOR REJECTION OR HOLDING _____

THIS IS NOT A PERMIT

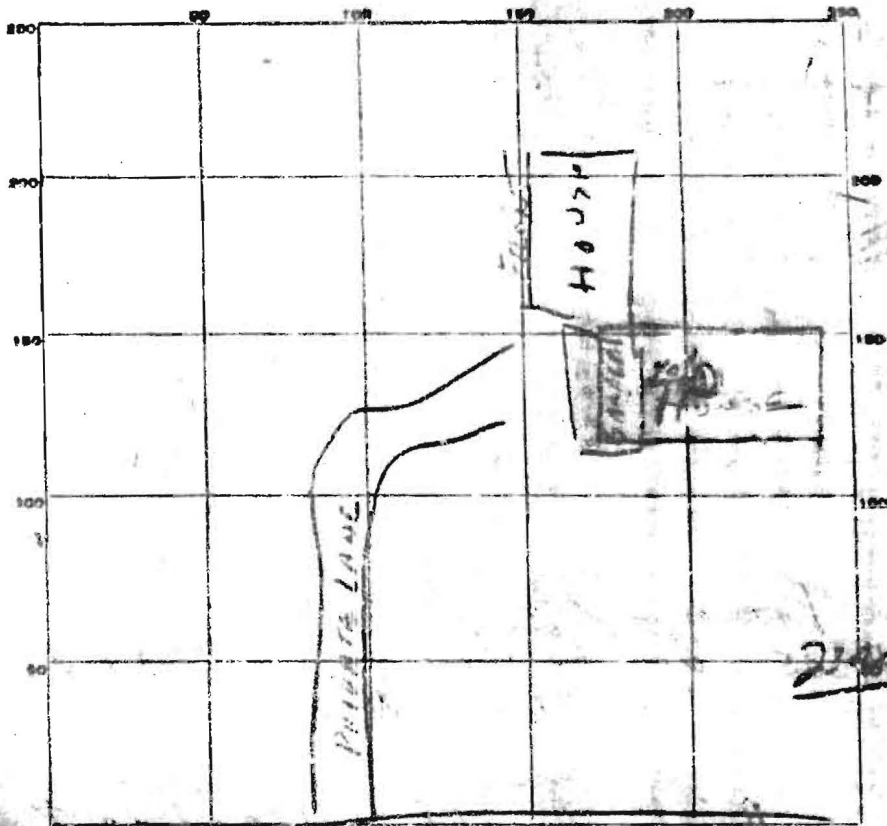

INDICATE NORTH - MAIN ADJOINING ROADWAY - SEE LINE

13 HUNTER DRIVE RD

DATE	TEST NO.	DEPTH	PRE-WET		TEST - 1" DROP		TIME
			START	STOP	START	STOP	
8-11-60	1	8'6"	1:14	1:17	1:17	1:22	5 minutes

SOIL AUGER FINDING

TESTED BY

REMARKS

ALSO PRESENT

J. H. ...
8-11-60
Edwin G. Walker
 LOT NO.