

# APPLICATION

PERCOLATION TESTING

A 46478

P \_\_\_\_\_

HOWARD COUNTY HEALTH DEPARTMENT  
BUREAU OF ENVIRONMENTAL HEALTH  
P.O. BOX 476 ELLICOTT CITY, MARYLAND 21043  
TELEPHONE 461-9933

DISTRICT 5

DATE 10-10-90

TO: THE COUNTY HEALTH OFFICER  
ELLICOTT CITY, MARYLAND

I, HEREBY, APPLY FOR THE NECESSARY TEST IN ORDER TO CONSTRUCT (OR RECONSTRUCT) A SEWAGE DISPOSAL SYSTEM.

PROPERTY OWNER Francis Ehlers Estate

ADDRESS \_\_\_\_\_ PHONE \_\_\_\_\_

PROSPECTIVE BUYER Richard J. Bernmitt

ADDRESS P.O. Box 208 Clarksville MD 21029 PHONE 531-5539

PROPERTY LOCATION:

SUBDIVISION Ehlers Property LOT NO. 4

ROAD AND DESCRIPTION Brighton Way Road & Nichols Drive

TAX MAP 34 PARCEL # 50

SIZE OF LOT 1.0 ACRES TYPE BLDG. Existing House  
(SINGLE FAMILY DWELLING OR COMMERCIAL)

THE SYSTEM INSTALLED UNDER THIS APPLICATION IS ACCEPTABLE ONLY UNTIL PUBLIC FACILITIES BECOME AVAILABLE. I FULLY UNDERSTAND THE

FEE CONNECTED WITH THE FILING OF THIS PERC TEST APPLICATION IS NON-REFUNDABLE UNDER ANY CIRCUMSTANCES. I ALSO AGREE TO COMPLY

WITH ALL M.O.S.H.A. REQUIREMENTS IN TESTING THIS LOT. Richard J. Bernmitt  
(SIGNATURE OF APPLICANT)

APPROVED BY \_\_\_\_\_ FOR \_\_\_\_\_ DATE \_\_\_\_\_

REJECTED BY \_\_\_\_\_ FOR \_\_\_\_\_ DATE \_\_\_\_\_

HOLD PENDING FURTHER TESTS \_\_\_\_\_ DATE \_\_\_\_\_

REASONS FOR REJECTION OR HOLDING 10/29/90 PERC OK HOLD FOR PERC  
CERT PLAT

HD-216

# THIS IS NOT A PERMIT

Lot 4  
A 46478


SOIL PROFILE  
A

0  
3  
BROWN CLAY  
BEIGE POWDERY SAND LOAM

14

B

0  
1  
TOPSOIL  
BEIGE BWDERT SAND LOAM

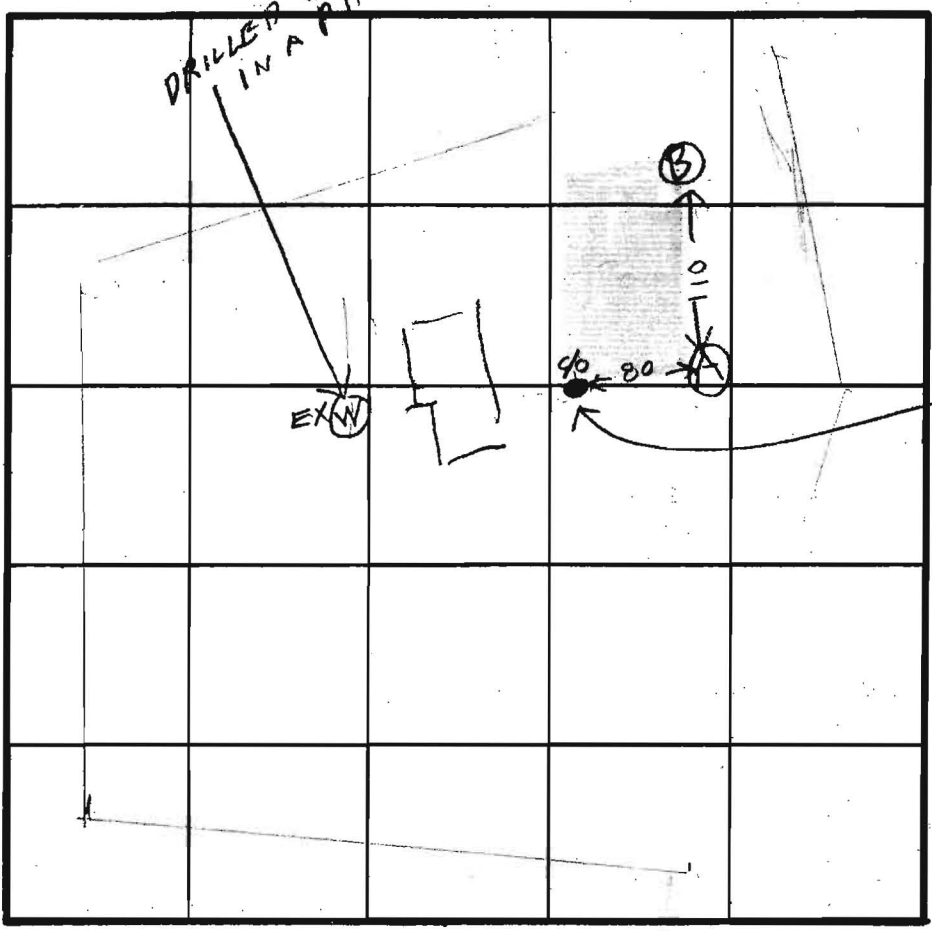

INDICATE NORTH - NAME ADJOINING ROADWAY AS BASE LINE.

DATE	TEST NO.	DEPTH	PRE-WET		TEST - 1" DROP		TIME
			START	STOP	START	STOP	
10/26/90	AV	14	OK				
	BV	14	OK				

REMARKS SEE TEST PLAT #1

TYPE OF SOIL \_\_\_\_\_

TESTED BY R. HODGES ALSO PRESENT R. PIERCE

LYLES  
L. 158 F. 186

E 802000  
N 497000

ST
TING
58.5121
37.7576
15.7427
26.7069
55.3792
32.3920
32.6016
24.5784
76.4782

R.E. LYLES  
L. 368 F. 421

LOT 2  
3.2872 ACRES

LOT 1  
3.0000 ACRES

VEHICULAR INGRESS & EGRESS  
IS RESTRICTED

BRIGHTON DAM ROAD  
(80' R/W)

LAND DEDICATED TO  
HOWARD COUNTY, MD.  
THE PURPOSE OF A  
ROAD (17641)

RELATION

BE RECORDED: 3  
9.7517 ACRES  
0.4049 ACRES  
10.1566 ACRES

ATER AND PRIVATE  
COUNTY, HEALTH

6-21-91  
DATE

DEPARTMENT OF

7/11/91  
DATE

WATER AND SEWERAGE SYSTEMS AND  
DEPARTMENT OF

OWNERS CERTIFICATE

Highland Development Corp., by Richard J. Demmitt, President, owner, of the property shown and described hereon, hereby adopt this plan of subdivision, and in consideration of the approval of this final plan by the Department of Planning and Zoning, establish minimum building restriction lines and grant unto Howard County Maryland. Its successors and assigns, (1) the right to lay, construct and maintain sewers, drains, water pipes and other municipal utilities and services. In and under all roads and street right of way and the specific easement areas shown hereon, (2) the right to require dedication for public use the beds of the streets and/or roads and floodplains and open space where applicable, and for good and other valuable consideration, hereby grant the right at option to Howard County to acquire the fee simple title to the beds of the streets and roads and floodplains, storm drainage facilities and open space where applicable, (3) the right to require dedication of waterways and drainage easements for the specific purpose of their construction, repair and maintenance, and that no building or similar structure of any kind shall be erected on or over the said easements and rights of ways.

Witness our hands this 6 Day of JUNE, 1991

Highland Development Corporation

SEAL