

THIS REPORT
MUST BE SUBMITTED
WITHIN 30 DAYS
AFTER COMPLETION
OF THE WELL

WELL COMPLETION REPORT

WELL DESCRIPTION

Permit Number 7067 1023
Owner Francis A. B...
Address Clarksville
Subdivision _____
Section _____ Lot _____

WELL LOG
State the kind of formations penetrated, their color, their depth, their thickness, and if water-bearing

CASING AND SCREEN RECORD
Show the kind and size and position of casing, liner, pipe, screen, and other accessories (if no casing used, give diameter of well).

FEET		FORMATION	DIAM. (inches)	FEET	
from	to			from	to
		Sand			
		6 1/2" casing			
		Gravel Rock			
		Well 7 1/2"			

PUMPING TEST
Hours Pumped 1
Type of Pump Used Electric
Pumping Rate _____
Gallons per Minute _____


WATER LEVEL
Distance from land surface to water _____
Before Pumping 40 Ft.
When Pumping 60 Ft.

APPEARANCE OF WATER
Color Clear
Taste Good
Odor None

Height of Casing Above Land Surface 2 Ft.

PUMP INSTALLED
Type _____
Capacity _____
Gallons per Minute _____
Gallons per Hour _____
Pump Column Length _____ Ft.

LOCATION OF WELL ON LOT
Show permanent structures such as buildings, septic tank, and/or other landmarks and indicators not less than 2 distances (measurements) to well.

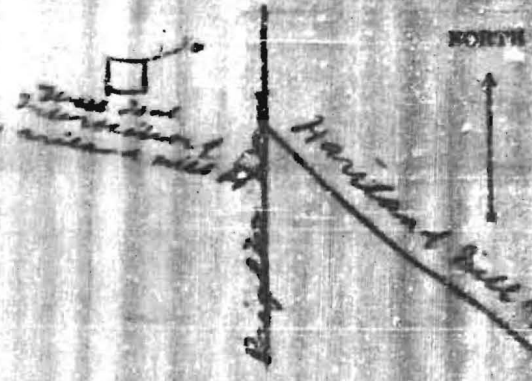

* A02815

DATE WELL WAS COMPLETED

I hereby affirm that this report contains no willful misrepresentations or falsifications and that information given in this report is true, accurate and complete to the best of my knowledge and belief.

Dennis B... Well Driller

Well Driller License No: 113

02/19/66