



A15830


# D. G. B., Inc.

1211 BRANCH ROAD WOODMERE ELICOTT CITY, MD. 21043 - PHONE 531 5500

JEN - 2 ACRES

SMALL

EL. AT TOP 435  
EL. EL. 435  
ANY, EL. 430

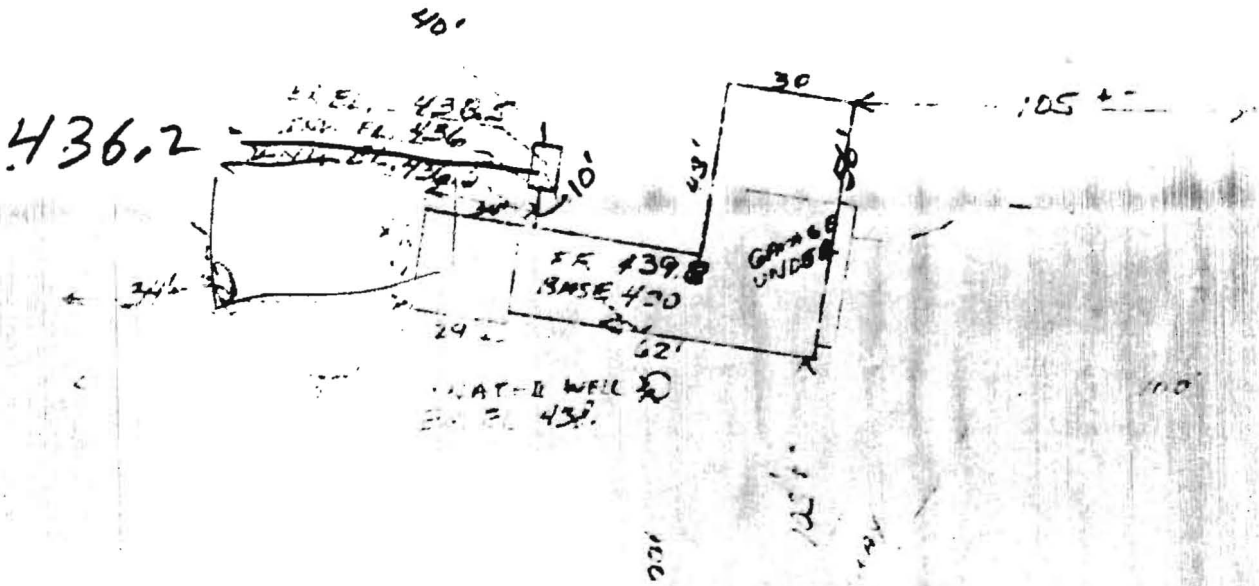

5/10/78 REVISED PLANS OK  
RH

ALBERT 24

MIL DEN

PERMIT NO. FROM PERMIT TO DRILL: 1 2 3 4 5 6 7 8 9 10 11 12 13 14 15 16 17 18 19 20 21 22 23 24 25 26 27 28 29 30 31 32 33 34 35 36 37 38 39 40 41 42 43 44 45 46 47 48 49 50

DATE RECEIVED (WRA USE ONLY): 11/10/78  
 DEPTH OF WELL: 140  
 DATE WELL COMPLETED: 11/10/78  
 COUNTY NUMBER: 3

OWNER: [REDACTED] LAST NAME: [REDACTED] STREET OR RD: [REDACTED] POST OFFICE: [REDACTED]

**WELL LOG**

STATE THE KIND OF FORMATIONS PENETRATED, THEIR COLOR, DEPTH, THICKNESS AND IF WATER BEARING

DESCRIPTION (USE ADDITIONAL SHEETS IF NECESSARY)	FEET FROM TO	CHARACTER OF WATER BEARING

**GROUTING RECORD**

WELL HAS BEEN GROUTED (CIRCLE APPROPRIATE BOX) YES  NO

TYPE OF GROUTING MATERIAL (CIRCLE BOX) CEMENT  BENTONITE CLAY

NO. OF BAGS: \_\_\_\_\_ NO. OF POUNDS: \_\_\_\_\_

GALLONS OF WATER: \_\_\_\_\_

DEPTH OF GROUT SEAL (TO NEAREST FOOT): FROM 45 FT. TO 54 FT. ENTER D. IF FROM SURFACE

**CASING RECORD**

(INSERT APPROPRIATE CODE BELOW)

STEEL  CONCRETE  PLASTIC  OTHER

MAIN CASING TYPE: \_\_\_\_\_ NOMINAL DIAMETER TOP (MAIN) CASING (NEAREST INCH): \_\_\_\_\_ TOTAL DEPTH OF MAIN CASING (NEAREST FOOT): \_\_\_\_\_

60 61 62 64 66 70

**OTHER CASING (IF USED)**

DIAMETER (INCH) \_\_\_\_\_ DEPTH (FEET) FROM TO \_\_\_\_\_

60 61 62 64 66 70

**SCREEN RECORD**

(INSERT APPROPRIATE CODE BELOW)

STEEL  BRASS OR BRONZE  PLASTIC  OPEN HOLE  OTHER

DEPTH (NEAREST WHOLE FOOT) FROM TO

1 8 9 11 15 17 21  
 2 23 24 26 30 32 36  
 3 38 39 41 45 47 51

SLOT SIZE 1. \_\_\_\_\_ 2. \_\_\_\_\_ 3. \_\_\_\_\_

**PUMPING TEST**

HOURS PUMP: \_\_\_\_\_ NEAREST HOUR: 12

PUMPING RATE: \_\_\_\_\_ GALLONS PER MINUTE TO NEAREST GALLON: 6

METHOD USED TO MEASURE PUMPING RATE: \_\_\_\_\_

WATER LEVEL (DISTANCE FROM LAND SURFACE) BEFORE PUMPING: 30

WHEN PUMPING: 140

TYPE OF PUMP USED (CIRCLE APPROPRIATE BOX FOR PUMPING TEST)

A AIR  P PISTON   
 27 27  
 C CENTRIFUGAL  R ROTARY   
 27 27  
 J JET  S SUBMERSIBLE   
 27 27

**PUMP INSTALLED**

TYPE OF PUMP WRITE APPROPRIATE LETTER BOX - SEE ABOVE: A, C, J, P, R, S, T, O

DRILLER WILL INSTALL PUMP (CIRCLE APPROPRIATE BOX) YES

CAPACITY: \_\_\_\_\_ GALLONS PER MINUTE (TO NEAREST GALLON) 31

PUMP HORSE POWER: \_\_\_\_\_ 37

PUMP COLUMN LENGTH (NEAREST FOOT): \_\_\_\_\_ 43

**CASING HEIGHT** (CIRCLE APPROPRIATE AND ENTER CASE)

+ ABOVE } LAND SURFACE  
 - BELOW }  
 49 50 51

**LOCATION OF WELL ON LAND**

SHOW PERMANENT STRUCTURE SUCH AS SEPTIC TANKS, AND/OR OTHER LAND MARKS. INDICATE NOT LESS THAN TWO DISTANCES (MEASUREMENTS TO WELL).

**CIRCLE APPROPRIATE BOXES**

A WELL WAS ABANDONED AND SEALED WHEN THE WELL WAS COMPLETED

E ELECTRIC LOG OBTAINED

P TEST WELL CONVERTED TO PRODUCTION WELL

I HEREBY CERTIFY THAT I HAVE COMPLIED WITH ALL CONDITIONS STATED ON THE ABOVE-CAPTIONED "PERMIT TO DRILL WELL", AND THAT INFORMATION CONTAINED IN THIS REPORT IS TRUE, ACCURATE, AND COMPLETE TO THE BEST OF MY KNOWLEDGE, INFORMATION AND BELIEF.

DRILLER'S NAME: \_\_\_\_\_

PLEASE PRINT: \_\_\_\_\_

**WELL LOG**

STATE THE KIND OF FORMATIONS PENETRATED, THEIR COLOR, DEPTH, THICKNESS AND IF WATER BEARING

DIAMETER OF SCREEN: 58 NEAREST INCH FROM 58 TO 60

GRAVEL PACK: \_\_\_\_\_

IF WELL DRILLED WAS A FLOWING WELL CIRCLE BOX: 68

WRA USE ONLY (NOT TO BE FILLED IN BY DRILLER):

Y \_\_\_\_\_ E.R.P. \_\_\_\_\_ W.C. \_\_\_\_\_