

12/21/75 not ready  
1/5/76  
1/21/76  
2/6/76  
Ready k.m.

# PERMIT

SEWAGE DISPOSAL SYSTEM

MARYLAND STATE DEPARTMENT OF HEALTH

HOWARD COUNTY

ELLICOTT CITY

DISTRICT 3

**INDEXED**

04334701

DATE 12/2/75

P 22563

A 19124

Costello Builders

IS PERMITTED TO INSTALL X ALTER

ADDRESS 2201 Route 94, Woodbine, Maryland

PHONE 442-2288

A SEWAGE DISPOSAL SYSTEM LOCATED AT \_\_\_\_\_

SUBDIVISION Gwenlee Estates

ROAD 3263 East side of Gwenlee Circle

LOT 5, Blk. D

PROPERTY OWNER Waldon L. Borjng

ADDRESS \_\_\_\_\_

SPECIFICATIONS - 3 bedrooms

DRAIN FIELD \_\_\_\_\_ DEPTH \_\_\_\_\_ FEET. BOTTOM AREA \_\_\_\_\_ SQ. FT.

SEEPAGE PITS \_\_\_\_\_ ABSORBENT SIDE-WALL AREA \_\_\_\_\_ SQ. FT.

SEPTIC TANK CAPACITY 1,000 GALLONS

FOR GARBAGE GRINDER, INCREASE DISPOSAL AREA 22% & TANK CAPACITY 50%.

OTHER Dry well - 400 sq. ft. absorbant sidewall area to begin below the first

44 ft. of non porous soil. Max. depth permitted is 114 ft. Trench to be installed off dry

well after 5 ft. buffer. Trench to be 50 ft. long - 114 ft. deep with 7 ft. of stone. Install

with contour of lot. Locate dry well 125 ft. from rear lot line and 25 ft. from right side line

as seen when facing Gwenlee Circle. CALL FOR INSPECTION OF TRENCH BEFORE GRAVEL IS INSTALLED.

NOTE: ALL PIPE FROM HOUSE TO DOSOOSAL AREA MUST BE CAST IRON.

PLANS APPROVED BY R. V. Torre DATE 10/23/75

PERMIT VOID AFTER THREE YEARS.

FILL SEPTIC TANK AND DISTRIBUTION BOX WITH WATER BEFORE CALLING FOR AN INSPECTION. COVER NO WORK UNTIL INSPECTED AND APPROVED.

NOTE: INSTALL CLEANOUTS ON SEPTIC TANK AND DRY WELL. CLEANOUTS MUST BE 6" IN DIA., CAST NEITHER THE HOWARD COUNTY COMMISSIONERS NOR THE HEALTH DEPARTMENT IS RESPONSIBLE FOR THE SUCCESSFUL OPERATION OF ANY SYSTEM.

**BUILDING PERMITS SIGNED**

**AND RETURNED**

5300 800153642-SHED

BLDG. PERMIT SIGNED AND RETURNED 9/8/78


Serial # 44231

J-car Jansen

pool permit signed 9/5/78 serial # 36982

A 19124

TOTAL AREA = 333 SQ. FT. + 270 TRENCH = 603 SQ. FT. TOTAL  
 2/24/76 R.H.

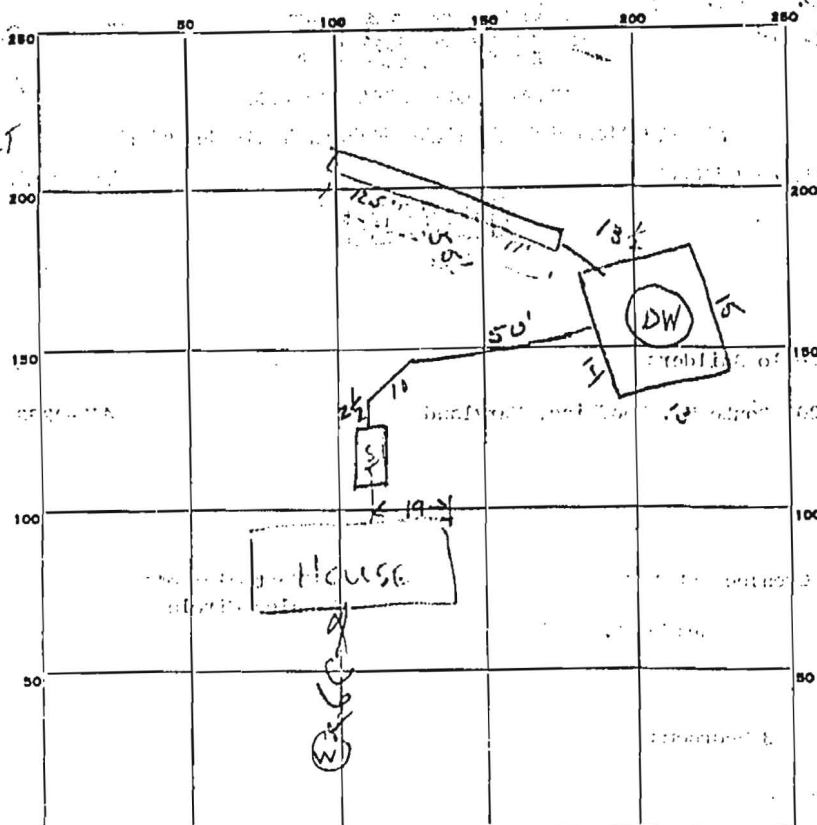

PERMIT CARD none seen - left note  
 SEPTIC TANK, LEVEL 1250 average CLEANOUTS ST / DW  
 DISTRIBUTION BOX, LEVEL 330

**DITCH**  
 TILE FIELD, DEPTH 5 FT. TRENCH WIDTH 2 1/2 FT.  
 GRAVEL DEPTH 5 IN. TOTAL LENGTH 55 FT.  
 NUMBER OF TRENCHES 1 TOTAL BOTTOM AREA 270  
 SEEPAGE PITS, INSIDE DIAMETER 55 1/2 FT. DEPTH BELOW INLET 6 FT.  
 ABSORBENT AREA 333 SQ. FT.

REMARKS 12/24/75 Inlet to DW @ 5 1/2' below orig. grade  
DW is 13' deep when spec called for 12' max depth  
Disc w DWM, install to raise inlet to 4 1/2', correct  
eff area to 11 1/2'; then will need trench 55' long 12'  
deep (ground slopes up) w 7" gravel under pipe.

1/24/76  
 215/176 well OK  
 DATE SYSTEM APPROVED 2/24/76 INSPECTOR Raymond Hodge