

PUB. SEWER STATUS VERIFIED BY _____

ISSUE DATE: _____

PERMIT

P Index _____

APPROVAL DATE: _____

A 519569-G _____

INDEXED

ON-SITE SEWAGE DISPOSAL SYSTEM HOWARD COUNTY HEALTH DEPARTMENT BUREAU OF ENVIRONMENTAL HEALTH

02-241242

_____ IS PERMITTED TO INSTALL ALTER

ADDRESS: _____ PHONE NUMBER: _____

SUBDIVISION: St. Johns Village LOT NUMBER: 11, Block A

ADDRESS: 9044 Dunloggin Road PROPERTY OWNER: Jonathan Davis

SEPTIC TANK CAPACITY (GALLONS): _____

PUMP CHAMBER CAPACITY (GALLONS): _____

NUMBER OF BEDROOMS: _____

SQUARE FEET PER BEDROOM: _____

LINEAR FEET OF TRENCH REQUIRED: _____

TRENCHES:	Trench to be _____ feet wide. Inlet _____ feet below original grade. Bottom maximum depth _____ feet below original grade. Effective area begins at _____ feet below original grade. _____ feet of stone below distribution pipe.
LOCATION:	_____
PURPOSE:	No previous records found, BP approved. On public water and Public sewerage is available.

PLANS APPROVED: _____ DATE: _____

- NOTE: PERMIT VOID AFTER 2 YEARS
- NOTE: CONTRACTOR RESPONSIBLE FOR SCHEDULING A PRE-CONSTRUCTION INSPECTION FOR ALL INSTALLATIONS
- NOTE: WATERTIGHT SEPTIC TANKS REQUIRED
- NOTE: ALL PARTS OF SEPTIC SYSTEM SHALL BE 100 FEET FROM ANY WATER WELL
- NOTE: MANHOLE RISERS REQUIRED ON ALL SEPTIC TANKS AND PUMP CHAMBERS


NEITHER THE HOWARD COUNTY COUNCIL NOR THE HEALTH DEPARTMENT IS RESPONSIBLE FOR THE SUCCESSFUL OPERATION OF ANY SYSTEM PERMITTEE RESPONSIBLE FOR OBTAINING FINAL APPROVAL ON THIS PERMIT CALL 410-313-2640 FOR INSPECTION OF SEPTIC SYSTEM

519569-G

NOTES:

- 1) B.R.L. information, if shown, was obtained from existing record plat or local agencies and is not guaranteed by NTT, Inc.
- 2) Building line and/or Flood Zone information is subject to the interpretation of the originator.
- 3) NTT, Inc. does not certify to unshown or unrecorded encroachments or overlaps.
- 4) Property markers not found, or guaranteed by this location.
- 5) Setback distance accuracy: 1"=40'

7/30/03
 Proposed Addition
 O.K. Public Water
 and Sewer Available
 Enlarging Master
 Bedroom and Adding
 Bathroom
 (BB)

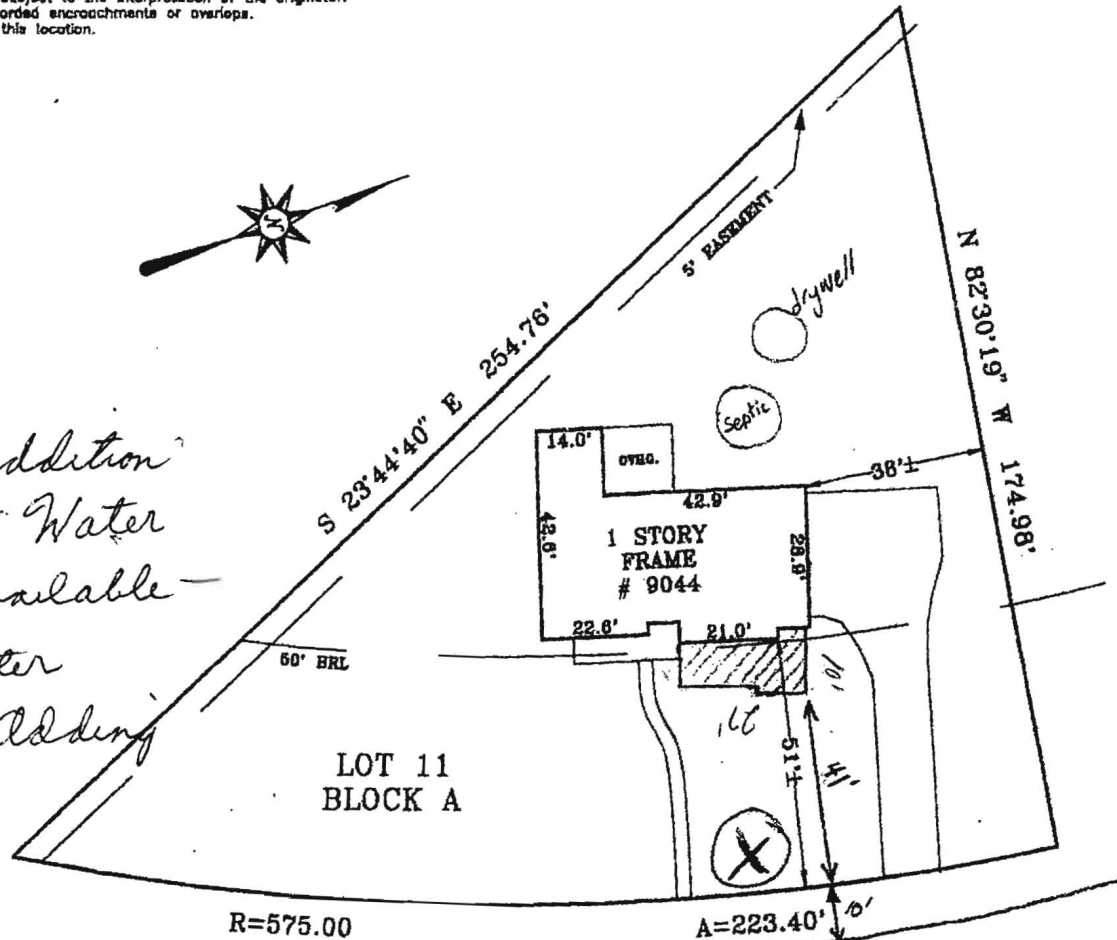

LOT 10


= proposed addition

Subject property is shown in Zone C on the National Flood Insurance Program Flood Insurance Rate Map of Howard County, Maryland, Panel # 23 of 45 Community Panel # 240044-00 23B Effective date: December 4, 1986

DUNLOGGIN ROAD
 50' R/W

Poster location

This is to certify that I have surveyed the property shown hereon, being known as **LOT 11 BLOCK A 9044 DUNLOGGIN ROAD** recorded in the Land Records of Howard County, Maryland in Plat Bk. **6/16** Liber Folio for the purpose of locating the improvements thereon.

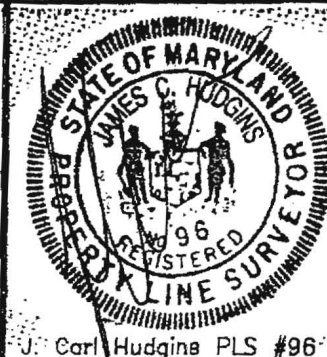

LOCATION DRAWING
 9044 DUNLOGGIN ROAD
 ST. JOHN'S VILLAGE
 2ND ELECTION DISTRICT
 HOWARD COUNTY, MARYLAND

* This plat is of benefit to the consumer only insofar as it is required by a lender or a title insurance company or its agent in connection with contemplated transfer, financing, or refinancing purposes.
 * This plat is not to be relied upon for the establishment of location of fences, garages, buildings, or other existing or future structures. This plat does not provide for the accurate identification of property boundary lines, but such identification may not be required for financing or refinancing.

NTT Associates, Inc.
 16205 Old Frederick Road
 Mt. Airy, Maryland 21771
 Ph. (410)442-2031
 Fax No. (410)442-1315

Scale:	1"= 40'
Date:	DECEMBER 18, 1995
Field by:	JLM
Drawn by:	JLM
Drawing #	353BEC

J. Carl Hudgins PLS #96