

PUB. SEWER STATUS VERIFIED BY _____

ISSUE DATE: _____

APPROVAL DATE: _____

PERMIT INDEXED

P Re-Index

A 519569-F

ON-SITE SEWAGE DISPOSAL SYSTEM HOWARD COUNTY HEALTH DEPARTMENT BUREAU OF ENVIRONMENTAL HEALTH

05-364353

IS PERMITTED TO INSTALL ALTER

ADDRESS: _____ PHONE NUMBER: _____

SUBDIVISION: Greenwood Farms LOT NUMBER: 9

ADDRESS: 7518 Browns Bridge Road PROPERTY OWNER: Richard Somwaru

SEPTIC TANK CAPACITY (GALLONS): _____

PUMP CHAMBER CAPACITY (GALLONS): _____

NUMBER OF BEDROOMS: _____

SQUARE FEET PER BEDROOM: _____

LINEAR FEET OF TRENCH REQUIRED: _____

TRENCHES:	Trench to be _____ feet wide. Inlet _____ feet below original grade. Bottom maximum depth _____ feet below original grade. Effective area begins at _____ feet below original grade. _____ feet of stone below distribution pipe.
LOCATION:	
PURPOSE:	File re-indexed with notes about ust to be removed dated 7/29/03

PLANS APPROVED: _____ DATE: _____

- NOTE: PERMIT VOID AFTER 2 YEARS
- NOTE: CONTRACTOR RESPONSIBLE FOR SCHEDULING A PRE-CONSTRUCTION INSPECTION FOR ALL INSTALLATIONS
- NOTE: WATERTIGHT SEPTIC TANKS REQUIRED
- NOTE: ALL PARTS OF SEPTIC SYSTEM SHALL BE 100 FEET FROM ANY WATER WELL
- NOTE: MANHOLE RISERS REQUIRED ON ALL SEPTIC TANKS AND PUMP CHAMBERS


NEITHER THE HOWARD COUNTY COUNCIL NOR THE HEALTH DEPARTMENT IS RESPONSIBLE FOR THE SUCCESSFUL OPERATION OF ANY SYSTEM PERMITTEE RESPONSIBLE FOR OBTAINING FINAL APPROVAL ON THIS PERMIT CALL 410-313-2640 FOR INSPECTION OF SEPTIC SYSTEM

A519569-F

SITE INSPECTION SHEET

OWNER: Somwaru PHONE #: _____
ADDRESS: 7518 Browns Bridge Rd. CONTRACTOR: Mike Boyle
WELL TAG #: _____
SUBDIVISION: Greenwood Farms LOT: 9 COUNTY #: A519569 F
PROPOSAL: Tie into ex. septic system from new addition.

LOCATION DIAGRAM

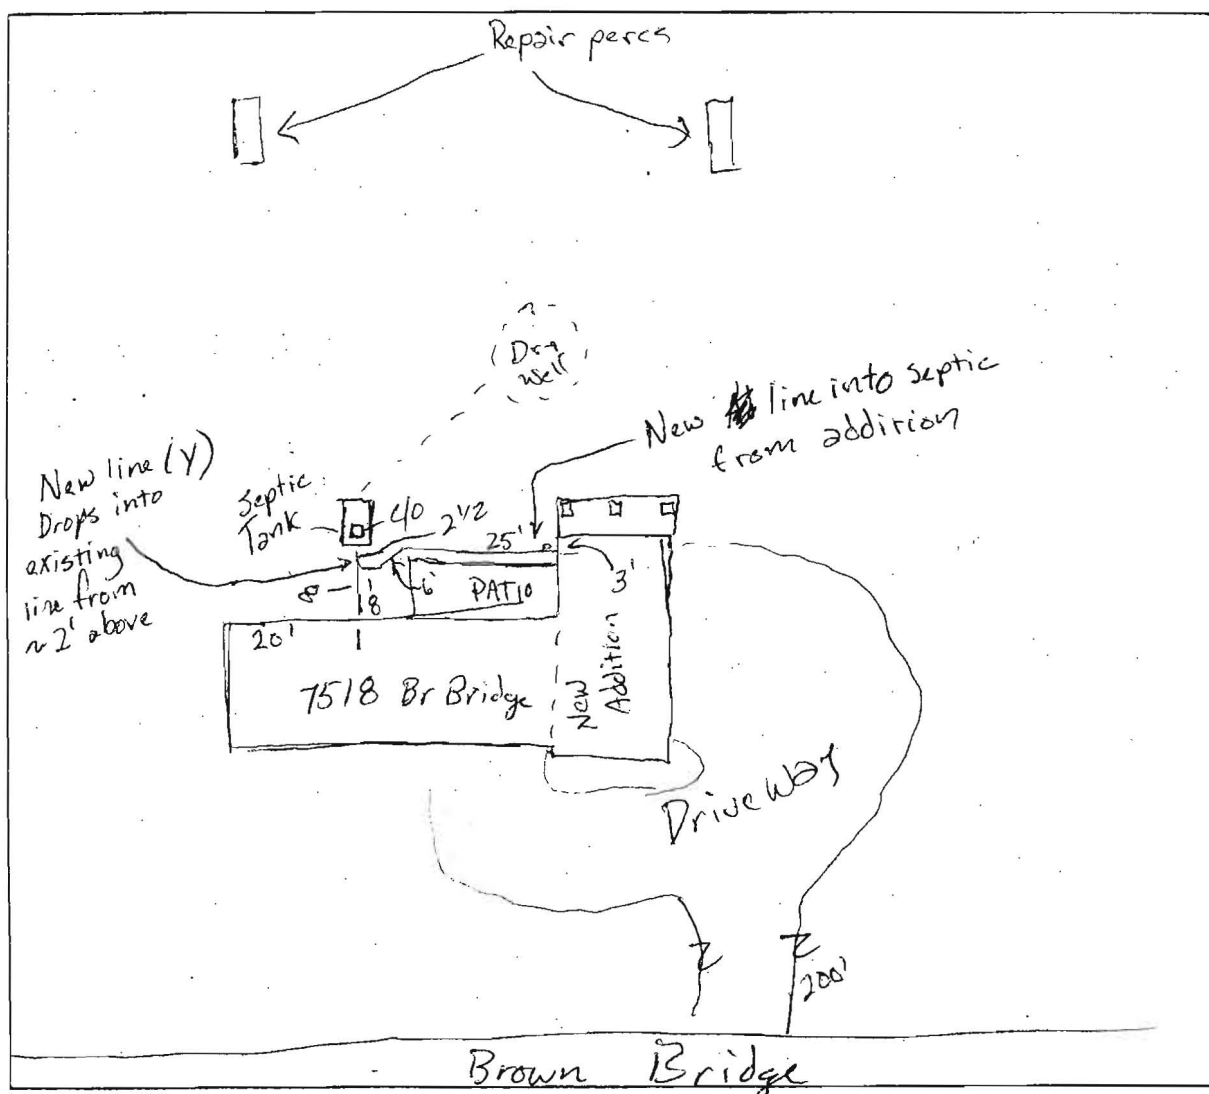

COMMENTS: Septic Tank baff'le is intact. new gravity line from addition ~~will~~ shouldn't interfere w/ function of Septic tank

DATE: 12/1/05 INSPECTOR: Jahid A. Lington

SITE INSPECTION SHEET

OWNER: _____ PHONE #: _____


ADDRESS: 7518 Browns Bridge CONTRACTOR: _____

WELL TAG #: _____

SUBDIVISION: _____ LOT: _____ COUNTY #: _____

PROPOSAL: check function of exist. system. backhoe operator to be at site, otherwise auger date set on 8-12-05.

~400' Brownbridge rd LOCATION DIAGRAM

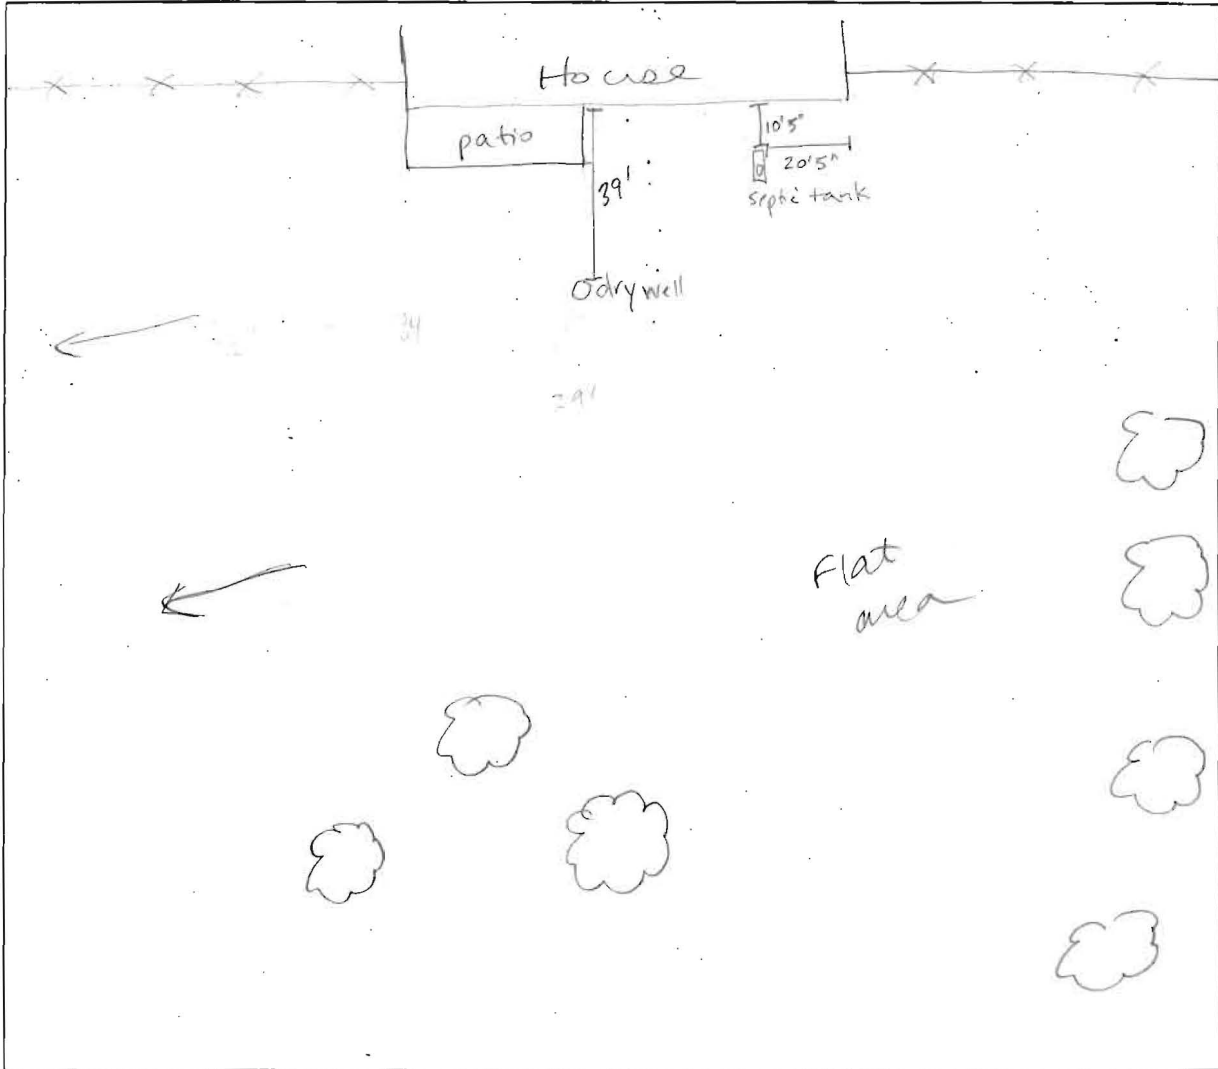

COMMENTS: Existing found to be properly functioning,
Fogel's services sent receipt of services performed
on septic system which verified system is satisfactory.
Per test completed 8/26/05 repair established. (SF)

DATE: 8/18/05 INSPECTOR: SF