


Brown bridge 4/24/00'

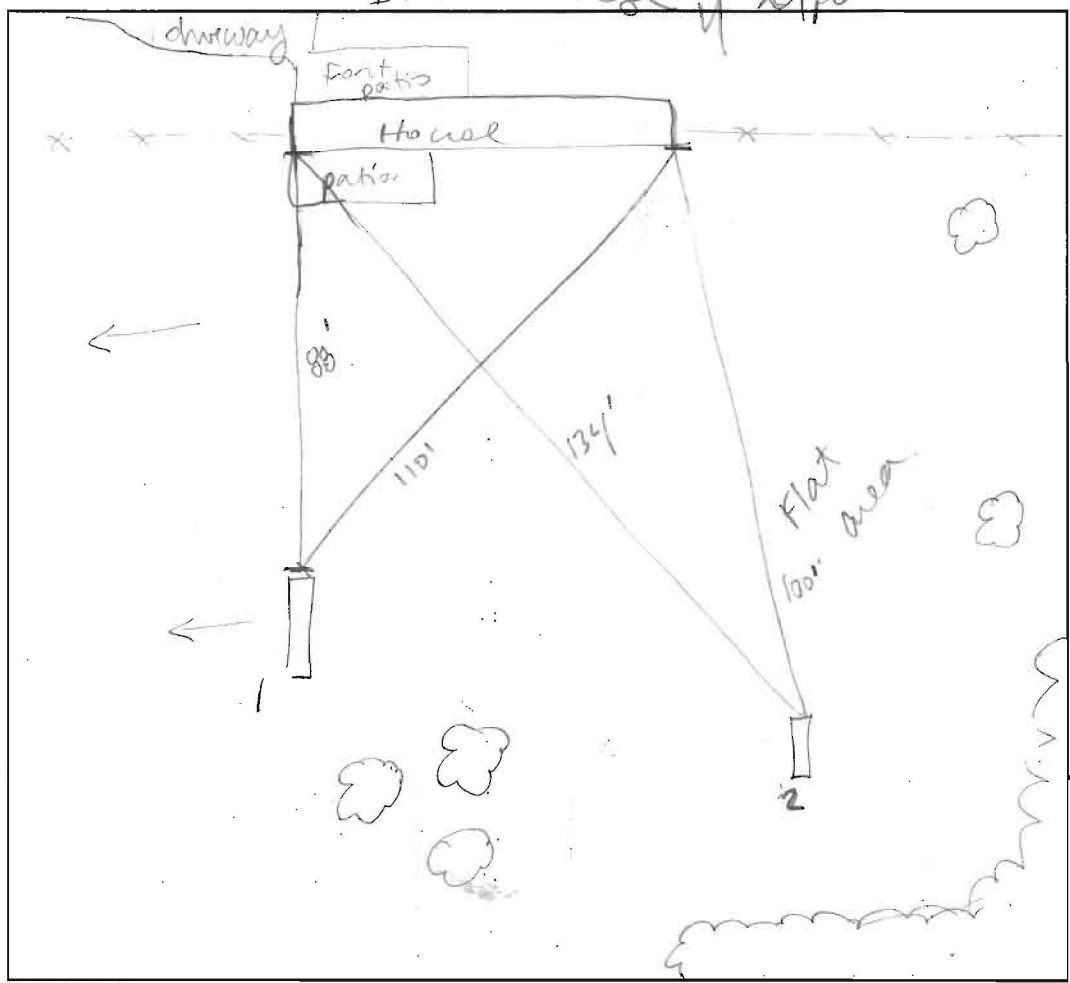

A/P

1
brown L
1'
orange brown
scl
cw
5% gravel
4'
yellow brown
scl
moist sg
milascrews
5% gravel
cw sbk
11'
yellow brown
15 sg

2
brown L
1'
yellow brown
scl
cw sbk
3'
5% gravel
orange brown
scl
milascrews
5% cobbles
cw sbk
4.5'
yellow brown
scl
cw sbk
10.5'
yellow brown
15 sg
12'

DATE	TEST #	DEPTH	START	BREAK 1" DROP	STOP 2" DROP	TIME OF 2nd INCH	P/F/H
8/26/05	1	5' / 11.5'	9:18 ²²	9:27 ¹⁵	9:52	25	P
	2	5' / 12'	10:15 ¹⁴	10:18	10:23	5	P

REMARKS Repair area established

SANITARIAN SF BACKHOE Mike Boyce OTHERS Marcie Kayado

TEST HOLES USED IN SDA _____ AVG. PERC TIME 15 SQ. FT/BR _____

TRENCH WIDTH _____ INLET DEPTH _____ MAX. BOT DEPTH _____ EFFECTIVE S/W _____

