

4/15/74
file NW 7
4/15/74
4/15/74

202 20

PERMIT

P. 19769
Refuse

SEWAGE DISPOSAL SYSTEM

MARYLAND STATE DEPARTMENT OF HEALTH

HOWARD COUNTY

ELLICOTT CITY

INDEXED

DISTRICT 5

DATE 4/7/74

Jack Frost IS PERMITTED TO INSTALL ALTER X

ADDRESS Tom Oaks Road, Dayton, Md. PHONE 288-2938

A SEWAGE DISPOSAL SYSTEM LOCATED AT _____

SUBDIVISION San 10/4 22 Ma 15000 ROAD 7318 Brown Bridge Rd

PROPERTY OWNER Mallon Rea, Jr left turn on Brown Bridge off Rt. 216
3th house on right

ADDRESS _____

SPECIFICATIONS

DRAIN FIELD _____ DEPTH _____ FEET, BOTTOM AREA _____ SQ. FT.

SEEPAGE PITS _____ ABSORBENT SIDE-WALL AREA _____ SQ. FT.

SEPTIC TANK CAPACITY _____ GALLONS

FOR GARBAGE GRINDER, INCREASE DISPOSAL AREA 25% & TANK CAPACITY 50%


OTHER REPAIR - Call for inspection of system when system is in operation and
recommend repair system.

PLANS APPROVED BY Palmer F. Wine DATE 4/7/74

FILL SEPTIC TANK AND DISTRIBUTION BOX WITH WATER BEFORE CALLING FOR AN INSPECTION. COVER NO WORK UNTIL INSPECTED AND APPROVED.

NEITHER THE HOWARD COUNTY COMMISSIONERS NOR THE HEALTH DEPARTMENT IS RESPONSIBLE FOR THE SUCCESSFUL OPERATION OF ANY SYSTEM.

P 19769

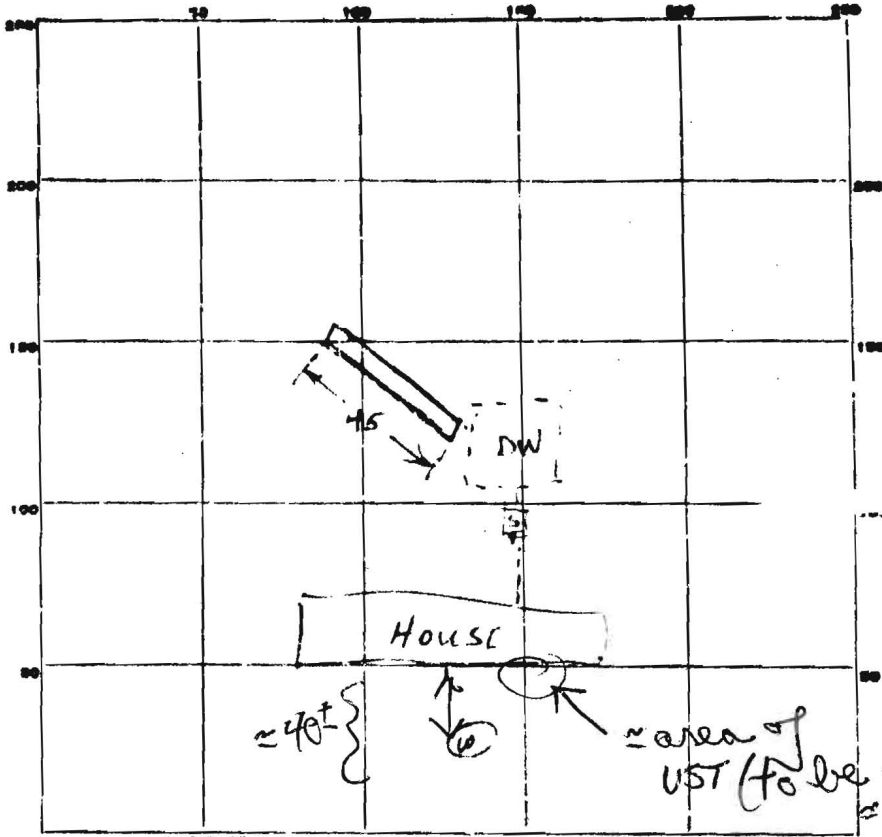

INDICATE NORTH - NAME ADJOINING ROADWAY AS BASE LINE.
BROWN BRIDGE RD

A/S
area of UST (to be removed) = 7/29/03

PERMIT CARD _____

SEPTIC TANK, LEVEL _____ CLEANOUTS _____

DISTRIBUTION BOX, LEVEL _____

TILE FIELD, DEPTH _____ FT. TRENCH WIDTH 2 FT.

GRAVEL DEPTH 3 1/2 FT. TOTAL LENGTH 45+ FT.

NUMBER OF TRENCHES 1 SIDEWALK TOTAL BOTTOM AREA _____

SEEPAGE PITS, INSIDE DIAMETER _____ FT. DEPTH BELOW INLET _____ FT.

ABSORBENT AREA 35.3 SQ. FT.

45
3 1/2
2
35.3

REMARKS 4/15/74 7-trench 1/4" TW, 12" deep, 45-48 ft
long, 8 1/2" gravel under pipe. Good sandy
soil. Good PA.

DATE SYSTEM APPROVED 4/15/74 INSPECTOR William H. Zupp