

THIS REPORT
MUST BE SUBMITTED
WITHIN 30 DAYS
AFTER COMPLETION
OF THE WELL

WELL COMPLETION REPORT **A10328**

WELL DESCRIPTION **ACTA**

WELL LOG
State the kind of formations penetrated, their color, their depth, their thickness, and if water-bearing

CASING AND SCREEN RECORD
State the kind and size and position of casing, liner, shoe, screen, and other accessories (if no casing used, give diameter of well).

Permit Number **42-10-3**
Owner **John Smith**
Address **123 Main St**
Subdivision **Greenwood**
Section **10-7**

	FEET from ___ to ___
Top soil	-2
Yellow clay	2-10
Gravel and sand	10-58
Light Stone and sand Rock	58-102
water 30 ft	
water at 90 ft	
68-W-9	
3.5 gal and good	
1967	

DIAM. (inches)	FEET from ___ to ___
5 7/8	
13 black steel	
10 1/2 hp pump	
welded shoe	

PUMPING TEST
Hours Pumped **2**
Type of Pump Used **Hand**
Pumping Rate **5**
Gallons per Minute


WATER LEVEL
Distance from land surface to water
Before Pumping **25**
After Pumping **10**

APPEARANCE OF WATER
Clear Cloudy
Taste _____
Odor _____

Height of Casing Above Land
Surface **1** ft

PUMP INSTALLED
Type _____
Capacity _____
Gallons per Minute _____
Gallons per Hour _____
Pump Column Length _____ ft

LOCATION OF WELL ON LOT
Show permanent structures such as buildings, septic tank, and/or other landmarks and indicate not less than 2 distances (measurements) to well.

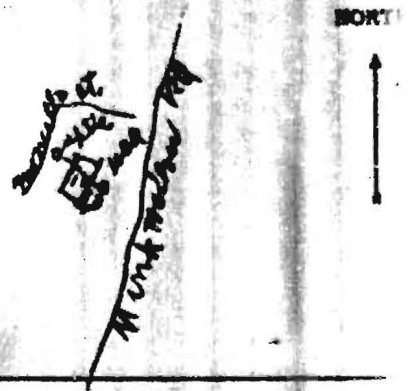

Date Well Was Completed **May 1967**
Well Driller **Raymond Kelly**
Signature **[Signature]**

State Office Building
ANNAPOLIS, MARYLAND 21401

STATE OF MARYLAND
DEPARTMENT OF
WATER RESOURCES

THIS REPORT
MUST BE SUBMITTED
WITHIN 30 DAYS
AFTER COMPLETION
OF THE WELL

Vanilla WELL COMPLETION REPORT A 10328

Green Hill Manor WELL DESCRIPTION *AT 80 FT?*

WELL LOG
State the kind of formations penetrated, their color, their depth, their thickness, and if water-bearing

CASING AND SCREEN RECORD
State the kind and size and position of casing, liner, shoe, screen, and other accessories (if no casing used, give diameter of well).

	FEET from ___ to ___
Topsoil	-2
Yellow clay	2-12
micaceous sand	12-65
micaceous rock	65-114

Black steel
10 1/2" pipe
welded shoe

DIAL (inches)	FEET from ___ to ___
5 3/4	-70

Water at 30

Water 80

great 3 logs cement / ft.

Permit Number *MD 2-11*
Owner *Green Hill Manor*
Address *12345*
Subdivisor *Green Hill Manor*
Section *A* Lot *8*

PUMPING TEST

Hours Pumped *2*
Type of Pump *Flow*
Pumping Rate *20*
Gallons per minute *20*

WATER LEVEL

Distance from land surface to water

Before Pumping *12*

When Pumping *20*

APPEARANCE OF WATER

Clear Cloudy

Taste _____

Odor _____

Height of Casing Above Land Surface _____

Series _____

PUMP INSTALLED

Type _____

Capacity _____

Gallons per minute _____

Gallons per hour _____

Pump Column Length _____

LOCATION OF WELL ON LOT

Show permanent structures such as buildings, or tank, and/or other landmarks and indicate not less than 2 distances (measurements) to well.



Date Well Was Completed *May 30/67*

Well Driller *Clifton Hardy*
Signature *John W. Bell*

TRIPPLICATE