

5/9/66

approved  
5/9/66  
[Signature]

# PERMIT

SEWAGE DISPOSAL SYSTEM

P. 11460  
A. 09298

MARYLAND STATE DEPARTMENT OF HEALTH

HOWARD COUNTY

ELLCOTT CITY

**INDEXED**

DISTRICT 5

DATE 1/28/66

Ebner Brothers IS PERMITTED TO INSTALL  ALTER

ADDRESS 2112 Park Ave., Silver Spring, Md. PHONE WH 2-7050

A SEWAGE DISPOSAL SYSTEM LOCATED AT \_\_\_\_\_

SUBDIVISION Beaufort Park ROAD Blount's Lane LOT 5, Blk. G

PROPERTY OWNER Anne K. Gray & Susie Kondrup

ADDRESS \_\_\_\_\_

SPECIFICATIONS - 5 bedrooms

DRAIN FIELD \_\_\_\_\_ DEPTH \_\_\_\_\_ FEET, BOTTOM AREA \_\_\_\_\_ SQ. FT.

SEEPAGE PITS \_\_\_\_\_ ABSORBENT SIDE-WALL AREA \_\_\_\_\_ SQ. FT.

SEPTIC TANK CAPACITY 1,500 ~~1,000~~ GALLONS

FOR GARBAGE GRINDER, INCREASE DISPOSAL AREA 22% & TANK CAPACITY 50%.

OTHER Dry well - 100 sq. ft. absorbent sidewall area per bedroom.

Locate dry well 125 ft. from the point where the back lot line and right side line meet and 75 ft. from the back lot line as lot is seen when facing it from Blount's Lane.


PLANS APPROVED BY R. D. Fletcher DATE 1/8/65

FILL SEPTIC TANK AND DISTRIBUTION BOX WITH WATER BEFORE CALLING FOR AN INSPECTION. COVER NO WORK UNTIL INSPECTED AND APPROVED.

NEITHER THE HOWARD COUNTY COMMISSIONERS NOR THE HEALTH DEPARTMENT IS RESPONSIBLE FOR THE SUCCESSFUL OPERATION OF ANY SYSTEM.

A 09298

BP # 23514

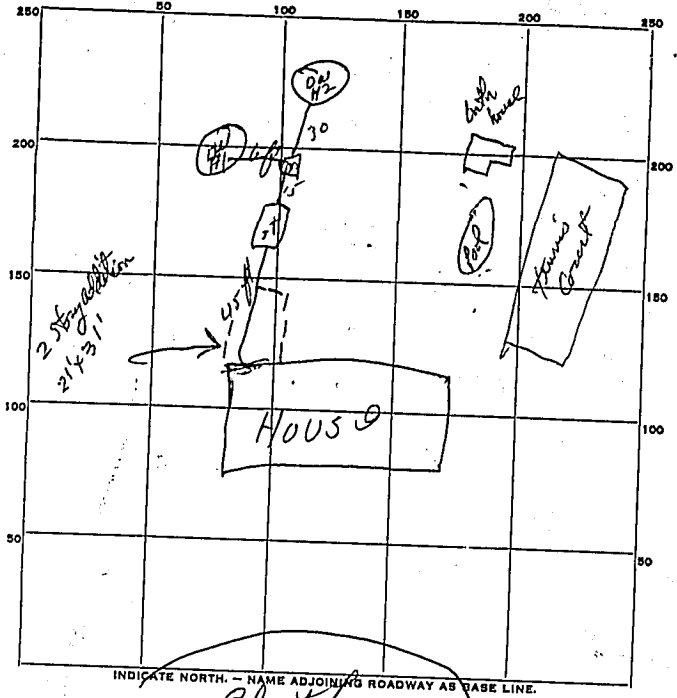

INDICATE NORTH - NAME ADJOINING ROADWAY AS BASE LINE.

*Blount Lane*

PERMIT CARD \_\_\_\_\_

SEPTIC TANK, LEVEL OK CLEANOUTS 6/2

DISTRIBUTION BOX, LEVEL OK

TILE FIELD, DEPTH \_\_\_\_\_ FT. TRENCH WIDTH \_\_\_\_\_ FT.

GRAVEL DEPTH \_\_\_\_\_ IN. TOTAL LENGTH \_\_\_\_\_ FT.

NUMBER OF TRENCHES \_\_\_\_\_ TOTAL BOTTOM AREA \_\_\_\_\_

SEEPAGE PITS, INSIDE DIAMETER \_\_\_\_\_ FT. DEPTH BELOW INLET \_\_\_\_\_ FT.

ABSORBENT AREA \_\_\_\_\_ SQ. FT.

REMARKS *2 1/2\"/>*

INSPECTOR *Donald W. Managhan*