

APPLICATION

A 18653

P _____

SEWAGE DISPOSAL TESTING

MARYLAND STATE DEPARTMENT OF HEALTH

HOWARD COUNTY

ELLICOTT CITY

*Septic tank 3 bedroom - 750 gal
" " " " 1000 gal*

DISTRICT 5

DATE 7/27/69

*Dry Well ~~Howard County~~ 3 bedroom 336 sq ft above ground in back yard
inlet pipe 4 bedroom 448 sq ft below original grade. 20' depth, permit of
dry well is 12' below orig. grade*

*Please dry well 50 ft from the 1999 1/2 foot first lot line and
141 ft from reproduction as seen when facing front*

TO: THE COUNTY HEALTH OFFICER
ELLICOTT CITY, MARYLAND

I, HEREBY, APPLY FOR THE NECESSARY TESTS IN ORDER TO CONSTRUCT (OR RECONSTRUCT) A SEWAGE DISPOSAL SYSTEM.

PROPERTY OWNER Arthur J. Adkins

ADDRESS _____ PHONE _____

PROPERTY LOCATION:

SUBDIVISION _____ LOT NO. C

ROAD AND DESCRIPTION John Hopkins Road & Banner Rd. (see attached plat)

OCCUPANT _____ PHONE _____

PERSON TO CONSTRUCT SYSTEM _____

ADDRESS _____ PHONE _____

SIZE OF LOT 2.250 acres TYPE BLDG. 3 of 4
NUMBER OF BEDROOMS

IF NOT SINGLE RESIDENCE DESCRIBE _____

SIGNATURE OF APPLICANT /s/ Mrs. Betty Adkins


APPROVED BY Sheila K. ... FOR Dry Well DATE 7/27/69
(KIND OF SYSTEM)

REJECTED BY _____ FOR _____ DATE _____
(KIND OF SYSTEM)

HOLD PENDING FURTHER TESTS _____ DATE _____

REASONS FOR REJECTION OR HOLDING _____

THIS IS NOT A PERMIT

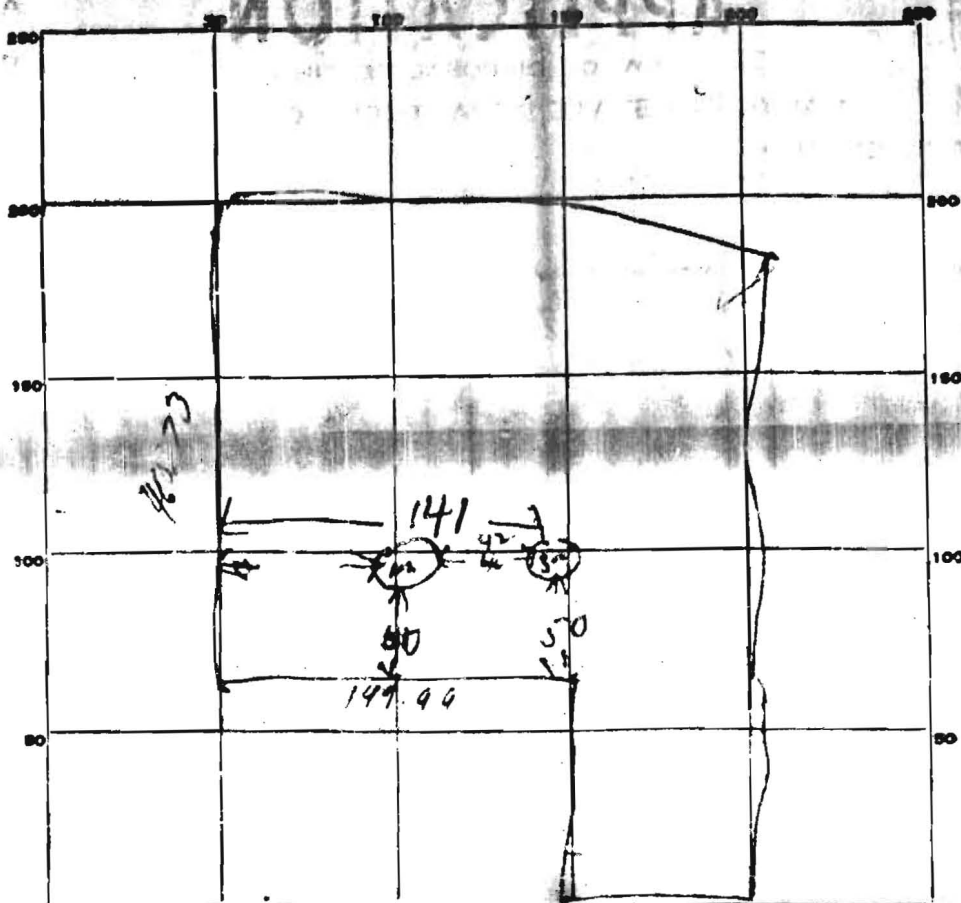

INDICATE NORTH. - NAME ADJOINING ROADWAY AS BASE LINE.

DATE	TEST NO.	DEPTH	PRE-WET		TEST - 1' DROP		TIME
			START	STOP	START	STOP	
7/22/80	1	4 ft	10 ⁰⁸	10 ⁰⁹	10 ⁰⁹	10 ¹¹	2 min
	2	13 ft	10 ¹⁰	10 ¹³	10 ¹³	10 ¹⁹	6 min
	3	4 ft	10 ³³	10 ³⁹	10 ³⁹	10 ⁵²	13 min
	4	4 ft	10 ³⁵	10 ³⁸	10 ³⁸	10 ⁴⁵	7 min

SOIL AUGER FINDING _____

TESTED BY Dut

REMARKS _____