

APPLICATION

A1453
13104
P _____

SEWAGE DISPOSAL TESTING

MARYLAND STATE DEPARTMENT OF HEALTH

HOWARD COUNTY

ELLICOTT CITY

Sepic Tank - 3 bedrooms - 750 gal.
" " " " - 1000 gal.

DISTRICT 5th

Dry Well - 3 bedrooms - ~~digging to 15 ft deep~~ use a DATE Sept. 2, 1967
each dry well to be 15 ft diameter and 6 ft deep below inlet pipe. Inlet
pipe to be 4 ft below original grade.

Dry Well - 4 bedrooms - 2 dry wells - each 15 ft diameter and 7 ft deep
below inlet pipe. Inlet pipe to be 4 ft below orig. grade

Place each dry well about 60 ft from right side line as seen when
viewing lot from Highway 285 with one dry well about 120 ft from rear lot line
and second dry well about 160 ft from rear lot line
* Dry wells must be 3 times diameter at edge of edge and
may be connected in series

TO: THE COUNTY HEALTH OFFICER
ELLICOTT CITY, MARYLAND

I, HEREBY, APPLY FOR THE NECESSARY TESTS IN ORDER TO CONSTRUCT (OR RECONSTRUCT) A SEWAGE
DISPOSAL SYSTEM.

PROPERTY OWNER Roland N., Mabel G., Cissel S. and Myrtle V. Granel

ADDRESS 919 Montgomery Street, Laurel, Md. PHONE 301-725-1529

PROPERTY LOCATION: John Hopkins Road and Sanner Road
Seagsville, Maryland

SUBDIVISION _____ LOT NO. C

ROAD AND DESCRIPTION As per plat attached

OCCUPANT None PHONE _____

PERSON TO CONSTRUCT SYSTEM PAUL O. GREGG

ADDRESS Route #2, Box 47, Wright Rd., Hanover, Md. PHONE 762-0952

SIZE OF LOT 12,250 sq. ft. TYPE BLDG. None
NUMBER OF BEDROOMS _____

IF NOT SINGLE RESIDENCE DESCRIBE _____

SIGNATURE OF APPLICANT  Charles L. Richards, Atty., 18 Univ. Blvd., East, Silver Spring, Md.
301-593-6220 land.


APPROVED BY  FOR Dry Well DATE 10/3/67
(KIND OF SYSTEM)

REJECTED BY _____ FOR _____ DATE _____
(KIND OF SYSTEM)

HOLD PENDING FURTHER TESTS _____ DATE _____

REASONS FOR REJECTION OR HOLDING _____

THIS IS NOT A PERMIT

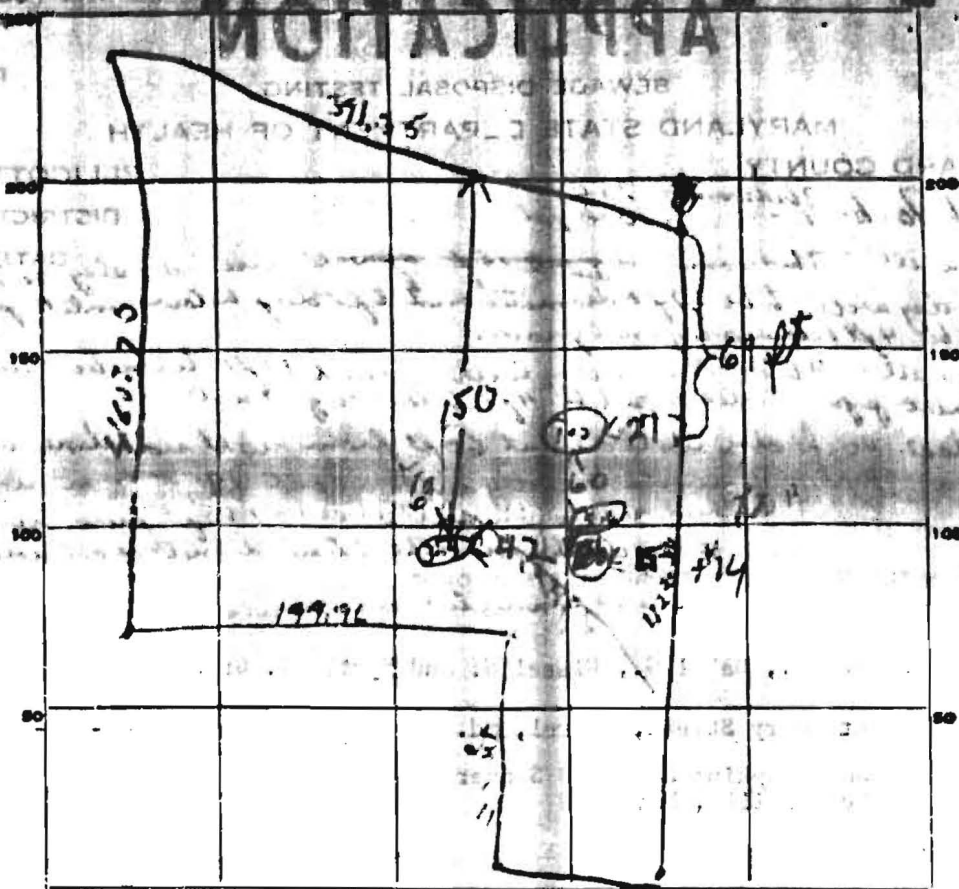

INDICATE NORTH. - NAME ADJOINING ROADWAY AS BASE LINE.

John Hopkins

DATE	TEST NO.	DEPTH	PRE-TEST		TEST - 1" DROP		TIME
			START	STOP	START	STOP	
7/17/01	1-2	water at 8 ft - also water in 7 ft depth from ground					
	3	4 1/2 ft	11 22	11 39	11 39	11 55	16 min
	4	10 ft	11 27	11 32	11 32	11 43	11 min
	5	9 1/2 ft	11 53	11 56	11 56	12 01	5 min
	6	4 ft	11 56	11 59	11 59	12 06	7 min

SOIL AUGER FINDING _____

TESTED BY *JHM*

REMARKS *near a lot line the water table is 12 ft below surface. min depth 12 ft below surface. grade: P7*

7/17/01 also found Paul C. [unclear] Lot c