


TACK FRANK 410 988-9270  
225<sup>th</sup> Director of Finance

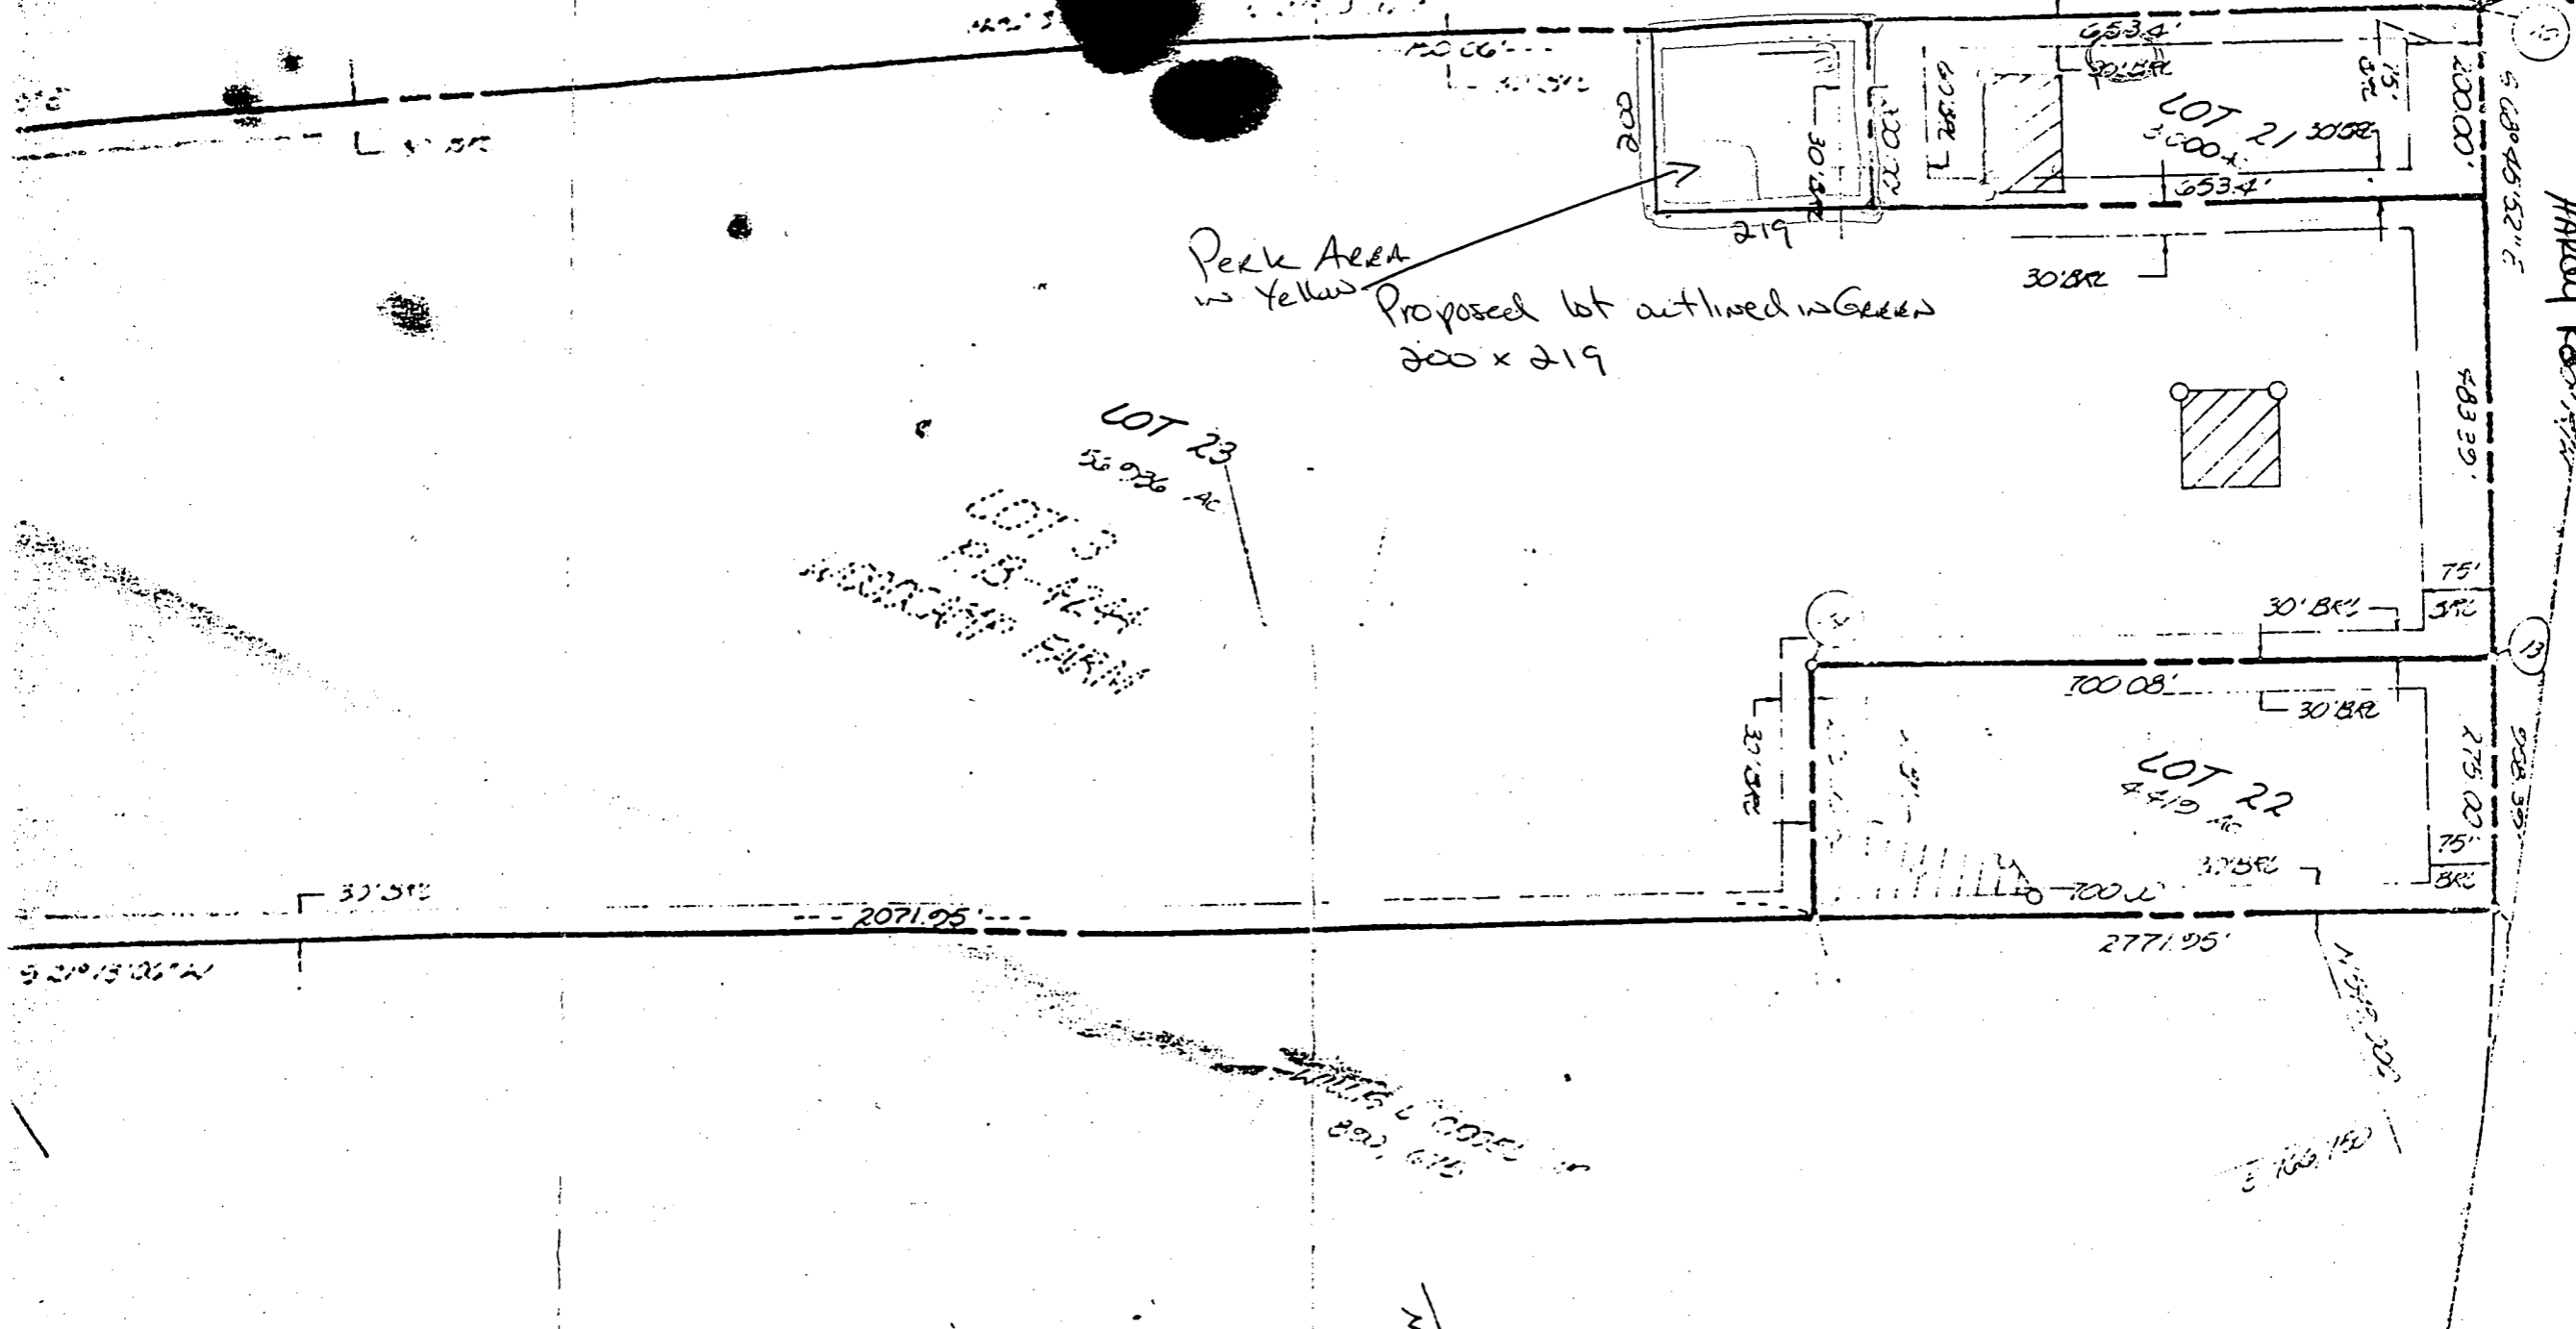

Perk Area  
w Yellow  
Proposed lot outlined in Green  
200 x 219

LOT 23  
56.936 AC  
LOT 22  
4.410 AC  
LOT 21  
3.000 AC

PARKWAY

S 21° 15' 00" W

30.51'

2071.95'

2771.95'

275.00'

75'

483.39'

200.00'

1423.20'

15

12

510' 00" S 100° 00' W

E 100.150'

N 15° 30' 00" W

N

# HARDY ROAD

(LOCAL ROAD)  
50' R/W

- 1) To
- 2) Deed
- 3) Coord. coord.
- 4) Subject
- 5) • • • • •
- 6) The lots sr. and lots sr. Mental Hy
- 7) 17

WILLIS L. CARREL JR.  
P.B. 4703

1" = 200'

1482.37' N 21° 13' 06" E

E 765.250' N 54° 00'

IRON PIN  
1403.46'

668° 45' 52" E

220.00'




463.39'

275.00'

275.00'

N 54° 00'

E 766.750'

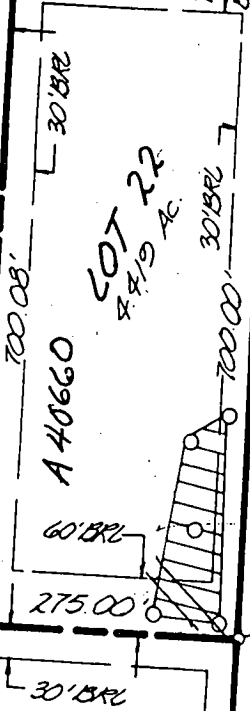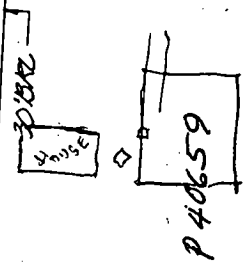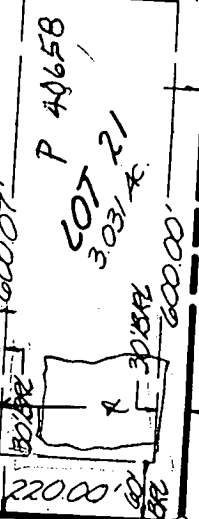

LOT 23  
36.905 Ac

LOT 3  
P.B. 4704  
WILLIS L. CARREL JR.

1" = 200'

WILLIS L. CARREL JR.  
820/675

26" W