

2-12' Level  
50 ft apart  
2-12' Level  
50 ft apart  
11/17/74  
1:30  
9-230

# APPLICATION

A 19637

## SEWAGE DISPOSAL TESTING

STATE OF MARYLAND · DEPARTMENT OF HEALTH AND MENTAL HYGIENE

HOWARD COUNTY HEALTH DEPARTMENT  
ENVIRONMENTAL HEALTH SERVICES  
P. O. BOX 476, ELLICOTT CITY, MARYLAND 21043  
TELEPHONE: 465-5000, EXT. 356

4 BEDROOMS

DISTRICT 1

1250 gal tank

DATE 3/1/74

new trench  
2-12' Level  
50 ft apart  
11/17/74  
1:30

OK lower 3 or 3 trenches

DEEP TRENCHES 600 sq ft sewer and  
on one side. Ditch to be 7 FT deep  
with 4 FT of stone. 2 FT wide and  
150 ft long

TO: THE COUNTY HEALTH OFFICER  
ELLICOTT CITY, MARYLAND

Place the deep ditch between

I, HEREBY, APPLY FOR THE NECESSARY TEST IN ORDER TO CONSTRUCT (OR RECONSTRUCT) A SEWAGE DISPOSAL SYSTEM.

PROPERTY OWNER

100 FT and 50 FT from the  
lot line which is 427.00 FT long  
Clifford Bobo

ADDRESS Columbia Hills, Ellicott City, Md.

594 472  
PHONE 465-5504

PROPERTY LOCATION:

and runs S 53° 17' 50" E and

SUBDIVISION

Between 30 FT and 13.0 FT from  
4885

ROAD AND DESCRIPTION

Titchester Rd. - see original application for directions

the edge of the dirt road

SIZE OF LOT

Run deep ditch along the side of  
1.948 acres

TYPE BLDG.

3 or 4

IF NOT SINGLE RESIDENCE DESCRIBE

the well

NUMBER OF BEDROOMS  
(Single Fmly. Dwlg.)

THE SYSTEM INSTALLED UNDER THIS APPLICATION IS ACCEPTABLE ONLY UNTIL PUBLIC FACILITIES BECOME AVAILABLE.

\* all for inspection of trench before gravel  
is installed

SIGNATURE OF APPLICANT

Clifford Bobo

APPROVED BY

Raymond Noble

FOR

Deep Ditch

DATE

11/1/74

REJECTED BY

FOR

DATE

HOLD PENDING FURTHER TESTS

DATE


REASONS FOR REJECTION OR HOLDING

11/15/74 Held for

Review with DM & FF

Decided deep ditch needed R/I

# THIS IS NOT A PERMIT

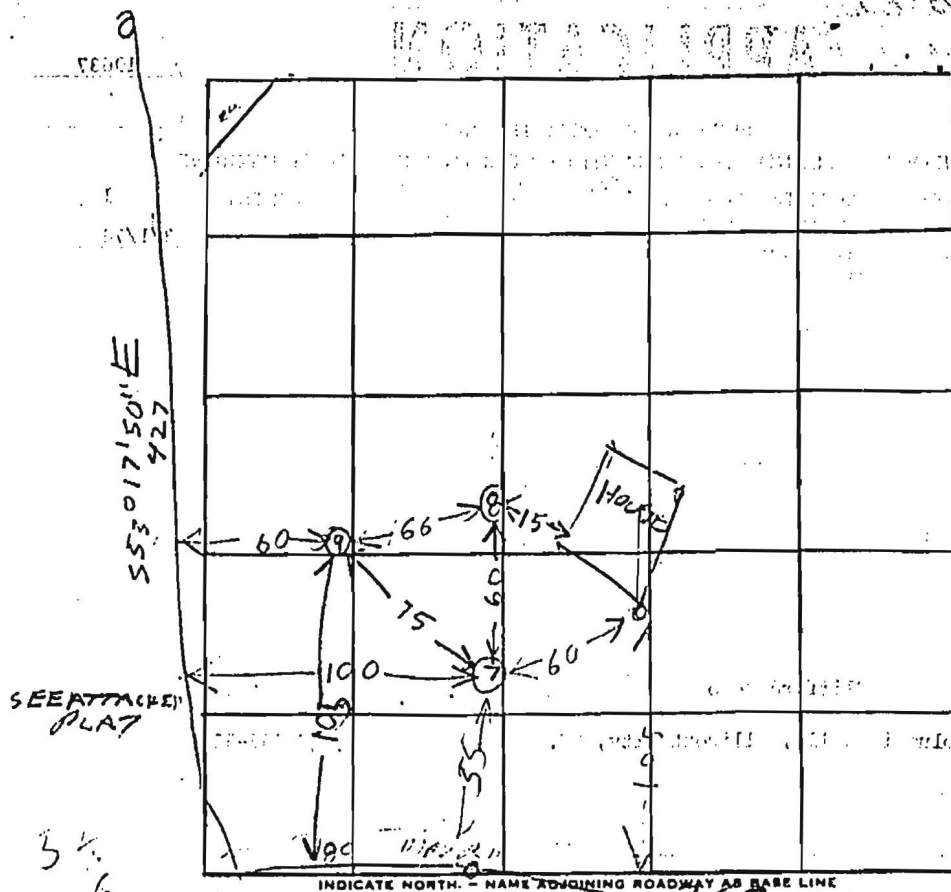

ALL SAND & SANDSTONE

DATE	TEST NO.	DEPTH	PRE-WET		TEST - 1" DROP		TIME
			START	STOP	START	STOP	
11/14/72	* 7	9	247	248	248	249	15
	7A	4	251	309	309	334	26
	8	7	TOP 4 FEET SAND		BOT 3 FEET ROCK		
	* 9	11	354	422	422	452	6
11/15/74	9A	4 1/2	400	407	407	424	17

STICK 1/2" SUNK IN SOIL COULD NOT GET ACCURATE TIME

REMARKS \*7 = COULD ONLY DIG 9 FT SANDSTONE BOTTOM  
 \*9 = TIME NOT RIGHT. MEASURED WATER LEVEL AT END  
 TYPE OF SOIL WATER DROPPED 5 INCHES IN 9 MIN = 1 INCH PER 12 MIN  
 TESTED BY Raymond Hodge ALSO PRESENT: DICK LOWE C. BOBO