

LAYOUT _____ INSP 4 _____
INSP 2 _____ INSP 5 _____
INSP 3 _____ INSP 6 _____

ISSUE DATE: 10/29/03

APPROVAL DATE: _____

PERMIT INDEXED

P _____

A 519642-A

ON-SITE SEWAGE DISPOSAL SYSTEM HOWARD COUNTY HEALTH DEPARTMENT BUREAU OF ENVIRONMENTAL HEALTH

04-336194

IS PERMITTED TO INSTALL ALTER

ADDRESS: _____ PHONE NUMBER: _____

SUBDIVISION: Lisbon Acres LOT NUMBER: 16

ADDRESS: 1208 Round Gate Court PROPERTY OWNER: William Kasda Jr

SEPTIC TANK CAPACITY (GALLONS): _____ OUTLET BAFFLE FILTER REQUIRED

PUMP CHAMBER CAPACITY (GALLONS): _____ COMPARTMENTED TANK REQUIRED

NUMBER OF BEDROOMS: _____

SQUARE FEET PER BEDROOM: _____

LINEAR FEET OF TRENCH REQUIRED: _____

TRENCHES:	Trench to be _____ feet wide. Inlet _____ feet below original grade. Bottom maximum depth _____ feet below original grade. Effective area begins at _____ feet below original grade. _____ feet of stone below distribution pipe.
LOCATION:	
NOTES:	

PLANS APPROVED: _____ DATE: _____

- NOTE: PERMIT VOID AFTER 2 YEARS
- NOTE: CONTRACTOR RESPONSIBLE FOR SCHEDULING A PRE-CONSTRUCTION INSPECTION FOR ALL INSTALLATIONS
- NOTE: WATERTIGHT SEPTIC TANKS REQUIRED
- NOTE: ALL PARTS OF SEPTIC SYSTEM SHALL BE 100 FEET FROM ANY WATER WELL
- NOTE: MANHOLE RISERS REQUIRED ON ALL SEPTIC TANKS AND PUMP CHAMBERS UNLESS SPECIFICALLY AUTHORIZED

**NEITHER THE HOWARD COUNTY COUNCIL NOR THE HEALTH DEPARTMENT IS
RESPONSIBLE FOR THE SUCCESSFUL OPERATION OF ANY SYSTEM
PERMITTEE RESPONSIBLE FOR OBTAINING FINAL APPROVAL ON THIS PERMIT
CALL 410-313-2640 FOR INSPECTION OF SEPTIC SYSTEM**

A 519642-A

Bill ~~Kasada~~ *Kasda*
1208 Roundgate Court
Woodbine, MD 21797

Invoice #: 118547

-----Date-----Terms-----
| 11/25/03 | Net 30
-----P.O. Number-----
|

Description	Amount
11-15-03 1208 Round Gate Ct. Uncovered tank and existing trench Met with county to dig perc test and plan out repair.	0.00 0.00
Dug 1 trench 112 ft long a t 10' bottoms and a 5' inlet. Backfilled septic system.	0.00
Invoice subtotal	0.00
Invoice total	0.00

~~#~~ 9176 12/15/03

=====

JUN 03 2004

RECEIVED




0000

0000

0000

Round Gate

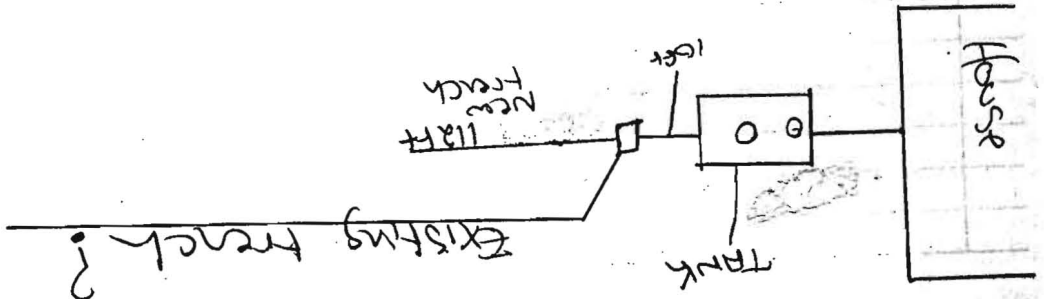

1208 Round Gate Ct

0000