

3/25/79
trench insp.
3/27/79
after lunch

3/23/79 P.S.O. 2078

File

PERMIT

P-29502
A-2078

SEWAGE DISPOSAL SYSTEM
MARYLAND STATE DEPARTMENT OF HEALTH*

HOWARD COUNTY

ELLICOTT CITY

INDEXED

DISTRICT 42b

DATE 2/6/78

William Hopkins

IS PERMITTED TO INSTALL ALTER

ADDRESS _____ PHONE _____

SUBDIVISION Lisbon Acres ROAD 1208 Round Gate Court LOT 16

PROPERTY OWNER Suteraden, Inc. William Kasda # 97

ADDRESS 8003 Woodmont Avenue, Bethesda, Md.

SPECIFICATIONS 3 bedrooms

SEPTIC TANK CAPACITY 1000 GALLONS

DRAIN FIELD _____ DEPTH _____ FEET. BOTTOM AREA _____ SQ. FT.

DEEP TRENCH _____ DEPTH _____ FEET. BOTTOM AREA _____ SQ. FT.

SEEPAGE PITS _____ ABSORBENT SIDE-WALL AREA 150 SQ. FT. per bedroom in system.

INLET PIPE 3 FT. BELOW ORIGINAL GRADE. MAXIMUM DEPTH 9 FT. BELOW ORIGINAL GRADE

EFFECTIVE DEPTH AT _____ FT. BELOW ORIGINAL GRADE.

LOCATE DISPOSAL AREA _____ FT. FROM _____ LOT LINE AND _____ FT. FROM _____ LOT LINE AS SHOWN WHEN FACING LOT FROM

Locate the dry well 120 ft. from the edge of Round Gate Ct. and 15 ft. from the right property line as seen from the court. The trench will begin 5 ft. from the edge of the dry well and will follow the contour of the land. The trench will be constructed 2 ft. wide, 9 ft. deep, contain 6 ft. of stone for an effective sidewall distance of 5 vertical feet.

PLANS APPROVED BY R. Moorefield DATE 1/19/77

COVER NO WORK UNTIL INSPECTED AND APPROVED.

NEITHER THE HOWARD COUNTY COUNCIL NOR THE HEALTH DEPARTMENT IS RESPONSIBLE FOR THE SUCCESSFUL OPERATION OF ANY SYSTEM.

NOTE: IF TRENCH IS USED CALL FOR INSPECTION BEFORE PLACING GRAVEL IN TRENCH.

NOTE: NO DRY WELL SHALL EXCEED 15 FOOT IN DIAMETER.

NOTE: ALL PIPE FROM HOUSE TO DISPOSAL AREA MUST BE CAST IRON.

PERMIT VOID AFTER THREE YEARS

NOTE: INSTALL STAND PIPE ON SEPTIC TANK AND DRY WELL. STAND PIPES MUST BE 8 INCHES IN DIAMETER. CAST IRON, CONCRETE OR TERRA COTTA ACCEPTED.


*INSTALLER IS RESPONSIBLE FOR OBTAINING FINAL APPROVAL ON THIS PERMIT.

MD - 23

BLDG. PERMIT SIGNED
AND RETURNED 2/3/78
Serial # 49888
Addition

BLDG. PERMIT SIGNED
AND RETURNED 4/4/78
Serial # 42497
Family Room + Garage

120918

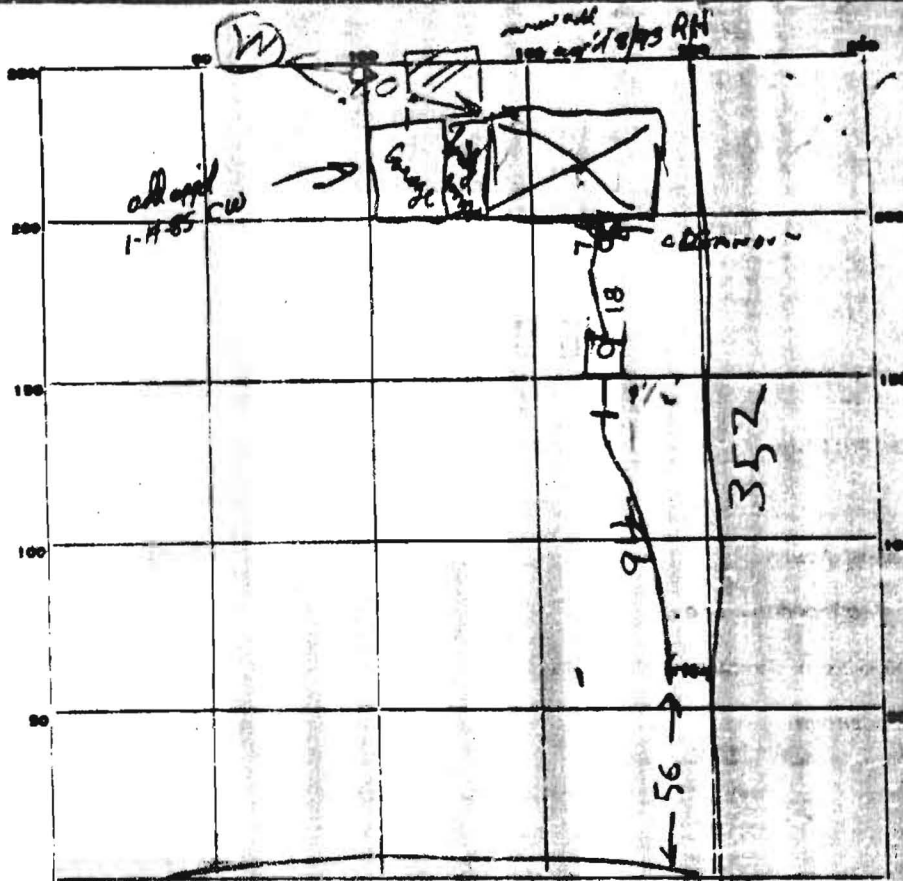

INDICATE NORTH - NAME ADJOINING ROADWAY AS BASE LINE.

ROUND GATE CT

PERMIT CARD

Year of S.T. 3/23/79 3/21/79

SEPTIC TANK, LEVEL

OK 1000

CLEANOUTS

NO

{ 3/27/79 ST 3 }
L 3

DISTRIBUTION BOX, LEVEL

TOP 2 FT BELOW GROUND

TILE FIELD DEPTH

10

FT. TRENCH WIDTH

2

FT.

GRAVEL DEPTH

9"

IN.

TOTAL LENGTH

94

FT.

NUMBER OF TRENCHES

1

TOTAL BOTTOM AREA

SEEPAGE PITS, INSIDE DIAMETER

-

FT.

DEPTH BELOW INLET

-

FT.

ABSORBENT AREA

658

SQ. FT.

REMARKS

3/23/79 - 30R 450 SDF REQUIRED

ADD STONE & PIPE & CLEANOUT & CALL RH

3/23/79 P.M. No change

3/27/79 Payment made

to 3' of surface

C.B.V.

C.B.V.

DATE SYSTEM APPROVED

3/27/79

INSPECTOR

C.B. [Signature]