

PUB. SEWER STATUS VERIFIED BY mll/cornstien

ISSUE DATE: \_\_\_\_\_

# PERMIT

P 519675

APPROVAL DATE: 1/14/04

A REPAIR

## ON-SITE SEWAGE DISPOSAL SYSTEM HOWARD COUNTY HEALTH DEPARTMENT BUREAU OF ENVIRONMENTAL HEALTH

04-321871

Fogles Septic Clean, Inc

IS PERMITTED TO INSTALL  ALTER

ADDRESS: 580 Obrecht Road, Sykesville

PHONE NUMBER: 410-795-5670

SUBDIVISION: \_\_\_\_\_

LOT NUMBER: \_\_\_\_\_

ADDRESS: 2240 Duvall Road

PROPERTY OWNER: Calvin Snyder

SEPTIC TANK CAPACITY (GALLONS):

Existing

PUMP CHAMBER CAPACITY (GALLONS):

N/A

NUMBER OF BEDROOMS:

4

SQUARE FEET PER BEDROOM:

180

LINEAR FEET OF TRENCH REQUIRED:

200

TRENCHES:	Trench to be <u>2</u> feet wide. Inlet <u>6</u> feet below original grade. Bottom maximum depth <u>9.5</u> feet below original grade. Effective area begins at <u>6</u> feet below original grade. <u>3.5</u> feet of stone below distribution pipe.
LOCATION:	
PURPOSE:	Septic system is failing (collapsed dry well). Call for inspection when the ground has been opened so sanitarian can recommend repair.

PLANS APPROVED: \_\_\_\_\_

DATE: \_\_\_\_\_

NOTE: PERMIT VOID AFTER 2 YEARS

NOTE: CONTRACTOR RESPONSIBLE FOR SCHEDULING A PRE-CONSTRUCTION INSPECTION FOR ALL INSTALLATIONS

NOTE: WATERTIGHT SEPTIC TANKS REQUIRED


NOTE: ALL PARTS OF SEPTIC SYSTEM SHALL BE 100 FEET FROM ANY WATER WELL

NOTE: MANHOLE RISERS REQUIRED ON ALL SEPTIC TANKS AND PUMP CHAMBERS

**NEITHER THE HOWARD COUNTY COUNCIL NOR THE HEALTH DEPARTMENT IS RESPONSIBLE FOR THE SUCCESSFUL OPERATION OF ANY SYSTEM PERMITTEE RESPONSIBLE FOR OBTAINING FINAL APPROVAL ON THIS PERMIT CALL 410-313-2640 FOR INSPECTION OF SEPTIC SYSTEM**

519675

NOT TO SCALE

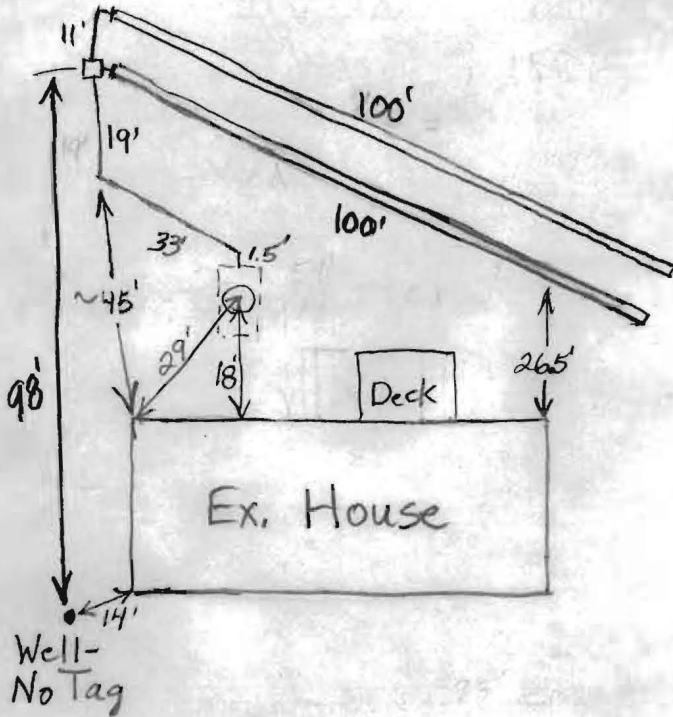

**TRENCH/DRAINFIELD DATA**

WIDTH	INLET	BOTTOM
<u>2</u>	<u>6</u>	<u>9.5+</u>
NUMBER OF TRENCHES		<u>2</u>
TOTAL LENGTH		<u>200</u>
ABSORPTION AREA		<u>700</u>
DISTRIBUTION BOX LEVEL		<u>Not Checked</u>
DISTRIBUTION BOX BAFFLE		<u>Yes</u>
DISTRIBUTION BOX PORT		<u>No</u>

**SEPTIC TANK DATA**

SEPTIC TANK 1 LEVEL	_____
CAPACITY	<u>Existing</u> GAL
SEAM LOC	_____
TANK LID DEPTH	_____
BAFFLES	_____
BAFFLE FILTER	<u>Yes</u>
MANHOLE LOC	_____
6" PORT LOC	_____
WATERTIGHT TEST	_____
SEPTIC TANK 2 LEVEL	<u>N/A</u>
CAPACITY	_____ GAL
SEAM LOC	_____
TANK LID DEPTH	_____
BAFFLES	_____
BAFFLE FILTER	_____
MANHOLE LOC	_____
6" PORT LOC	_____
WATERTIGHT TEST	_____

Duvall

ROAD

PRE-CONSTRUCTION 11/24/03 Test hole had fairly deep clay layer. To install a distribution box and 2-100' trenches on  
 INSTALLATION contour off of a distribution box. Trench inlet 6', bottom depth 9.5', 2' wide trenches. (BB)  
1/14/04 System Finished. O.K. to cover everything. (BB)

FINAL INSPECTOR B. Baker

DATE OF APPROVAL 1/14/04