

APPLICATION

SEWAGE DISPOSAL TESTING

STATE OF MARYLAND - DEPARTMENT OF HEALTH AND MENTAL HYGIENE

HOWARD COUNTY HEALTH DEPARTMENT
ENVIRONMENTAL HEALTH SERVICES
P O BOX 476, ELLICOTT CITY, MARYLAND 21043
TELEPHONE 465-6666, EXT 396

A

P

DISTRICT

DATE 8/29/74

TO THE COUNTY HEALTH OFFICER
ELLICOTT CITY, MARYLAND

I HEREBY APPLY FOR THE NECESSARY TEST IN ORDER TO CONSTRUCT (OR RECONSTRUCT) A SEWAGE DISPOSAL SYSTEM.

PROPERTY OWNER Phillip H. & Thelma R. Johnson, Sr.

ADDRESS 4357 Hollins Ferry Road, Landover, MD 21227 PHONE 242-2492

PROPERTY LOCATION

SUBDIVISION Old Frederick Road LOT NO 20

ROAD AND DESCRIPTION Road 99 - road next to St. James Methodist Church

SIZE OF LOT 5.000 acres TYPE BLDG.

IF NOT SINGLE RESIDENCE DESCRIBE NUMBER OF BEDROOMS
(Include Pkwy, Driv., etc.)

THE SYSTEM INSTALLED UNDER THIS APPLICATION IS ACCEPTABLE ONLY UNTIL PUBLIC FACILITIES BECOME AVAILABLE.

SIGNATURE OF APPLICANT Phillip H. Johnson Sr.

APPROVED BY FOR DATE
(KIND OF SYSTEM)

REJECTED BY FOR DATE
(KIND OF SYSTEM)


HOLD PENDING FURTHER TESTS DATE

REASONS FOR REJECTION OR HOLDING

THIS IS NOT A PERMIT

290

20986

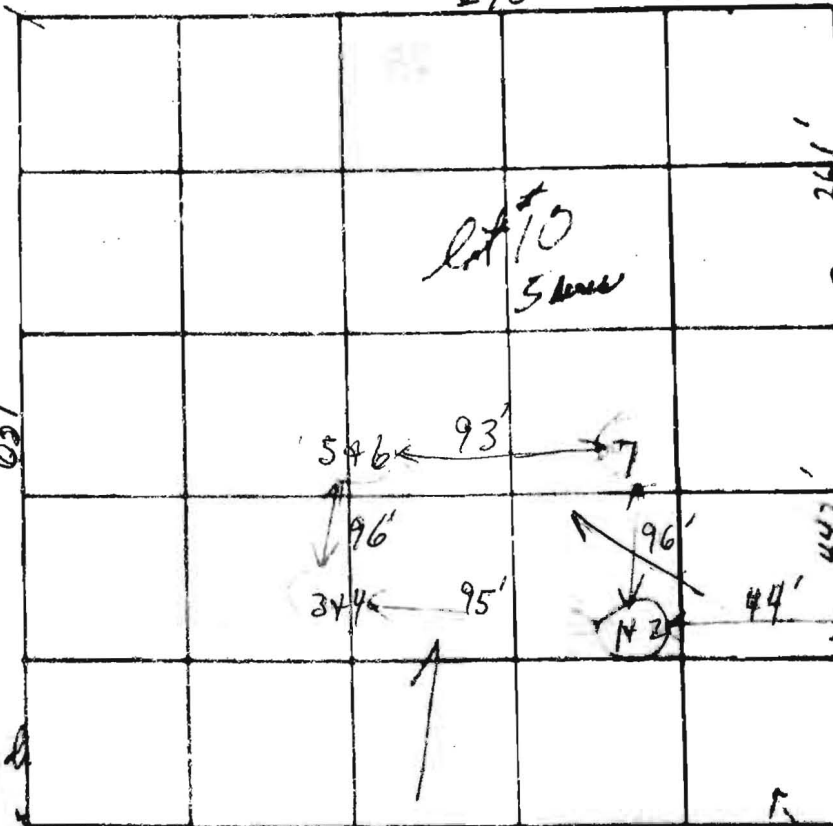

St. James Meth. Church

Property adj. to St. James Meth. Church

INDICATE NORTH NAME ADJOINING ROADWAY AS CASE 1 OR (O. Post, Pl.) 363' 2399

DATE	TEST NO	DEPTH	PRE WT		TEST		TIME	
			START	STOP	START	STOP		
9/23/74	1	2 1/2'	10:02	10:08	10:08	10:13	5m	
	(H) 2	11'	10:11	10:14	10:14	10:17	3m	
	3		Soil changes at 4 1/2'					
	(L) 4	11'	10:10	10:14	10:01	10:06	2m	
	5	11'	9:52	9:58	9:58	10:02	4m	
	6	4'	10:20	10:20	10:00	10:21	21m	
	7	11'	Various	Various		5/35		

7 min avg

REMARKS

TYPE OF SOIL

Sandy micaceous

TESTED BY

(11)

ALSO PRESENT

Fyack