



---

DEPARTMENT OF INSPECTIONS, LICENSES & PERMITS

---

*J. Michael Evans, Director*

**CANCELLATION NOTICE**

Date: December 11, 2003

To: (X) Department of Planning and Zoning  
(X) Development Engineering  
(X) Health Department  
(X) Building Contactor  
(X) Owner

Re: Canceled and/or Expired Permit/Application

Permit Number: B00138653

Date of Issue: Not Issued

Owner: Floyd N. Cagle

Contractor: Floyd N. Cagle

Location: 12510 Old Frederick Rd.

Description of Work: 3 car garage detached one story


Reason for Cancellation: Cancel per letter from the owner received December 3, 2003. Changing use and location of building.

From:

---

Avis L. Corbin, Chief  
Licenses and Permits Division  
Phone Number: (410)313-2455

ALC/tl

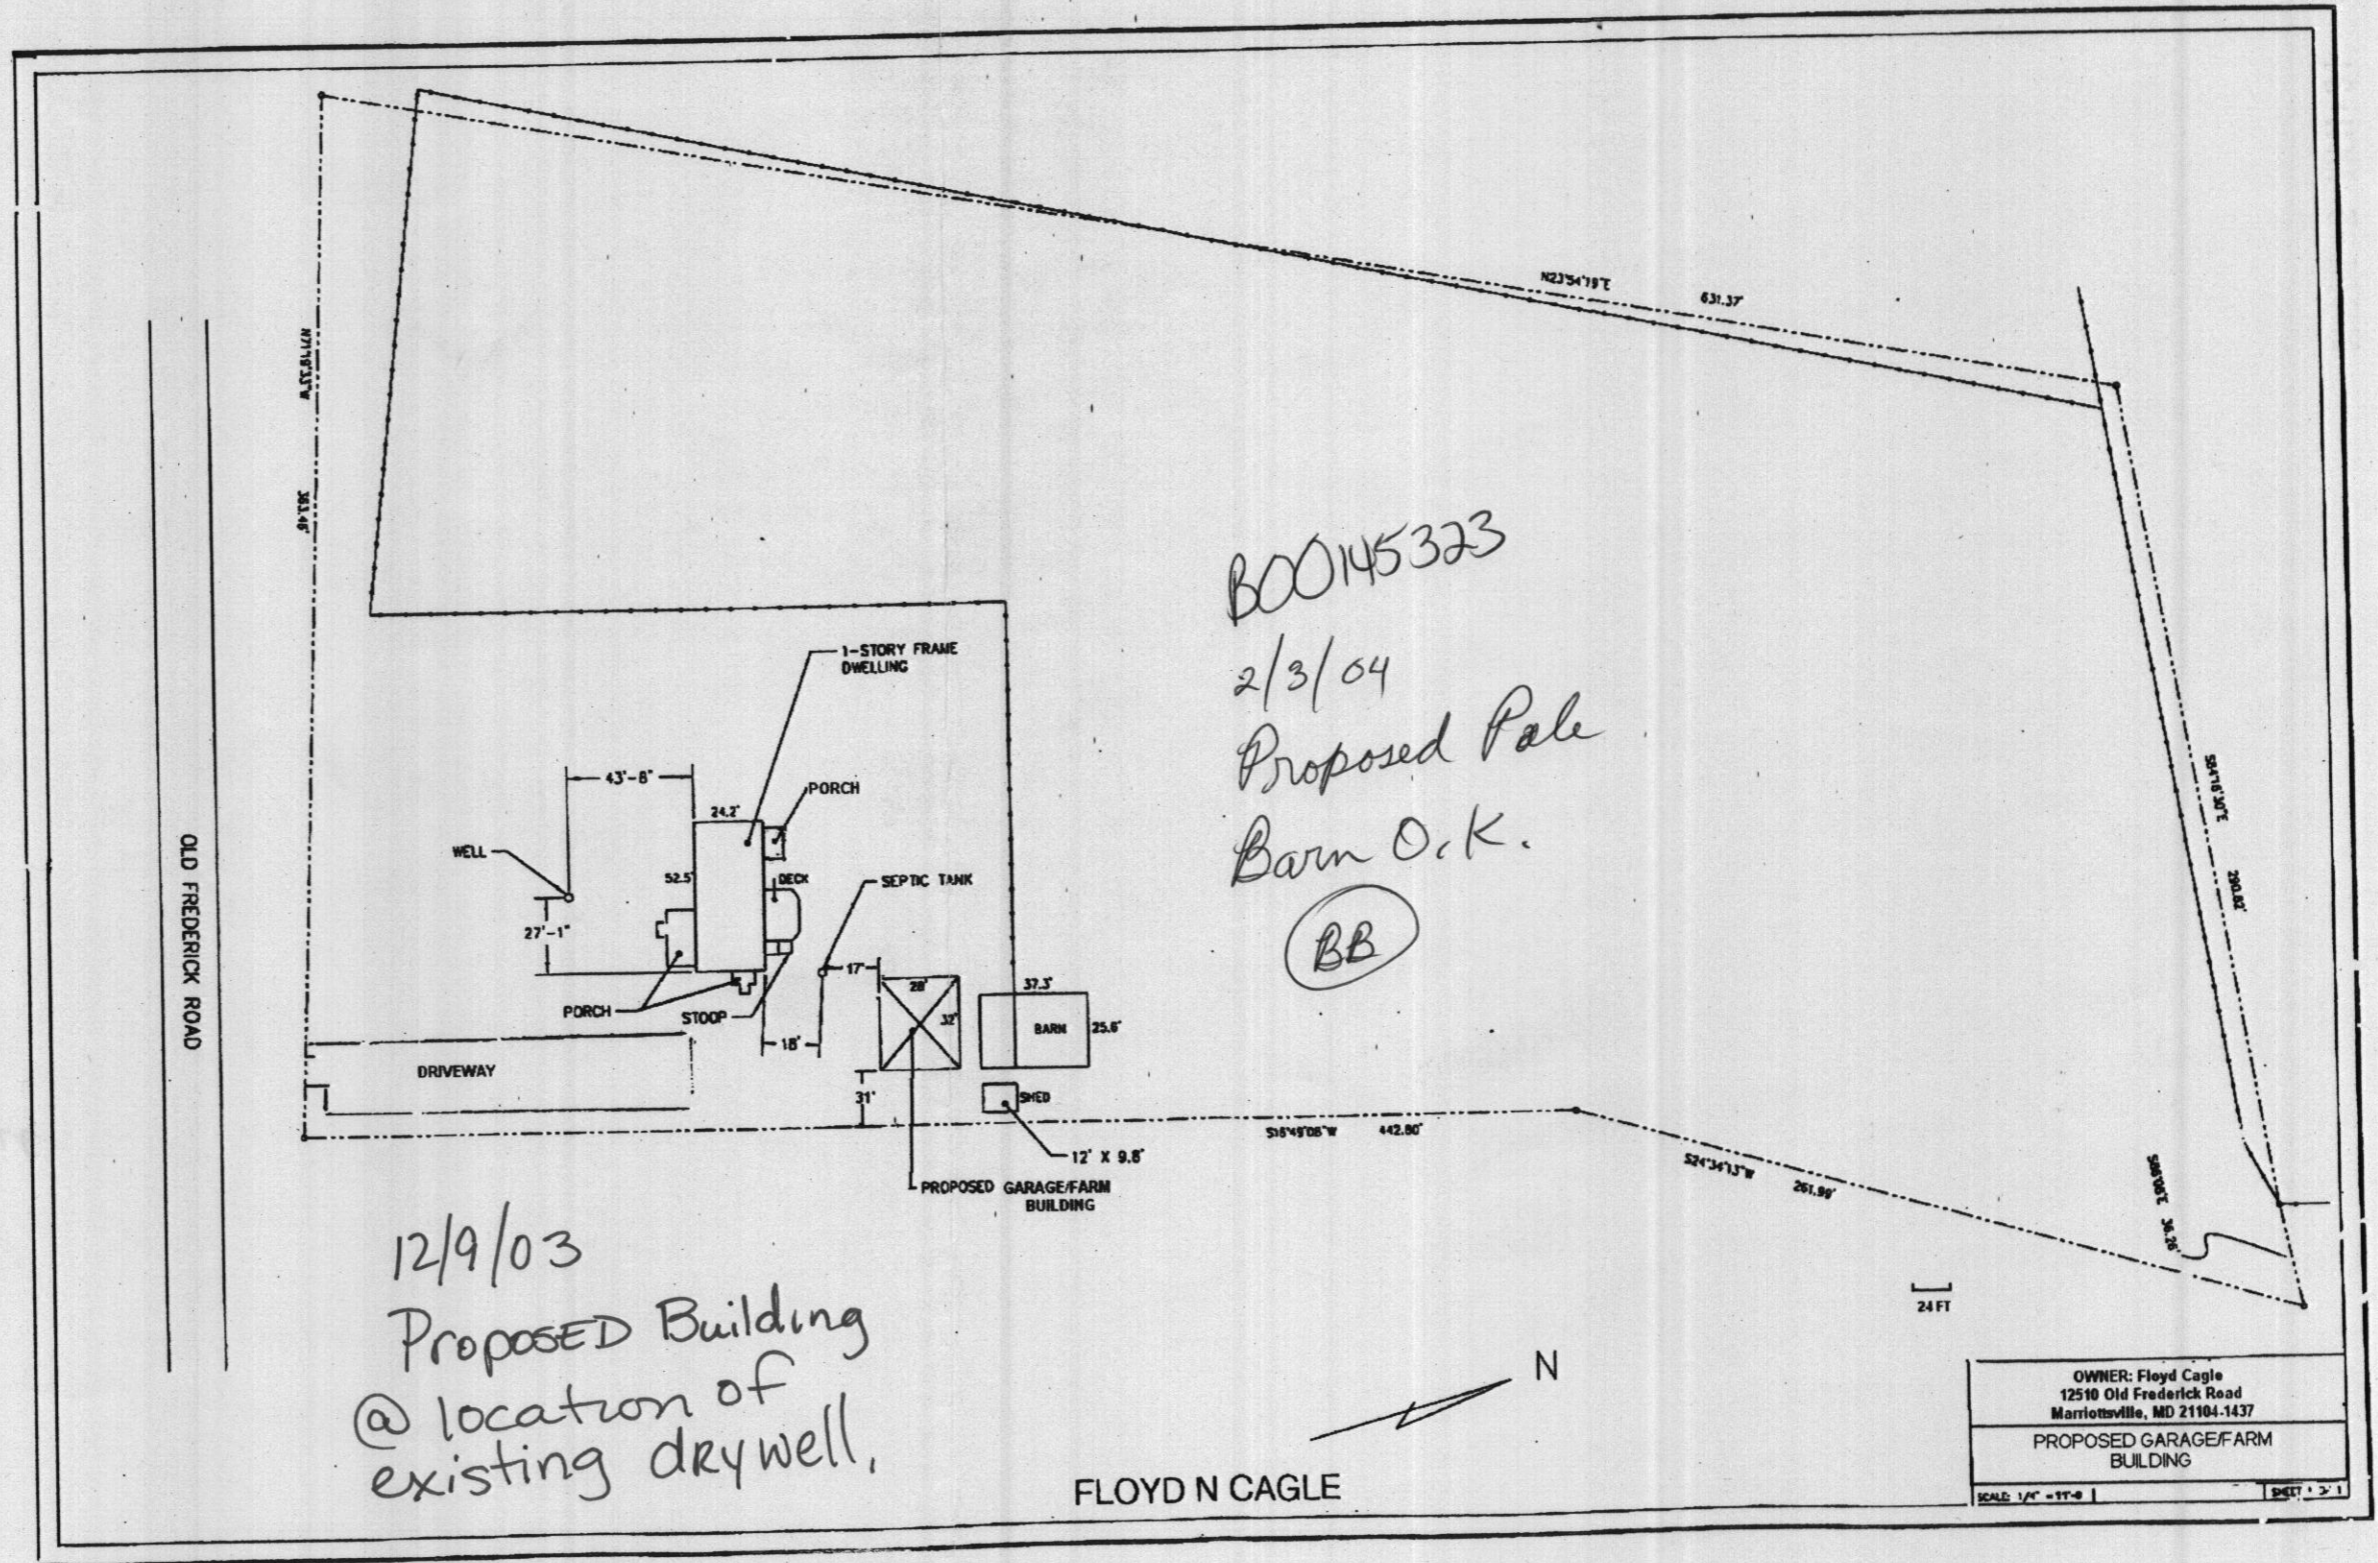

B000145323  
 2/3/04  
 Proposed Pole  
 Barn O.K.  
 (BB)

12/9/03  
 Proposed Building  
 @ location of  
 existing drywell.

Relocate Garage

FLOYD N CAGLE

OWNER: Floyd Cagle  
 12510 Old Frederick Road  
 Marriottsville, MD 21104-1437  
 PROPOSED GARAGE/FARM  
 BUILDING  
 SCALE 1/4" = 10'-0"