

# APPLICATION

A 38671

## SEWAGE DISPOSAL TESTING

STATE OF MARYLAND - DEPARTMENT OF HEALTH AND MENTAL HYGIENE

P \_\_\_\_\_

HOWARD COUNTY HEALTH DEPARTMENT  
ENVIRONMENTAL HEALTH SERVICES  
P. O. BOX 476 ELLICOTT CITY, MARYLAND 21043  
TELEPHONE: 992-2330

DISTRICT 4TH

DATE 2/9/87

TO: THE COUNTY HEALTH OFFICER  
ELLICOTT CITY, MARYLAND

I, HEREBY, APPLY FOR THE NECESSARY TEST IN ORDER TO CONSTRUCT (OR RECONSTRUCT) A SEWAGE DISPOSAL SYSTEM.

PROPERTY OWNER WAYNE C. HOUGH James Feaga. 795-8580  
17740 HARDY RD. PHONE W-235-1536  
MT. AIRY, MD. 21771 H-795-6987

PROPERTY LOCATION:  
SUBDIVISION Hough Property 17590 Hardy Rd. LOT NO. 7

ROAD AND DESCRIPTION North side of Hardy Road, 1420' ± east of Log  
Corner Road.

SIZE OF LOT 3 Acre minimum TYPE BLDG. 3  
(NUMBER OF BEDROOMS)

THE SYSTEM INSTALLED UNDER THIS APPLICATION IS ACCEPTABLE ONLY UNTIL PUBLIC FACILITIES BECOME AVAILABLE. I FULLY UNDERSTAND THE FEE CONNECTED WITH THE FILING OF THIS PERC TEST APPLICATION IS NON-REFUNDABLE UNDER ANY CIRCUMSTANCES. I ALSO AGREE TO COMPLY WITH ALL M.O.S.H.A. REQUIREMENTS IN TESTING THIS LOT.

Way C Hough  
(SIGNATURE OF APPLICANT)

APPROVED BY Sally Abel FOR Deep trenches DATE 4-27-89

REJECTED BY \_\_\_\_\_ FOR \_\_\_\_\_ DATE \_\_\_\_\_

HOLD PENDING FURTHER TESTS \_\_\_\_\_ DATE \_\_\_\_\_

REASONS FOR REJECTION OR HOLDING 5-13-87 Rec. Satisfactory, Hold for Plat. SAbel

BOG. PERMIT SIGNED  
AND RETURNED 7-27-89  
BP24993 S-Abel

# THIS IS NOT A PERMIT


① → ④  
SOIL PROFILE

14'-  
0"  
3.5'  
4.5'-  
13'-

**AP**  
Yellow BR  
Silt CLAY  
LOAM 15-20%  
CLAY 15-25%  
FRAGS

RED BR  
Silt LOAM  
25-35%  
FRAGS

MASSIVE  
SAPROLITE

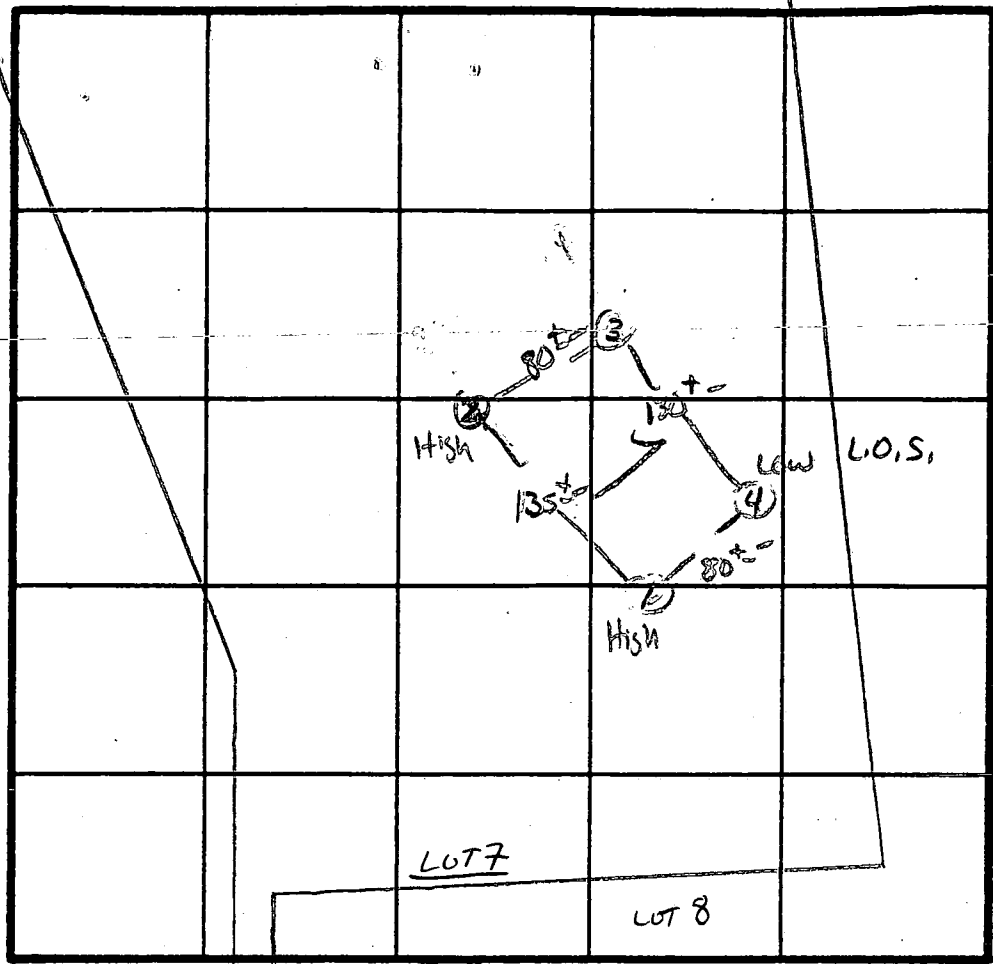

INDICATE NORTH - NAME ADJOINING ROADWAY AS BASE LINE.

Hardy Red.

DATE	TEST NO.	DEPTH	PRE-WET		TEST - 1" DROP		TIME
			START	STOP	START	STOP	
5/13/87	1 S	5'	1:32	1:43	1:43	2:00	17 MIN
	1 V	13' UNIFORM SOIL		below	4.5'		
	2 S	3.5'	1:40	1:53	1:53	2:16	23 MIN
	2 M	8'	1:40	1:41	1:41	1:43	
	2 V	12.5 MASSIVE SAPROLITE AT			11'		
	3 S	1:48	1:48	1:50	1:50	1:54	4 MIN
	3 V	12' UNIFORM SOIL		below	3.5'		
	4 V	UNIFORM SOIL below	5'				

REMARKS Holes slightly diff than PLAT

TYPE OF SOIL ME Mry

TESTED BY S. Abel ALSO PRESENT Rocky, Allen Beechhoe

