

# PERMIT

SEWAGE DISPOSAL SYSTEM

MARYLAND STATE DEPARTMENT OF HEALTH

HOWARD COUNTY

## INDEXED

ELLCOTT CITY

DISTRICT 38

DATE 1/6/75

P 21065

A 20406

1/7/75

*File*

Phillip E. Johnson, Sr. Sq.

IS PERMITTED TO INSTALL  ALTER

ADDRESS 4367 Hollins Ferry Road, Baltimore, Md. 21227

PHONE 848-6893

A SEWAGE DISPOSAL SYSTEM LOCATED AT \_\_\_\_\_

SUBDIVISION Ed. Ethel Slack ROAD 12910 Route 99

LOT 19

PROPERTY OWNER Phillip E. Johnson, Sr.

ADDRESS same as above

SPECIFICATIONS 3 bedrooms

DRAIN FIELD \_\_\_\_\_ DEPTH \_\_\_\_\_ FEET, BOTTOM AREA \_\_\_\_\_ SQ. FT.

SEEPAGE PITS \_\_\_\_\_ ABSORBENT SIDE WALL AREA \_\_\_\_\_ SQ. FT.

SEPTIC TANK CAPACITY 1000 GALLONS

FOR GARBAGE GRINDER, INCREASE DISPOSAL AREA 25% & TANK CAPACITY 50%.

OTHER DRY WELL - To have 125 sq. ft. effective absorbent sidewall area per lot. from below inlet. Inlet to be 3 ft. below original grade and minimum depth 11 ft. Locate dry well 45 ft. off right property line and 140 ft. back from right hand corner stake of property line when facing lot from Route 99 (pave hole 1 & 2).

NOTE: ALL PIPE FROM HOUSE TO DISPOSAL AREA MUST BE CAST IRON.

PERMIT VOID AFTER THREE YEARS.

NOTE: INSTALL STAND PIPE ON SEPTIC TANK AND DRY WELL. SCHED PIPE MUST BE 6 INCHES - CAST IRON, CONCRETE OR TERRA COTTA ACCEPTED.

PLANS APPROVED BY Donald W. Neugebauer


DATE 11/14/74

FILL SEPTIC TANK AND DISTRIBUTION BOX WITH WATER BEFORE CALLING FOR AN INSPECTION. COVER NO WORK UNTIL INSPECTED AND APPROVED.

NEITHER THE HOWARD COUNTY COMMISSIONERS NOR THE HEALTH DEPARTMENT IS RESPONSIBLE FOR THE SUCCESSFUL OPERATION OF ANY SYSTEM.

A 20486

20700

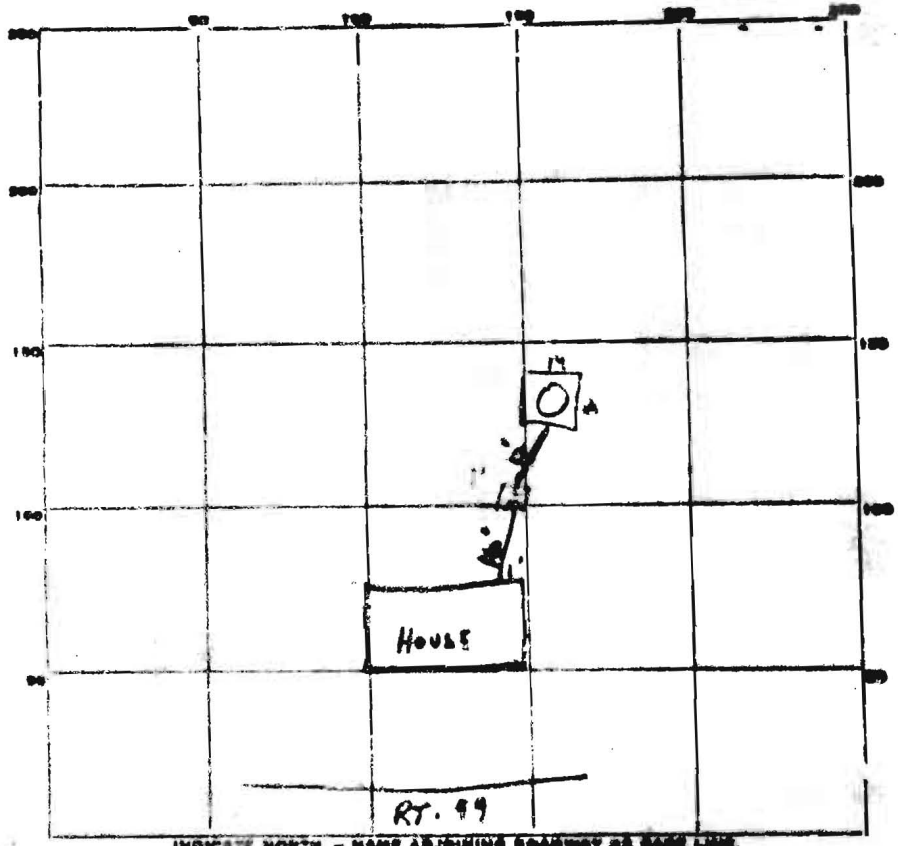

PERMIT CARD 504 4 Spool

SEPTIC TANK LEVEL 1011 gal CLEANOUTS OK

DISTRIBUTION BOX LEVEL \_\_\_\_\_

TILE FIELD DEPTH \_\_\_\_\_ FT. TRENCH WIDTH \_\_\_\_\_ FT.

GRAVEL DEPTH \_\_\_\_\_ IN. TOTAL LENGTH \_\_\_\_\_ FT.

NUMBER OF TRENCHES \_\_\_\_\_ TOTAL BOTTOM AREA \_\_\_\_\_

BEEPAGE PITS. 14 14 FT. DEPTH BELOW INLET 9 FT.

ABSORBENT AREA 604 SQ. FT.

REMARKS \_\_\_\_\_  
\_\_\_\_\_  
\_\_\_\_\_  
\_\_\_\_\_  
\_\_\_\_\_

DATE SYSTEM APPROVED 1-6-25 INSPECTOR Robert Tove