

PUB. SEWER STATUS VERIFIED BY N/A

P 519686

ISSUE DATE: 12/3/03

P paid

APPROVAL DATE: 1/13/04

A REPAIR

# PERMIT INDEXED

## ON-SITE SEWAGE DISPOSAL SYSTEM HOWARD COUNTY HEALTH DEPARTMENT BUREAU OF ENVIRONMENTAL HEALTH

03-286622

Jack Fyock Septic Service

IS PERMITTED TO INSTALL  ALTER

ADDRESS: PO Box 89, Glenelg PHONE NUMBER: 410-988-9270

SUBDIVISION: Timberleigh LOT NUMBER: 7 - Block B

ADDRESS: 3872 Folly Quarter Road PROPERTY OWNER: Evelyn Hanna

SEPTIC TANK CAPACITY (GALLONS): 1000

PUMP CHAMBER CAPACITY (GALLONS): N/A

NUMBER OF BEDROOMS: 3

SQUARE FEET PER BEDROOM: 180

LINEAR FEET OF TRENCH REQUIRED: 70'

TRENCHES:	Trench to be <u>3</u> feet wide. Inlet <u>1.5</u> feet below original grade. Bottom maximum depth <u>6</u> feet below original grade. Effective area begins at <u>1.5</u> feet below original grade. <u>4.5</u> feet of stone below distribution pipe.
LOCATION:	<u>(2) 35' trenches 10' OTC</u> <u>Over pipe (D)</u>
PURPOSE:	Septic system is failing. Call for inspection when the ground has been opened so sanitarian can recommend repair.

PLANS APPROVED: [Signature]


DATE: 12/3/03

- NOTE: PERMIT VOID AFTER 2 YEARS
- NOTE: CONTRACTOR RESPONSIBLE FOR SCHEDULING A PRE-CONSTRUCTION INSPECTION FOR ALL INSTALLATIONS
- NOTE: WATERTIGHT SEPTIC TANKS REQUIRED
- NOTE: ALL PARTS OF SEPTIC SYSTEM SHALL BE 100 FEET FROM ANY WATER WELL
- NOTE: MANHOLE RISERS REQUIRED ON ALL SEPTIC TANKS AND PUMP CHAMBERS

**NEITHER THE HOWARD COUNTY COUNCIL NOR THE HEALTH DEPARTMENT IS  
RESPONSIBLE FOR THE SUCCESSFUL OPERATION OF ANY SYSTEM  
PERMITTEE RESPONSIBLE FOR OBTAINING FINAL APPROVAL ON THIS PERMIT  
CALL 410-313-2640 FOR INSPECTION OF SEPTIC SYSTEM**

P519686

NOT TO SCALE

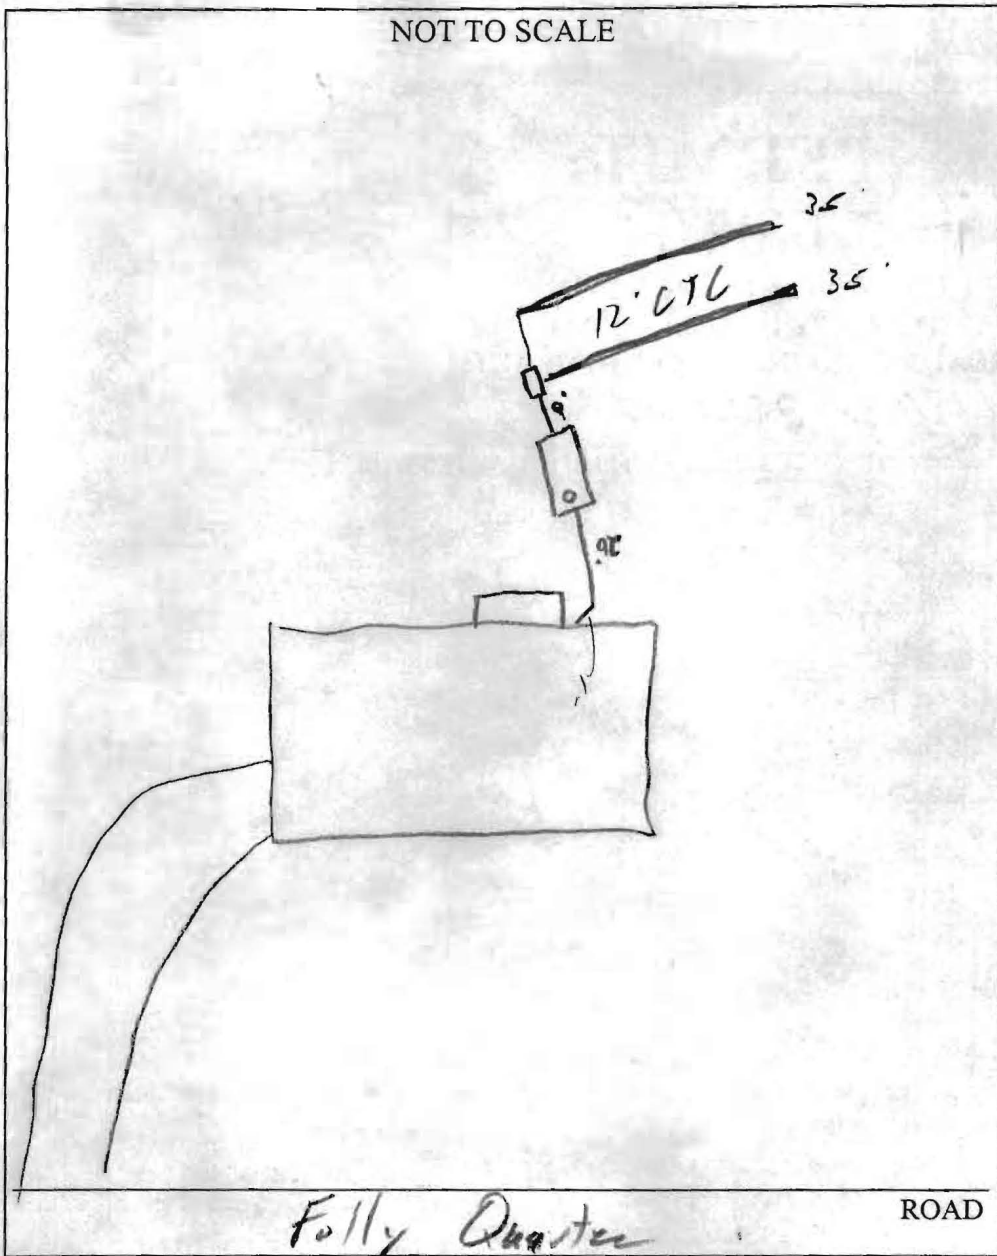

**TRENCH/DRAINFIELD DATA**

WIDTH	INLET	BOTTOM
3	1.5	6"
NUMBER OF TRENCHES		2
TOTAL LENGTH		70'
ABSORPTION AREA		
DISTRIBUTION BOX LEVEL		<input checked="" type="checkbox"/>
DISTRIBUTION BOX BAFFLE		<input checked="" type="checkbox"/>
DISTRIBUTION BOX PORT		

**SEPTIC TANK DATA**

SEPTIC TANK 1 LEVEL		<input checked="" type="checkbox"/>
CAPACITY	1000	GAL
SEAM LOC	Top	
TANK LID DEPTH	2-3'	
BAFFLES		<input checked="" type="checkbox"/>
BAFFLE FILTER		<input type="checkbox"/>
MANHOLE LOC		<input type="checkbox"/>
6" PORT LOC	Front	
WATERTIGHT TEST		<input type="checkbox"/>
SEPTIC TANK 2 LEVEL		
CAPACITY		GAL
SEAM LOC		
TANK LID DEPTH		
BAFFLES		<input checked="" type="checkbox"/>
BAFFLE FILTER		<input checked="" type="checkbox"/>
MANHOLE LOC		<input type="checkbox"/>
6" PORT LOC		<input type="checkbox"/>
WATERTIGHT TEST		<input type="checkbox"/>

PRE-CONSTRUCTION \_\_\_\_\_

INSTALLATION 1/13/04 - Installed per specs. OK to Cover

FINAL INSPECTOR [Signature]

DATE OF APPROVAL 1/13/04