

LAYOUT 1/9/04 INSP 4 \_\_\_\_\_  
 INSP 2 1/13/04 INSP 5 \_\_\_\_\_  
 INSP 3 \_\_\_\_\_ INSP 6 \_\_\_\_\_

ISSUE DATE: 12/15/2003

APPROVAL DATE: 1/15/04

**PERMIT  
INDEXED**

P 519700-A

A 513646-UU

**ON-SITE SEWAGE DISPOSAL SYSTEM  
HOWARD COUNTY HEALTH DEPARTMENT  
BUREAU OF ENVIRONMENTAL HEALTH**

**05-435048**

Fogles Septic Clean, Inc IS PERMITTED TO INSTALL  ALTER

ADDRESS: 580 Obrecht Road, Sykesville PHONE NUMBER: 410-795-5670

SUBDIVISION: Pindell Woods LOT NUMBER: 47

ADDRESS: 11602 Pindell Woods Drive PROPERTY OWNER: Dale Thompson Builders

SEPTIC TANK CAPACITY (GALLONS): 1250 OUTLET BAFFLE FILTER REQUIRED

PUMP CHAMBER CAPACITY (GALLONS): N/A COMPARTMENTED TANK REQUIRED

NUMBER OF BEDROOMS: 4

SQUARE FEET PER BEDROOM: 180

LINEAR FEET OF TRENCH REQUIRED: 240 HOUSE SERVED BY PUBLIC WATER

TRENCHES:	Trench to be 3.0 feet wide. Inlet 3.5 feet below original grade. Bottom maximum depth 5.5 feet below original grade. Effective area begins at 4.0 feet below original grade. 2.0 feet of stone below distribution pipe.
LOCATION:	Place the distribution box in the middle of the top of the septic easement. Run trenches on contour in both directions.
NOTES:	

PLANS APPROVED: Brian Baker 12/15/03 OK (BB) DATE: 7/11/03


NOTES: PERMIT VOID AFTER 2 YEARS  
 CONTRACTOR IS RESPONSIBLE FOR SCHEDULING A PRE-CONSTRUCTION INSPECTION FOR ALL INSTALLATIONS  
 WATERTIGHT SEPTIC TANKS REQUIRED  
 ALL PARTS OF SEPTIC SYSTEM SHALL BE 100 FEET FROM ANY WATER WELL UNLESS SPECIFICALLY AUTHORIZED  
 MANHOLE RISERS REQUIRED ON ALL SEPTIC TANKS AND PUMP CHAMBERS UNLESS SPECIFICALLY AUTHORIZED  
 CONTRACTOR RESPONSIBLE FOR COMPLIANCE WITH APPLICABLE REGULATIONS, GUIDELINES AND THE TERMS OF THIS PERMIT

**NEITHER THE HOWARD COUNTY COUNCIL NOR THE HEALTH DEPARTMENT IS RESPONSIBLE FOR THE SUCCESSFUL OPERATION OF ANY SYSTEM  
 BUILDING PERMIT SIGNED AND RETURNED ALL 410-313-2640 FOR INSPECTION OF SEPTIC SYSTEM**

4/20/06 800 159138-DECK

P 519700-A

NOT TO SCALE

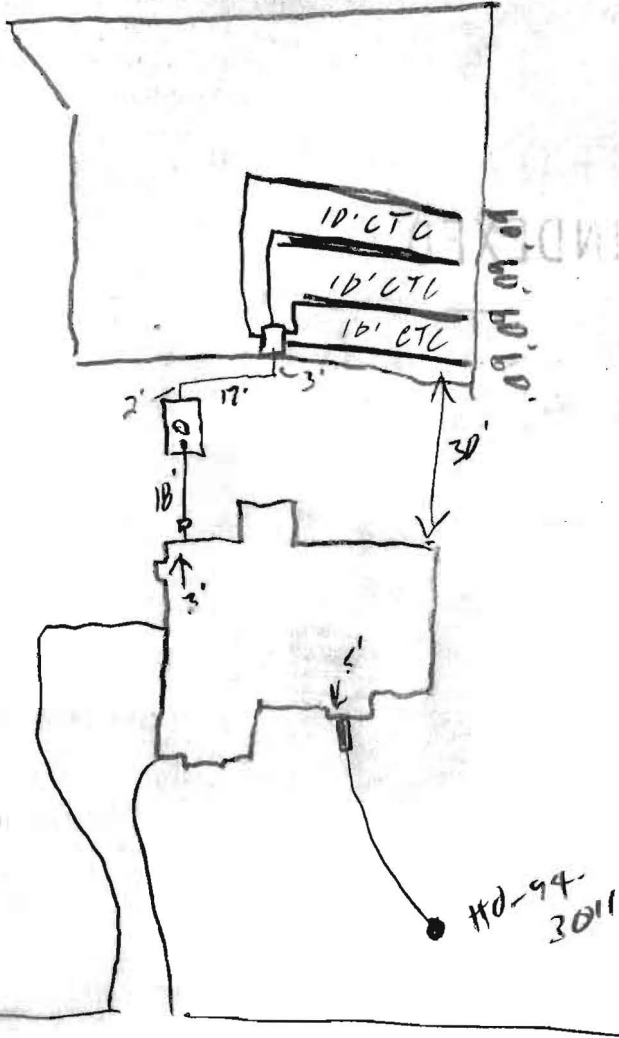

TRENCH/DRAINFIELD DATA		
WIDTH	INLET	BOTTOM
3'	3.5'	5.5'
NUMBER OF TRENCHES		4
TOTAL LENGTH		2.4
ABSORPTION AREA		720
DISTRIBUTION BOX LEVEL		/
DISTRIBUTION BOX BAFFLE		/
DISTRIBUTION BOX PORT		/

SEPTIC TANK DATA	
SEPTIC TANK 1 LEVEL	
CAPACITY	1250 GAL
SEAM LOC	Top
TANK LID DEPTH	1'
BAFFLES	/
BAFFLE FILTER	/
MANHOLE LOC	Center
6" PORT LOC	Front
WATERTIGHT TEST	/
SEPTIC TANK 2 LEVEL	
CAPACITY	_____ GAL
SEAM LOC	_____
TANK LID DEPTH	_____
BAFFLES	_____
BAFFLE FILTER	_____
MANHOLE LOC	_____
6" PORT LOC	_____
WATERTIGHT TEST	_____

ROAD

PRE-CONSTRUCTION 1/9/04 - SRA Staked, Install (4) 60' trenches  
 12' CTC (SO) 1/13/04 - No work (SO)  
 INSTALLATION 1/15/04 - OK to cover all work (SO)


BUILDING PERMIT SIGNED AND RETURNED

FINAL INSPECTOR [Signature] DATE OF APPROVAL 1/15/04

12/15/03  
 House Location  
 O.K. Well Location  
 Not Consistent with  
 Well Completion Report.  
 Not Accepted  
 (BB)

12/17/03  
 Talked to  
 Eric Marks  
 & Marks  
 + Assoc.  
 He said  
 well was  
 field  
 located.  
 Wall Check  
 Acceptable.  
 Faxed Him  
 Copy of Memo  
 (BB)

(410) 747-8738  
 Eric

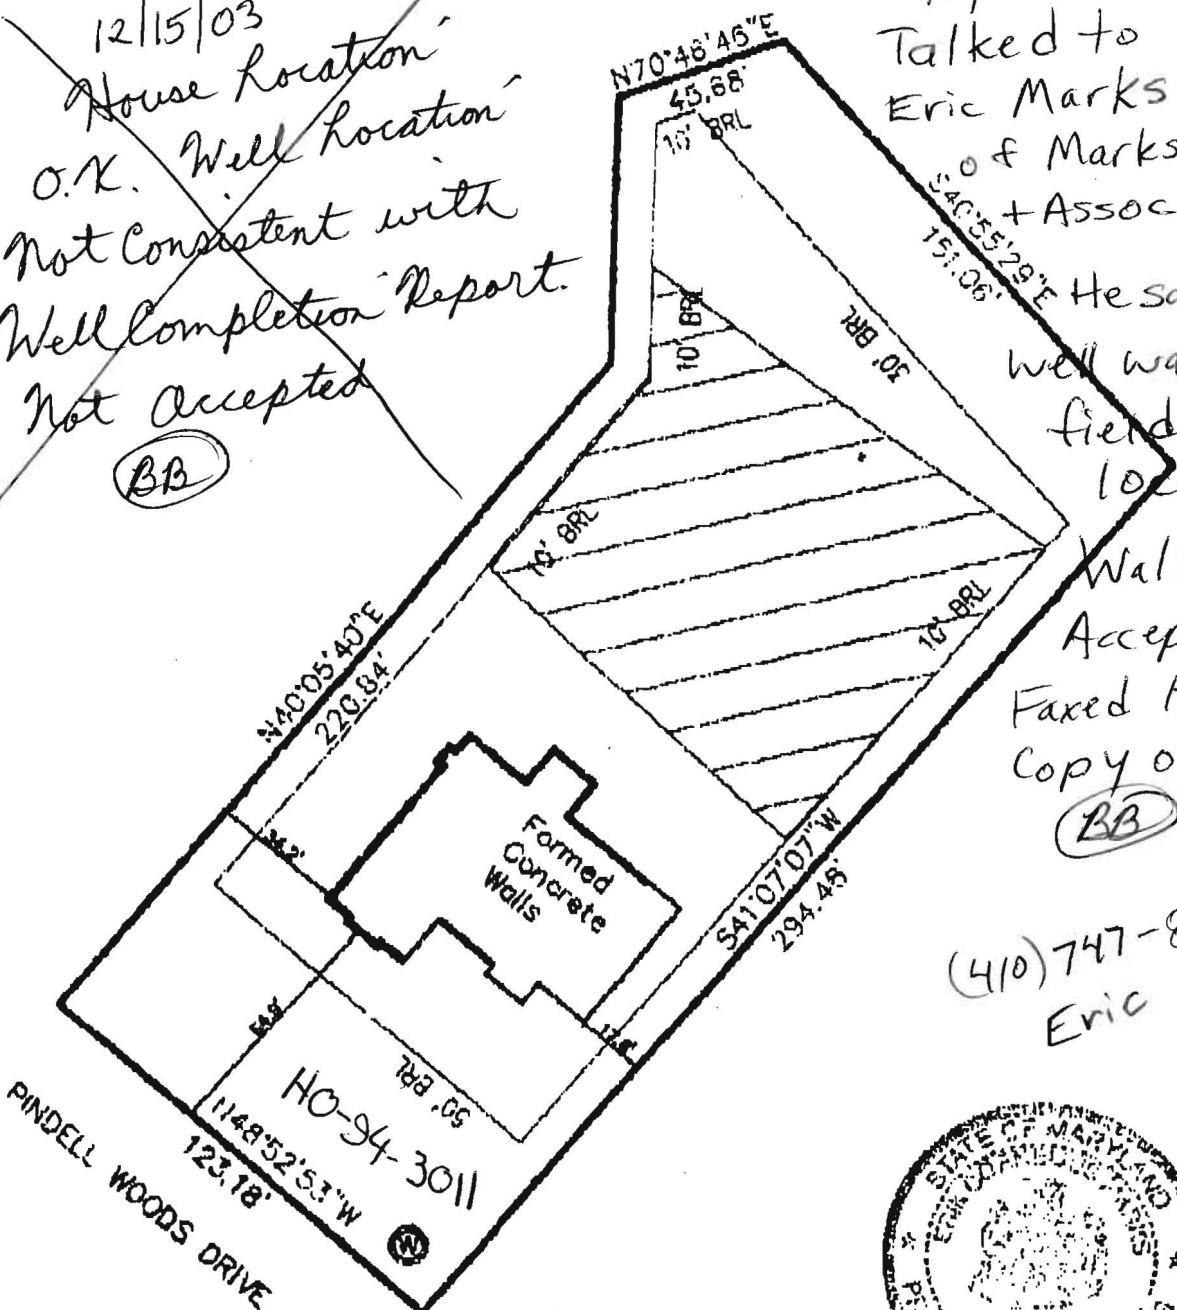

MD. STATE GRID MERIDIAN



Revised Top of Wall Elev = 475.6'

<p><b>RECORD REFERENCES</b></p> <p>LIBR/FILED _____</p> <p>PLAT BOOK _____</p> <p>PLAT NO./POLID LIBR/FILED _____</p> <p>SCALE 1"=40'</p> <p>DATE 12/28/03</p>	<p><b>WALL CHECK</b></p> <p>LOT 47, Pindell Woods</p> <p>HOWARD COUNTY, MARYLAND</p>	<p><b>MARKS &amp; ASSOCIATES L.L.C.</b></p> <p>ENGINEERING - SURVEYING - LAND PLANNING</p> <p>4501 COLLEGE AVENUE BELLESCOTT CITY, MARYLAND</p> <p>TELEPHONE (410) 747-8738 FAX (410) 747-8739</p> <p>I HEREBY CERTIFY, THAT THE IMPROVEMENTS ARE LOCATED AS SHOWN HEREON AND TO THE BEST OF MY KNOWLEDGE AND BELIEF, THERE ARE NO ENCROACHMENTS EXCEPT AS SHOWN.</p> <p>ERIC C. MARKS P.E. 138</p>
--	--	---



REVISED 8.05.03- HOUSE MOVED 10.00' @ BRG 48°54' 20"

# PLOT PLAN

SINGLE FAMILY DWELLING  
the NEWMAN Residence

LOT 47  
PINDELL WOODS  
HOWARD COUNTY, MARYLAND

DATE: AUGUST 5, 2003  
SCALE: 1" = 50'

OWNER/BUILDER:  
DALE THOMPSON BUILDERS  
6300 WOODSIDE COURT  
COLUMBIA, MD 21046  
410-995-6736

<b>PROPOSED ELEVATIONS:</b>	
BASEMENT:	466.90
FIRST FLOOR:	476.00
INVERT OUT OF HOUSE:	468.50
INVERT INTO TANK:	468.00
INVERT INTO DISTRIBUTION BOX:	466.00
INVERT INTO TRENCHES:	465.50
GRADE AT SEPTIC TANK:	471.00
GRADE AT DISTRIBUTION BOX:	469.00
GRADE AT TRENCHES:	468.68
<b>PAVING SPECIFICATIONS:</b>	
2" ASPHALT OVER 4" CR-6 OR	
2.5" ASPHALT OVER 1.5" OVERLAY	