

# APPLICATION

A 19869

## SEWAGE DISPOSAL TESTING

P \_\_\_\_\_

STATE OF MARYLAND - DEPARTMENT OF HEALTH AND MENTAL HYGIENE

HOWARD COUNTY HEALTH DEPARTMENT  
ENVIRONMENTAL HEALTH SERVICES  
P. O. BOX 476, ELLICOTT CITY, MARYLAND 21043  
TELEPHONE: 485-5000, EXT. 336

DISTRICT 3rd

DATE 4/26/74

TO: THE COUNTY HEALTH OFFICER  
ELLICOTT CITY, MARYLAND

I, HEREBY, APPLY FOR THE NECESSARY TEST IN ORDER TO CONSTRUCT (OR RECONSTRUCT) A SEWAGE DISPOSAL SYSTEM.

PROPERTY OWNER Bradley T. J. Mettee, Jr.

ADDRESS 1906 Cedar Circle, Balto., Md. 21228 PHONE 744-2660

PROPERTY LOCATION:

SUBDIVISION \_\_\_\_\_ LOT NO. 9

ROAD AND DESCRIPTION Mountain View Road

SIZE OF LOT 40,500 sq. ft. ± TYPE BLDG. 3 or 4 bedrooms  
NUMBER OF BEDROOMS \_\_\_\_\_

IF NOT SINGLE RESIDENCE DESCRIBE \_\_\_\_\_

THE SYSTEM INSTALLED UNDER THIS APPLICATION IS ACCEPTABLE ONLY UNTIL PUBLIC FACILITIES BECOME AVAILABLE.

SIGNATURE OF APPLICANT /s/ Purdum and Jeschke


APPROVED BY \_\_\_\_\_ FOR \_\_\_\_\_ DATE \_\_\_\_\_  
(KIND OF SYSTEM)

REJECTED BY \_\_\_\_\_ FOR \_\_\_\_\_ DATE \_\_\_\_\_  
(KIND OF SYSTEM)

HOLD PENDING FURTHER TESTS \_\_\_\_\_ DATE \_\_\_\_\_

REASONS FOR REJECTION OR HOLDING \_\_\_\_\_

# THIS IS NOT A PERMIT

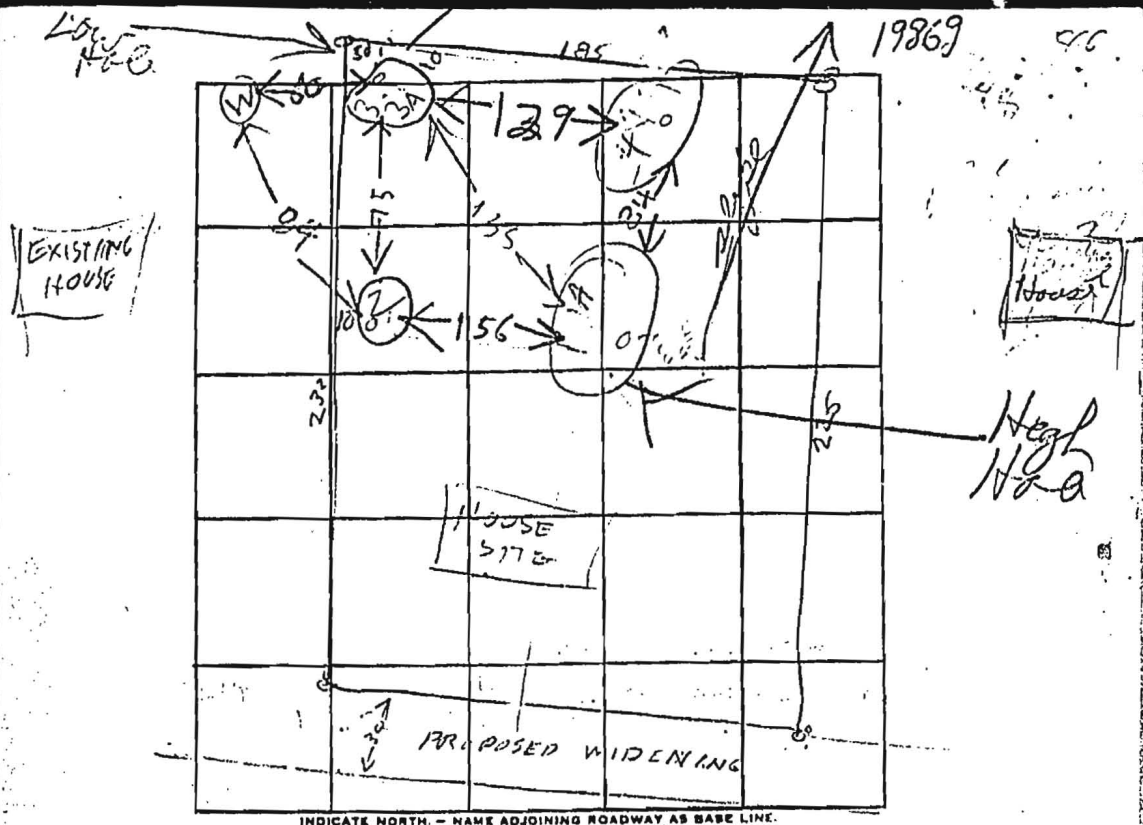

DATE	TEST NO.	DEPTH	PRE-WET		TEST - 1" DROP		TIME
			START	STOP	START	STOP	
4/30/76	B	5'	205	206	206	208	2
	3A	12"	205	206	206	210	4
	2	11"	208	3 FT	CLAY REST	PK	
	1	4 1/2"	220	225	225	227	2
	1A-A	11 1/2"	225	229	229	233	4
	4	11"	6000	CALL AT THE	WAS		

av time  
3

Max Depth  
4

REMARKS: No relocation needed - show well

TYPE OF SOIL: Shell Sewage area slightly to Marla way

TESTED BY: (KH HZ)

ALSO PRESENT: J. F. WICK