

4-26-85
11:12 pm

operated
4-26-85
SAH

PERMIT

P 35281
A 33651

SEWAGE DISPOSAL SYSTEM

MARYLAND STATE DEPARTMENT OF HEALTH

HOWARD COUNTY
BUREAU OF ENVIRONMENTAL HEALTH
992-2330

ELLICOTT CITY
DISTRICT 4th
DATE 4/12/85

INDEXED

Douglas M. Underwood IS PERMITTED TO INSTALL ALTER
ADDRESS 13603 Parkland Drive, Rockville, MD 20853 PHONE 460-6889
SUBDIVISION William K. Jenne ROAD 3656 Daisy Road LOT 1
PROPERTY OWNER Douglas Underwood

ADDRESS ADJACENT LOT: complaining of long term digestive probs possibly due to failing septic at 3670 Daisy.
IF GARBAGE GRINDER IS USED INCREASE SEPTIC TANK CAPACITY BY 50% AND ABSORPTION AREA BY 22%.
GARBAGE GRINDER? YES NO
SEPTIC TANK CAPACITY 1250 GALLONS NUMBER OF BEDROOMS 4


TRENCHES - 158 sq. ft. per bedroom. Trench to be 2 feet wide. Inlet 3 feet below original grade. Bottom maximum depth 8 feet below original grade. Effective area begins at 3 feet below original grade. 5 feet of stone below distribution pipe. LOCATION: Start the first trench 120 feet from the right lot line and 130 feet from the rear lot line which divides Lot 1 from Lot 2. Run trench(es) along level ground toward rear lot line. NOTE: No trench to exceed 100 feet in length. If more than one trench used, a distribution box is required. Trenches to be installed on level ground. Call for inspection of trenches before and after gravel is installed. Provide 6" - 8" diameter cleanout and cap to grade or above on septic tank. SA

PLANS APPROVED BY C. Williams DATE 11/84

- COVER NO WORK UNTIL INSPECTED AND APPROVED.
- NEITHER THE HOWARD COUNTY COUNCIL NOR THE HEALTH DEPARTMENT IS RESPONSIBLE FOR THE SUCCESSFUL OPERATION OF ANY SYSTEM.
- NOTE: IF TRENCH IS USED CALL FOR INSPECTION BEFORE AND AFTER PLACING GRAVEL IN TRENCH.
- NOTE: NO DRY WELL SHALL EXCEED 15 FOOT IN DIAMETER. NO ABSORPTION TRENCH TO EXCEED 100 FEET IN LENGTH.
- NOTE: ALL PIPE FROM HOUSE TO SEPTIC TANK MUST BE CAST IRON OR SCHEDULE 40 PVC OR ABS.
- PERMIT VOID AFTER THREE YEARS.
- NOTE: INSTALL STAND PIPE ON SEPTIC TANK AND DRY WELL. STAND PIPES MUST BE 6 INCHES IN DIAMETER, CAST IRON, CONCRETE OR TERRA COTTA, OR PVC OR ABS ACCEPTED. IF TOP OF SEPTIC TANK IS DEEPER THAN 3 FEET MANHOLE TO GRADE REQUIRED

***INSTALLER IS RESPONSIBLE FOR OBTAINING FINAL APPROVAL ON THIS PERMIT**

A 33651

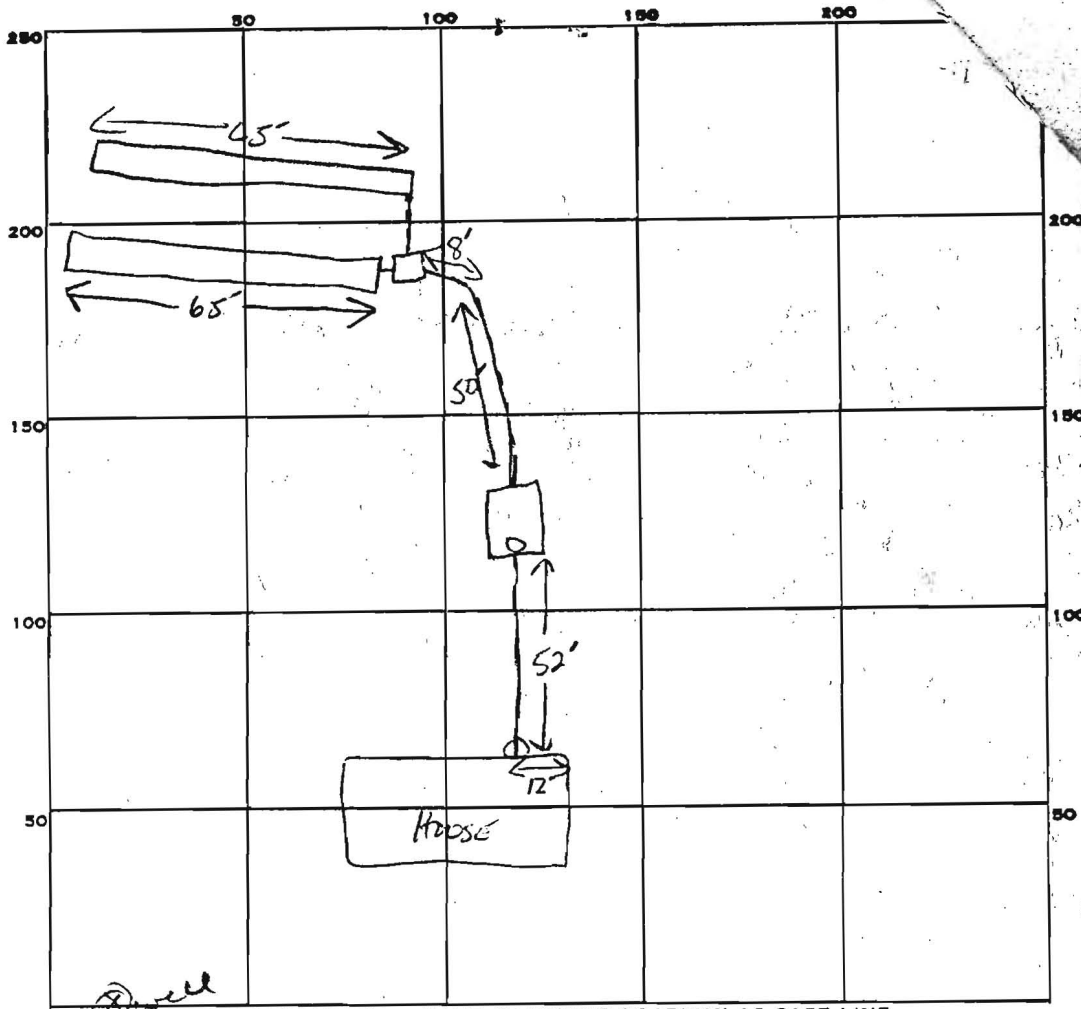

3
158
4
632

127
632
5
13
32

INDICATE NORTH. - NAME ADJOINING ROADWAY AS BASE LINE.

PERMIT CARD

SEPTIC TANK, LEVEL 1500

CLEANOUTS AT HOUSE ST

DISTRIBUTION BOX, LEVEL _____

PILE FIELD, DEPTH #1 8' FT. TRENCH WIDTH 2 FT. INLET 3' 130

GRAVEL DEPTH #1 8' IN. TOTAL LENGTH #1 65' 130' 450

GRAVEL DEPTH #2 5' IN. TOTAL LENGTH #2 65' FT.

NUMBER OF TRENCHES 2 TOTAL BOTTOM AREA 650 sq

DEEPAGE PITS, INSIDE DIAMETER _____ FT. DEPTH BELOW INLET _____ FT.

ABSORBENT AREA 650 SQ. FT.

REMARKS 4-25-85 OK TO COVER TRENCH #1 SAVED

4-26-85 OK TO COVER ALL WORK. SAVED

DATE SYSTEM APPROVED 4-26-85

INSPECTOR SAM