

PUB. SEWER STATUS VERIFIED BY _____

ISSUE DATE: _____

APPROVAL DATE: _____

PERMIT

INDEXED

ON-SITE SEWAGE DISPOSAL SYSTEM HOWARD COUNTY HEALTH DEPARTMENT BUREAU OF ENVIRONMENTAL HEALTH

P re-index _____

A 519872-B _____

05-~~305~~ 369827

IS PERMITTED TO INSTALL ALTER

ADDRESS: _____

PHONE NUMBER: _____

SUBDIVISION: _____

LOT NUMBER: _____

ADDRESS: 13826 Howard Road

PROPERTY OWNER: Craig Alsheimer

SEPTIC TANK CAPACITY (GALLONS): _____

PUMP CHAMBER CAPACITY (GALLONS): _____

NUMBER OF BEDROOMS: _____

SQUARE FEET PER BEDROOM: _____

LINEAR FEET OF TRENCH REQUIRED: _____

TRENCHES:	Trench to be _____ feet wide. Inlet _____ feet below original grade. Bottom maximum depth _____ feet below original grade. Effective area begins at _____ feet below original grade. _____ feet of stone below distribution pipe.
LOCATION:	_____
PURPOSE:	_____

PLANS APPROVED: _____ DATE: _____

- NOTE: PERMIT VOID AFTER 2 YEARS
- NOTE: CONTRACTOR RESPONSIBLE FOR SCHEDULING A PRE-CONSTRUCTION INSPECTION FOR ALL INSTALLATIONS
- NOTE: WATERTIGHT SEPTIC TANKS REQUIRED
- NOTE: ALL PARTS OF SEPTIC SYSTEM SHALL BE 100 FEET FROM ANY WATER WELL
- NOTE: MANHOLE RISERS REQUIRED ON ALL SEPTIC TANKS AND PUMP CHAMBERS

NEITHER THE HOWARD COUNTY COUNCIL NOR THE HEALTH DEPARTMENT IS RESPONSIBLE FOR THE SUCCESSFUL OPERATION OF ANY SYSTEM PERMITTEE RESPONSIBLE FOR OBTAINING FINAL APPROVAL ON THIS PERMIT CALL 410-313-2640 FOR INSPECTION OF SEPTIC SYSTEM

A519872-B

12:30
6/16/03

A579872-B

SITE INSPECTION SHEET

OWNER: Craig Alsheimer → PHONE #: 410-888-9590


ADDRESS: 13826 Howard Road CONTRACTOR: _____

WELL TAG #: _____

SUBDIVISION: _____ LOT: _____ COUNTY #: _____

PROPOSAL: BP site inspection - renovating home, Evaluate septic system. (KN)
Records not found

LOCATION DIAGRAM

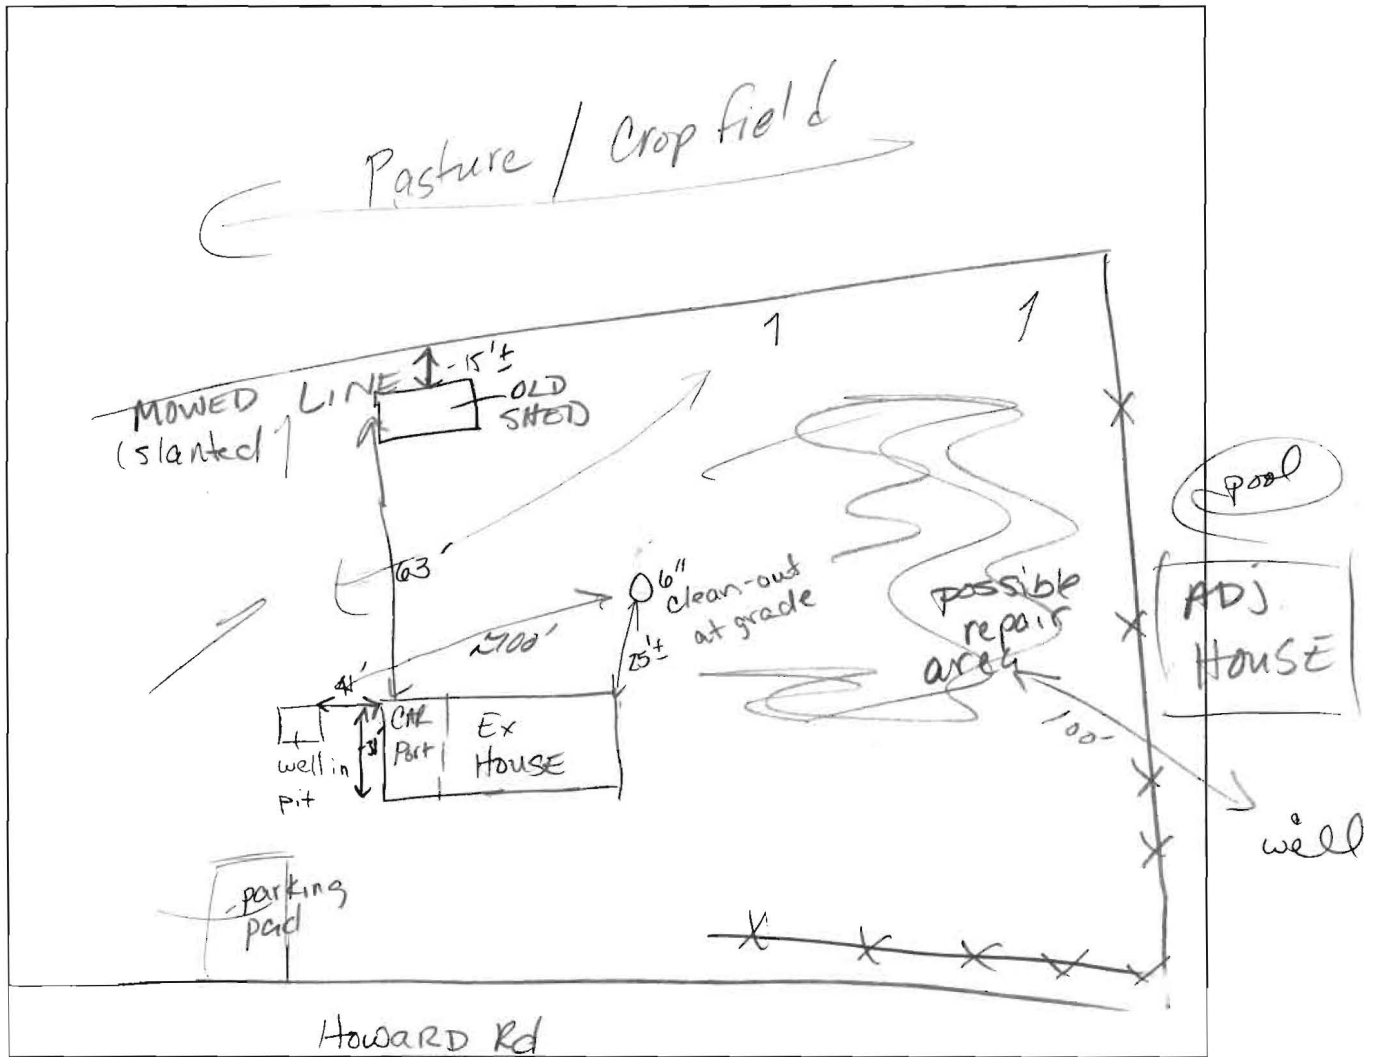

COMMENTS: 6/16/03 Septic tank full - may need future repair soon. Spoke to owner about pumping tank & also signs of failing system (S.T. fills rapidly & possibly backflow into house (KN))

DATE: 6/16/03 INSPECTOR: Race Norman

ALSHMEIER RESIDENCE
 13826 HOWARD RD DAYTON
 RENOVATION & REMODELING
 1108 HOODSMILL RD WOODBINE


6-11-03
 Owner called
 & said no
 m. # of bedrooms

(3 total)

KN

6/10/03 SEE SIGHT
 INSPECTION SITE, PLENTY OF REPAIR
 AREA. System may
 need to be replaced
 soon.

(KN)

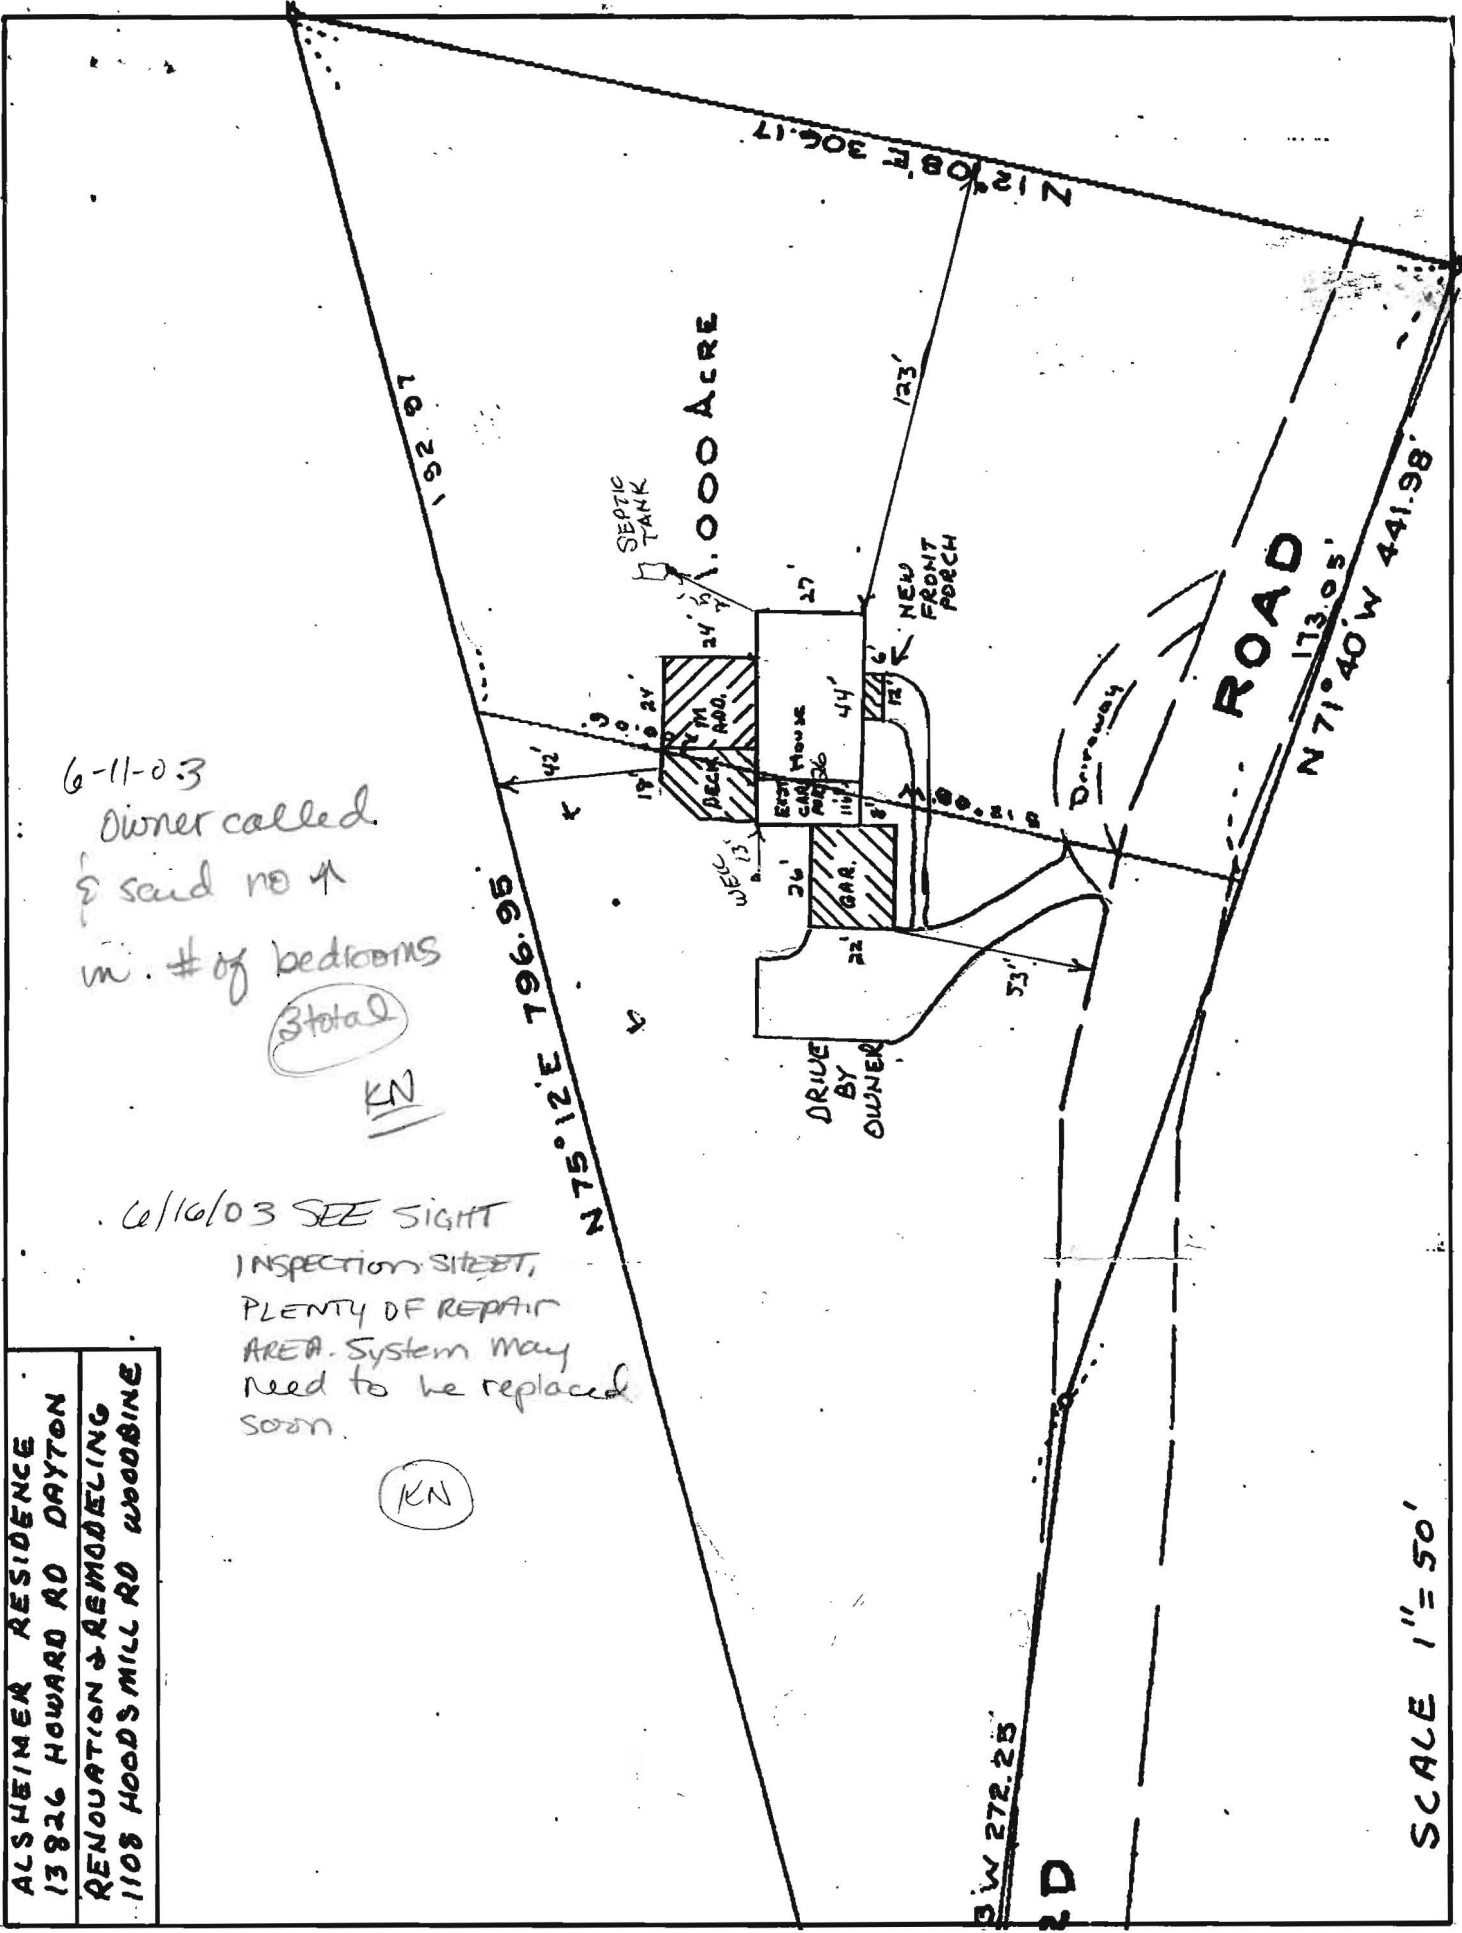

SCALE 1" = 50'