

12/2/80
9:50 A.M.

12/2/80 FILE APPROVED
C.B.D.

PERMIT

P 31055

SEWAGE DISPOSAL SYSTEM

A REPAIR

MARYLAND STATE DEPARTMENT OF HEALTH

HOWARD COUNTY

ELLICOTT CITY

DISTRICT _____

INDEXED

DATE 11/26/80

Jenkins Bros. IS PERMITTED TO INSTALL ALTER X

ADDRESS _____ PHONE _____

SUBDIVISION _____ ROAD Routes 32 & 29 - see LOT _____
application for directions

PROPERTY OWNER Myers

ADDRESS Routes 32 & 29

SPECIFICATIONS

SEPTIC TANK CAPACITY 1000 GALLONS { 1 New Cement One }

MODIFIED DRAIN FIELD 3 1/2 - 2 1/2 DEPTH 50 FEET, BOTTOM AREA _____ SQ. FT.

DEEP TRENCH _____ DEPTH _____ FEET, BOTTOM AREA _____ SQ. FT.

SEEPAGE PITS _____ ABSORBENT SIDE-WALL AREA _____ SQ. FT.

INLET PIPE 3 1/2 - 3 1/2 FT. BELOW ORIGINAL GRADE. MAXIMUM DEPTH 9 1/2 FT. BELOW ORIGINAL GRADE

EFFECTIVE DEPTH AT 3 1/2 FT. BELOW ORIGINAL GRADE.

LOCATE DISPOSAL AREA 91' *Directly behind rear porch of existing house* FT. FROM _____ LOT LINE AND _____ FT. FROM _____ LOT LINE AS SEEN WHEN

FACING LOT FROM Rt. 32,

REPAIR - CALL FOR INSPECTION WHEN GROUND IS OPENED UP SO SANITARIAN CAN

RECOMMEND REPAIR. 12/2/80 *Replace septic tank with*

a 1000 gallon cement one, replace pipes from house to new tank if needed; install cast iron from new tank to beginning of trench; 50' of trench; 2' wide; 3'-9 1/2" + 6" of slope under pipe; 2 inspections of trench before & after storm.

PLANS APPROVED BY Palmer F. Wine + C.B. [Signature] DATE 11/26/80

COVER NO WORK UNTIL INSPECTED AND APPROVED.

NEITHER THE HOWARD COUNTY COUNCIL NOR THE HEALTH DEPARTMENT IS RESPONSIBLE FOR THE SUCCESSFUL OPERATION OF ANY SYSTEM.

NOTE: IF TRENCH IS USED CALL FOR INSPECTION BEFORE PLACING GRAVEL IN TRENCH.

NOTE: NO DRY WELL SHALL EXCEED 15 FOOT IN DIAMETER.


NOTE: ALL PIPE FROM HOUSE TO DISPOSAL AREA MUST BE CAST IRON.

PERMIT VOID AFTER THREE YEARS.

NOTE: INSTALL STAND PIPE ON SEPTIC TANK AND DRY WELL. STAND PIPES MUST BE 6 INCHES IN DIAMETER. CAST IRON, CONCRETE OR TERRA COTTA ACCEPTED.

***INSTALLER IS RESPONSIBLE FOR OBTAINING FINAL APPROVAL ON THIS PERMIT.**

A 31055

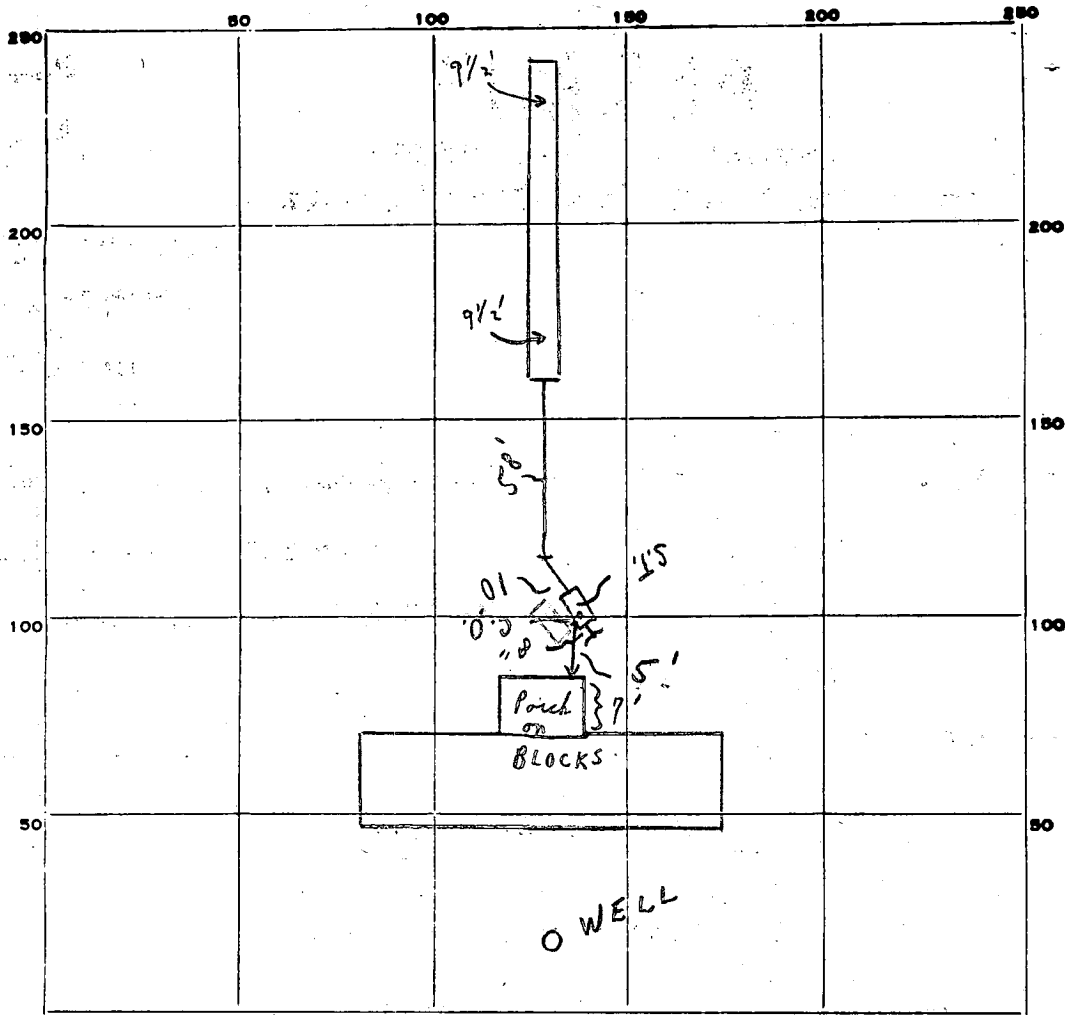

INDICATE NORTH. — NAME ADJOINING ROADWAY AS BASE LINE.

RT. 32

PERMIT CARD

SEPTIC TANK, LEVEL

CLEANOUTS

S.T. C.I.

DISTRIBUTION BOX, LEVEL _____

TILE FIELD, DEPTH 9 1/2 FT. TRENCH WIDTH 2 FT.

GRAVEL DEPTH 6 1/2 IN. TOTAL LENGTH 50 FT.

NUMBER OF TRENCHES 1 TOTAL BOTTOM AREA _____

SEEPAGE PITS, INSIDE DIAMETER _____ FT. DEPTH BELOW INLET _____ FT.

ABSORBENT AREA 325⁺ SQ. FT.

REMARKS

12/2/80 TRENCH ONLY OK FOR STONE; SYSTEM - COMPLETE.

LATE P.M. C.B.S.

C.B.S.

DATE SYSTEM APPROVED

12/2/80

INSPECTOR

C. B. Stresker