

# APPLICATION

A 13880  
P \_\_\_\_\_

SEWAGE DISPOSAL TESTING

MARYLAND STATE DEPARTMENT OF HEALTH

HOWARD COUNTY 100 O'Callahan

ELLICOTT CITY

DISTRICT 2

DATE 8/26/68

*Dry Well - 300 sq ft side wall and below the inlet with a maximum depth below original gradient line of percolation. Test place the dry well between 285 FT and 305 FT from the front lot line and between 20 FT and 40 FT from the right side of the lot as seen when facing the lot from Green Clover Drive.*

TO: THE COUNTY HEALTH OFFICER  
ELLICOTT CITY, MARYLAND

*DRY WELL MUST BE COMPLETED & APPROVED*

I, HEREBY, APPLY FOR THE NECESSARY TESTS IN ORDER TO CONSTRUCT OR RECONSTRUCT A SEWAGE DISPOSAL SYSTEM.

*Therese this goes in permit*

PROPERTY OWNER Douglas Lichtler

ADDRESS 2620 Frederick Road, Baltimore 21228 PHONE 655-2853

PROPERTY LOCATION:

SUBDIVISION Allenford LOT NO. 27, Bk. 2, Page 4

ROAD AND DESCRIPTION Green Clover Drive

OCCUPANT \_\_\_\_\_ PHONE \_\_\_\_\_

PERSON TO CONSTRUCT SYSTEM \_\_\_\_\_

ADDRESS \_\_\_\_\_ PHONE \_\_\_\_\_

SIZE OF LOT 156' x 55' x 473' x 563' TYPE BLDG. 3  
NUMBER OF RESIDENCES

IF NOT SINGLE RESIDENCE DESCRIBE \_\_\_\_\_

SIGNATURE OF APPLICANT /s/ Douglas Lichtler


✓ APPROVED BY [Signature] FOR Dry Well DATE 4/1/70

REJECTED BY \_\_\_\_\_ FOR \_\_\_\_\_ DATE \_\_\_\_\_

HOLD PENDING FURTHER TESTS \_\_\_\_\_ DATE \_\_\_\_\_

REASONS FOR REJECTION OR HOLDING \_\_\_\_\_

# THIS IS NOT A PERMIT

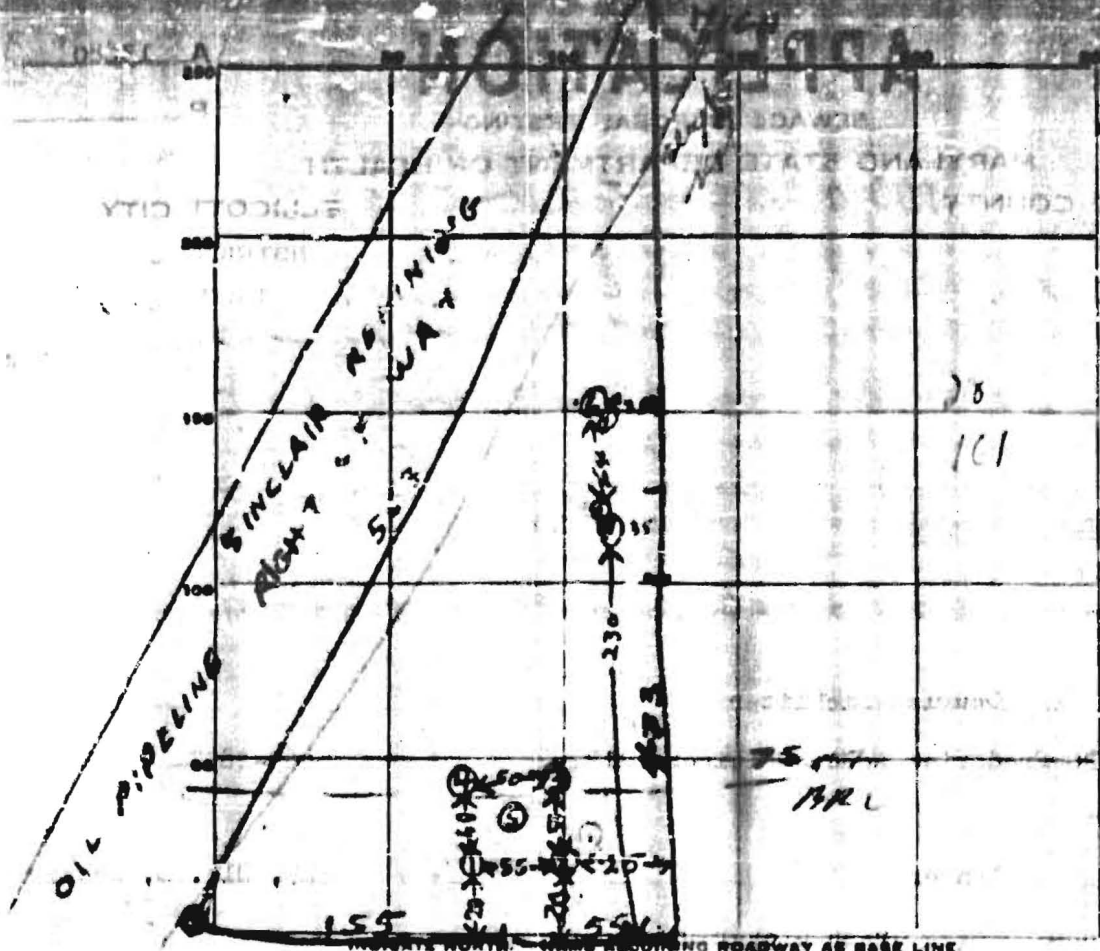

GREEN GROVER DRIVE

LOW

DATE	TEST NO.	DEPTH	PRE-WET		TEST - 1" DROP		TIME
			START	STOP	START	STOP	
4/1/62	1	3	114	118	118	121	4
	2	3	115	117	117	126	7
	3	4	117	200	off spec		
	4	3 1/2	118	200	11	11	11
	5	9	121	200	11	11	11
1/17/63	6	9 1/2	1022	1025	1025	1028	3
	7	5 1/2	1024	1026	1026	1033	
	8	10 1/2	1031	1032		1038	3
	9	5 1/2	103	1125	off spec		

3 min air for depth size

11 min air for depth size

Mar 1963

SOIL AUGER FINING

TESTED BY *H-*

REMARKS: *Not 7 feet 4*  
*Must look dry well before...*