

PUB. SEWER STATUS VERIFIED BY _____

ISSUE DATE: _____

PERMIT

P Re-index

APPROVAL DATE: _____

INDEXED

A 519872-M

ON-SITE SEWAGE DISPOSAL SYSTEM HOWARD COUNTY HEALTH DEPARTMENT BUREAU OF ENVIRONMENTAL HEALTH

04 - 317645

_____ IS PERMITTED TO INSTALL ALTER

ADDRESS: _____ PHONE NUMBER: _____

SUBDIVISION: _____ LOT NUMBER: _____

ADDRESS: 17475 Frederick Road PROPERTY OWNER: James Hillen

SEPTIC TANK CAPACITY (GALLONS): _____

PUMP CHAMBER CAPACITY (GALLONS): _____

NUMBER OF BEDROOMS: _____

SQUARE FEET PER BEDROOM: _____

LINEAR FEET OF TRENCH REQUIRED: _____

TRENCHES:	Trench to be _____ feet wide. Inlet _____ feet below original grade. Bottom maximum depth _____ feet below original grade. Effective area begins at _____ feet below original grade. _____ feet of stone below distribution pipe.
LOCATION:	Re-index
PURPOSE:	

PLANS APPROVED: _____ DATE: _____

- NOTE: PERMIT VOID AFTER 2 YEARS
- NOTE: CONTRACTOR RESPONSIBLE FOR SCHEDULING A PRE-CONSTRUCTION INSPECTION FOR ALL INSTALLATIONS
- NOTE: WATERTIGHT SEPTIC TANKS REQUIRED
- NOTE: ALL PARTS OF SEPTIC SYSTEM SHALL BE 100 FEET FROM ANY WATER WELL
- NOTE: MANHOLE RISERS REQUIRED ON ALL SEPTIC TANKS AND PUMP CHAMBERS


NEITHER THE HOWARD COUNTY COUNCIL NOR THE HEALTH DEPARTMENT IS RESPONSIBLE FOR THE SUCCESSFUL OPERATION OF ANY SYSTEM PERMITTED RESPONSIBLE FOR OBTAINING FINAL APPROVAL ON THIS PERMIT CALL 410-313-2640 FOR INSPECTION OF SEPTIC SYSTEM

AS19872-M

SITE INSPECTION SHEET

OWNER: Hillen PHONE #: _____
ADDRESS: 17475 Frederick Rd CONTRACTOR: _____
Mt. Airy WELL TAG #: N/A
SUBDIVISION: _____ LOT: _____ COUNTY #: _____
PROPOSAL: Garage

LOCATION DIAGRAM

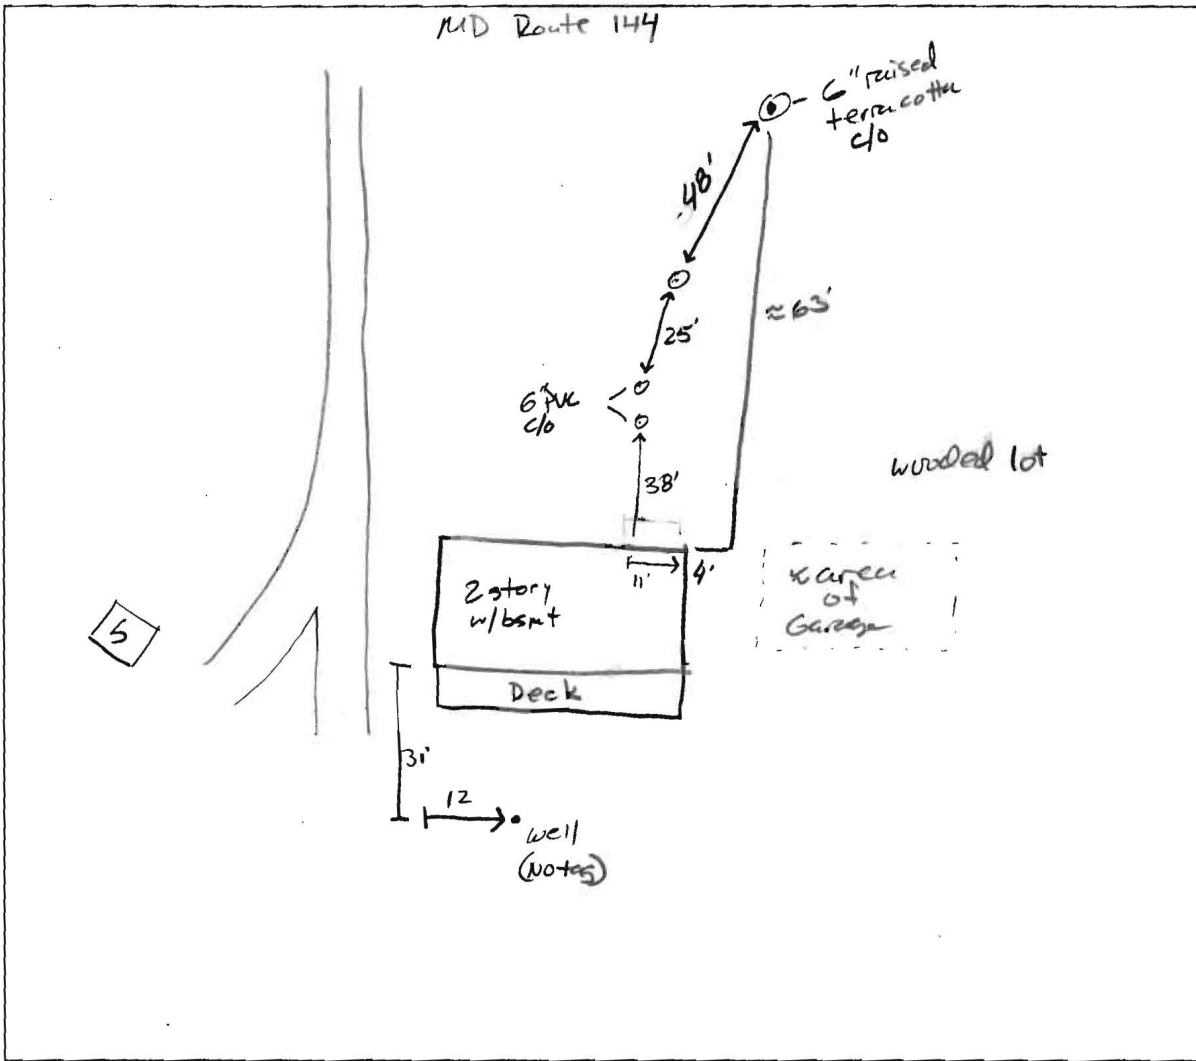

COMMENTS: Plenty of replacement area in front yard. Can maintain 100' from neighboring lot lines, therefore neighboring wells not located.

DATE: 10/6/03 INSPECTOR: [Signature]

2/1/72
Ready

Final
2/2/72
R. Tower

File

INDEXED

PERMIT

SEWAGE DISPOSAL SYSTEM

P 16463

A 16426

MARYLAND STATE DEPARTMENT OF HEALTH

HOWARD COUNTY

ELLICOTT CITY

DISTRICT 4

DATE 1/21/72

Kelton Construction Co. IS PERMITTED TO INSTALL ALTER

ADDRESS 2829 Florence Road, Washine, Md. PHONE 499-27196

A SEWAGE DISPOSAL SYSTEM LOCATED AT _____

SUBDIVISION _____ ROAD 17475 FREDERICK ROAD LOT 1
Route 144
(beside Dr. Hough's Animal Hospital)

PROPERTY OWNER James Eileen

ADDRESS _____

SPECIFICATIONS - 4 bedrooms

DRAIN FIELD _____ DEPTH _____ FEET. BOTTOM AREA _____ SQ. FT.

SEEPAGE PITS _____ ABSORBENT SIDE-WALL AREA _____ SQ. FT.

SEPTIC TANK CAPACITY 1,200 GALLONS

FOR GARBAGE GRINDER, INCREASE DISPOSAL AREA 25% & TANK CAPACITY 50%.

OTHER Dry well - 2 Dry wells - each dry well to have 302 sq. ft. absorbent sidewall area below the first 44 ft. of non-absorbent ground. Maximum depth for dry wells is 11 ft. below original grade. Place first dry well about 361 ft. from front lot line and 101 ft. from right side line. Place second dry well 221 ft. from front lot line and 101 ft. from right side line as see when facing lot from Route 144.
Dry wells to be connected in series. 2 ft. manhole clearest to be installed on septic tank to grade.


NOTE: ALL PIPE FROM HOUSE TO SEPTIC TANK MUST BE CAST IRON.
PERMIT VOID AFTER THREE YEARS.

NOTE: INSTALL STAND PIPE ON SEPTIC TANK AND DRY WELL.
PLANS APPROVED BY D. W. Henshaw DATE 11/10/71

FILL SEPTIC TANK AND DISTRIBUTION BOX WITH WATER BEFORE CALLING FOR AN INSPECTION. COVER NO WORK UNTIL INSPECTED AND APPROVED.

NEITHER THE HOWARD COUNTY COMMISSIONERS NOR THE HEALTH DEPARTMENT IS RESPONSIBLE FOR THE SUCCESSFUL OPERATION OF ANY SYSTEM.

10821

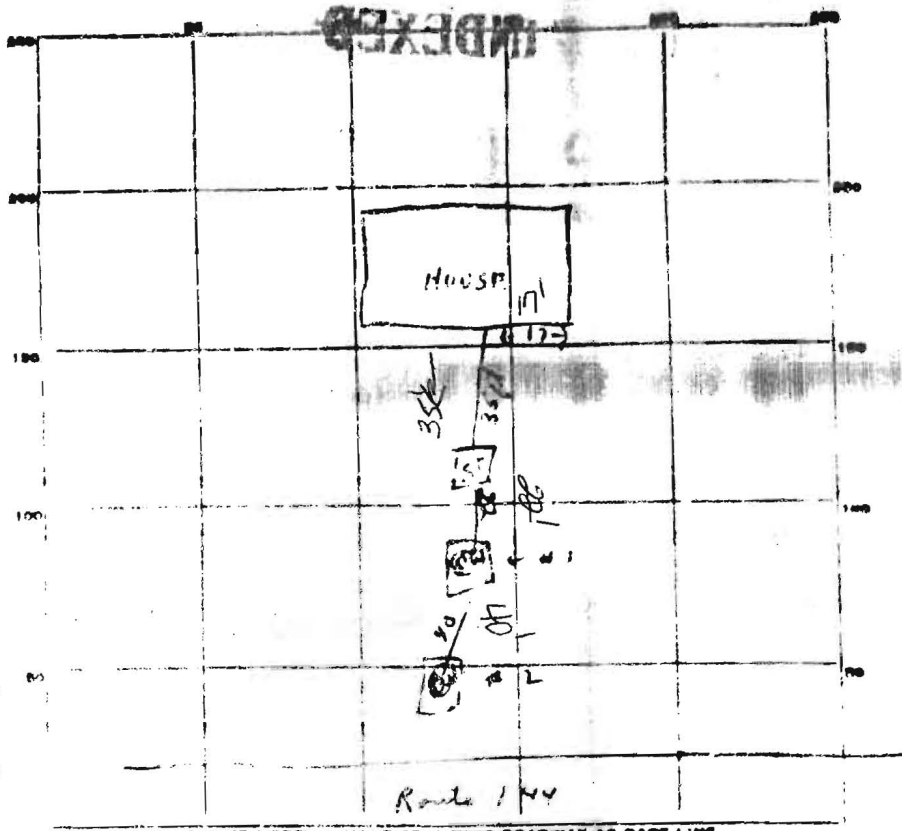

47
2
32
46
276
244

INDICATE NORTH - NAME ADJOINING ROADWAY AS BASE LINE

PERMIT CARD Issued

SEPTIC TANK LEVEL 12564 of 82

CLEANOUTS 0+

DISTRIBUTION BOX LEVEL _____

TILE FIELD, DEPTH _____ FT. TRENCH WIDTH _____ FT.

- GRAVEL DEPTH _____ IN. TOTAL LENGTH _____ FT.

NUMBER OF TRENCHES _____ TOTAL BOTTOM AREA _____

PERPAGE PITS, INSIDE DIAMETER 22 11712 DEPTH BELOW INLET 22 61 ft.

ABSORBENT AREA 22 299 SQ. FT. Total 628 sq ft.

REMARKS _____

DATE SYSTEM APPROVED 2/1/76

INSPECTOR R. Jones