

Building Address 17475 FREDERICK RD
Mt. Airy MD 21771

Suite/Apt. #: _____ SDP/WP/Petition #: _____

Census Tract 601/01 Subdivision _____

Section _____ Area _____ Lot 5

Tax Map 2 Parcel 107 Grid 19

Zoning R100 Map Coordinates 2H7 Lot size 5.8 ac.

Property Owner's Name JAMES E HILLEN

Address 17475 FREDERICK RD

City Mt Airy State MD Zip Code 21771

Home Phone 301-829-9642 Work Phone SAME

Applicant's Name & Mailing Address, (if other than stated hereon): _____

Phone _____ Fax _____

Existing Use _____

Proposed Use NEW GARAGE

Estimated Construction Cost \$ 35,000.00

Description of Work 2.5 story 3 car attached
NEW GARAGE 24x36
FROM HOUSE SIZE 24x36
STORAGE AREA ON 2nd FLOOR

Contractor Company STURDY BUILT INC

Contact Person JIM HILLEN

Address 17475 FRED RD

City Mt Airy State MD Zip Code 21771

License No. _____

Phone 301-829-9642 Fax _____

Occupant or Tenant JIMMY IRENE HILLEN

Contact Name JIM HILLEN

Address 17475 FREDERICK RD.

City Mt Airy State MD Zip Code 21771

Phone 301-829-9642 Fax _____

Engineer or Architect Company STURDY BUILT INC.

Contact Person JACKIE CLARK

Address STURDY BUILT MFG INC
PO BOX 187

City EAST FREEDOM PA Zip Code 16637

Phone 1-800-722-0466 Fax FX 104

BUILDING DESCRIPTION - COMMERCIAL

BUILDING DESCRIPTION - RESIDENTIAL

Building Characteristics	Utilities
Height: _____	Water Supply: _____ Public _____ Private _____
No. of stories: _____	Sewage Disposal: _____ Public _____ Private _____
Gross area, sq. ft. per floor: _____	Electric Yes <input type="checkbox"/> No <input type="checkbox"/>
Use group: _____	Gas Yes <input type="checkbox"/> No <input type="checkbox"/>
Construction type: _____ Reinforced Concrete _____ Structural Steel _____ Masonry _____ Wood Frame _____	Heating System: _____ Electric <input type="checkbox"/> Oil <input type="checkbox"/>
State Certified Modular _____	Natural Gas <input type="checkbox"/>
	Propane Gas <input type="checkbox"/>
	Sprinkler system: N/A <input type="checkbox"/>
	Full _____
	Partial _____
	Other Suppression _____
	# of Heads _____

Building Characteristics	Utilities
SF Dwelling <input checked="" type="checkbox"/> SF Townhouse <input type="checkbox"/>	Water Supply: _____ Public <u>N/A</u>
Depth _____ Width _____	Private <input checked="" type="checkbox"/>
1st floor: _____	Sewage Disposal: _____ Public _____
2nd floor: <u>GARAGE</u>	Private <input checked="" type="checkbox"/>
Basement: <u>24x36</u>	Electric Yes <input type="checkbox"/> No <input checked="" type="checkbox"/>
Finished Basement <input type="checkbox"/> Unfinished Basement <input type="checkbox"/>	Gas Yes <input type="checkbox"/> No <input checked="" type="checkbox"/>
Crawl space <input type="checkbox"/> Slab on Grade <input type="checkbox"/>	Heating System: _____ Electric <input type="checkbox"/> Oil <input type="checkbox"/>
No. of Bedrooms _____	Natural Gas <input type="checkbox"/>
Multi-family dwellings: _____	Propane Gas <input type="checkbox"/>
No. of efficiency units: <u>N/A</u>	Sprinkler system: N/A <input checked="" type="checkbox"/>
No. of 1 BR units: _____	NFPA #13D _____
No. of 2 BR units: _____	NFPA #13R _____
No. of 3 BR units: _____	Other: _____
Other Structure: _____	
Dimensions: _____	
Foobings: _____	
Roof: <u>V</u>	
State Certified Modular _____	
Manufactured Home _____	

THE UNDERSIGNED HEREBY CERTIFIES AND AGREES AS FOLLOWS: (1) THAT HE/SHE IS AUTHORIZED TO MAKE THIS APPLICATION, (2) THAT THE INFORMATION IS CORRECT, (3) THAT HE/SHE WILL COMPLY WITH ALL REGULATIONS OF HOWARD COUNTY WHICH ARE APPLICABLE THERETO, (4) THAT HE/SHE WILL PERFORM NO WORK ON THE ABOVE REFERENCED PROPERTY NOT SPECIFICALLY DESCRIBED IN THIS APPLICATION, (5) THAT HE/SHE GRANTS CERTAIN OFFICIALS THE RIGHT TO ENTER ONTO THIS PROPERTY FOR THE PURPOSE OF INSPECTING THE WORK PERMITTED AND POSTING NOTICES.

James E Hillen
 Applicant's Signature

 Title/Company

JAMES E HILLEN
 Print Name

SEPT. 12th - 03
 Date

Checks payable to: **DIRECTOR OF FINANCE OF HOWARD COUNTY**
 ** PLEASE WRITE NEATLY AND LEGIBLY. **
 - FOR OFFICE USE ONLY -

AGENCY	DATE	SIGNATURE APPROVAL	DPZ SETBACK INFORMATION	PROPERTY ID#
Land Development DPZ			Front: _____	59524
State Highways			Rear: _____	Filing fee \$ _____
Political Criteria			Side: _____	Permit fee \$ _____
Dev. Engineering DPZ			Side St: _____	Excise tax \$ _____
Health	<u>10/6/03</u>	<u>Jay</u>	All minimum setbacks met? YES <input type="checkbox"/> NO <input type="checkbox"/>	Add'l per fee \$ _____
Fire Protection			Is Entrance Permit required? YES <input type="checkbox"/> NO <input type="checkbox"/>	TOTAL FEES \$ _____
Is Sediment Control approval required prior to issuance? YES <input type="checkbox"/> NO <input type="checkbox"/>			Historic District? YES <input type="checkbox"/> NO <input type="checkbox"/>	Sub-total paid \$ _____
CONTINGENCY CONSTRUCTION START <input type="checkbox"/>			Lot Coverage for New Town Zone _____	Balance due \$ _____
ONE STOP SHOP <input type="checkbox"/>			SDP/Red-line approval date _____	Check # <u>7257</u>
				Validation # <u>20411</u>
				Accepted by <u>ST</u>


COUNTRY VIEW
Plat C.M.P. No. 7321

600 144165




COUNTRY VIEW
Plat C.M.P. No. 7320

J. M. HILLEN
Libert 15229
U.S. BO 1 A5.
Folio 604

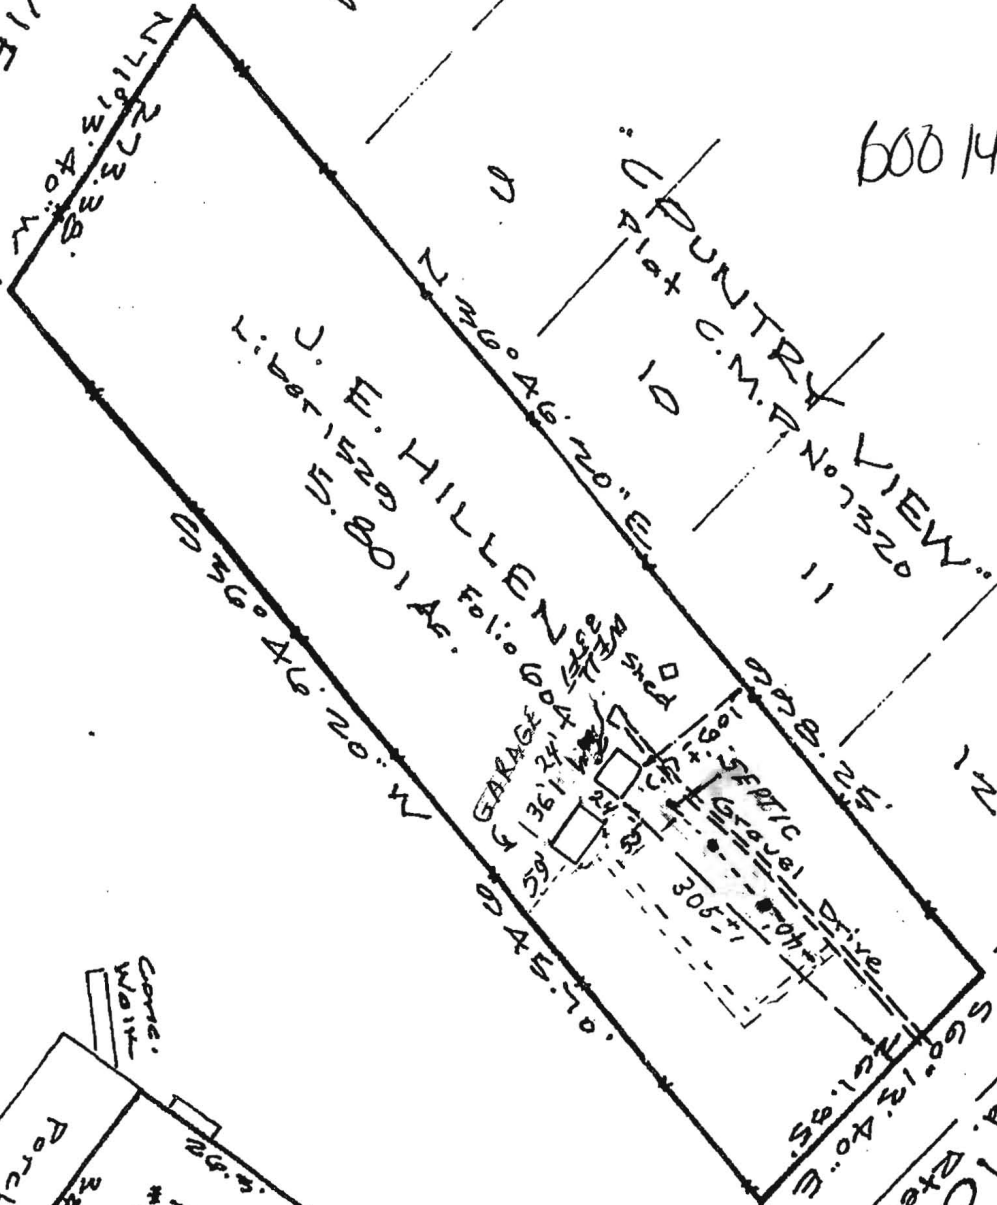

House Details
Scale: 1" = 20'

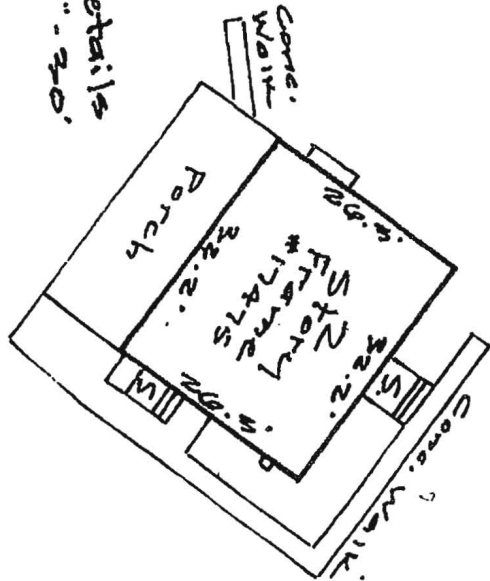

FREDERICK
REGISTERED
SURVEYOR
NO. 588
144 ROAD

