

TOMAS KRUKAITIS  
5483 HARRIS FARM LA.  
CLARKSVILLE, MD. 21029

P10 PARCEL 8  
2.910 AC.

8B

CINDER-BLOCK FOUNDATION

PROPOSED 4 CAR GARAGE


APPROXIMATE SEPTIC SYSTEM

SDA relocated



to top trench  
SEE SDA REVISION 1987

SCALE: 1"=50'-0

*OK*  
*have problem*  
*10' from S. Tank*  
*600' x 90'*  
*307' x 48'*

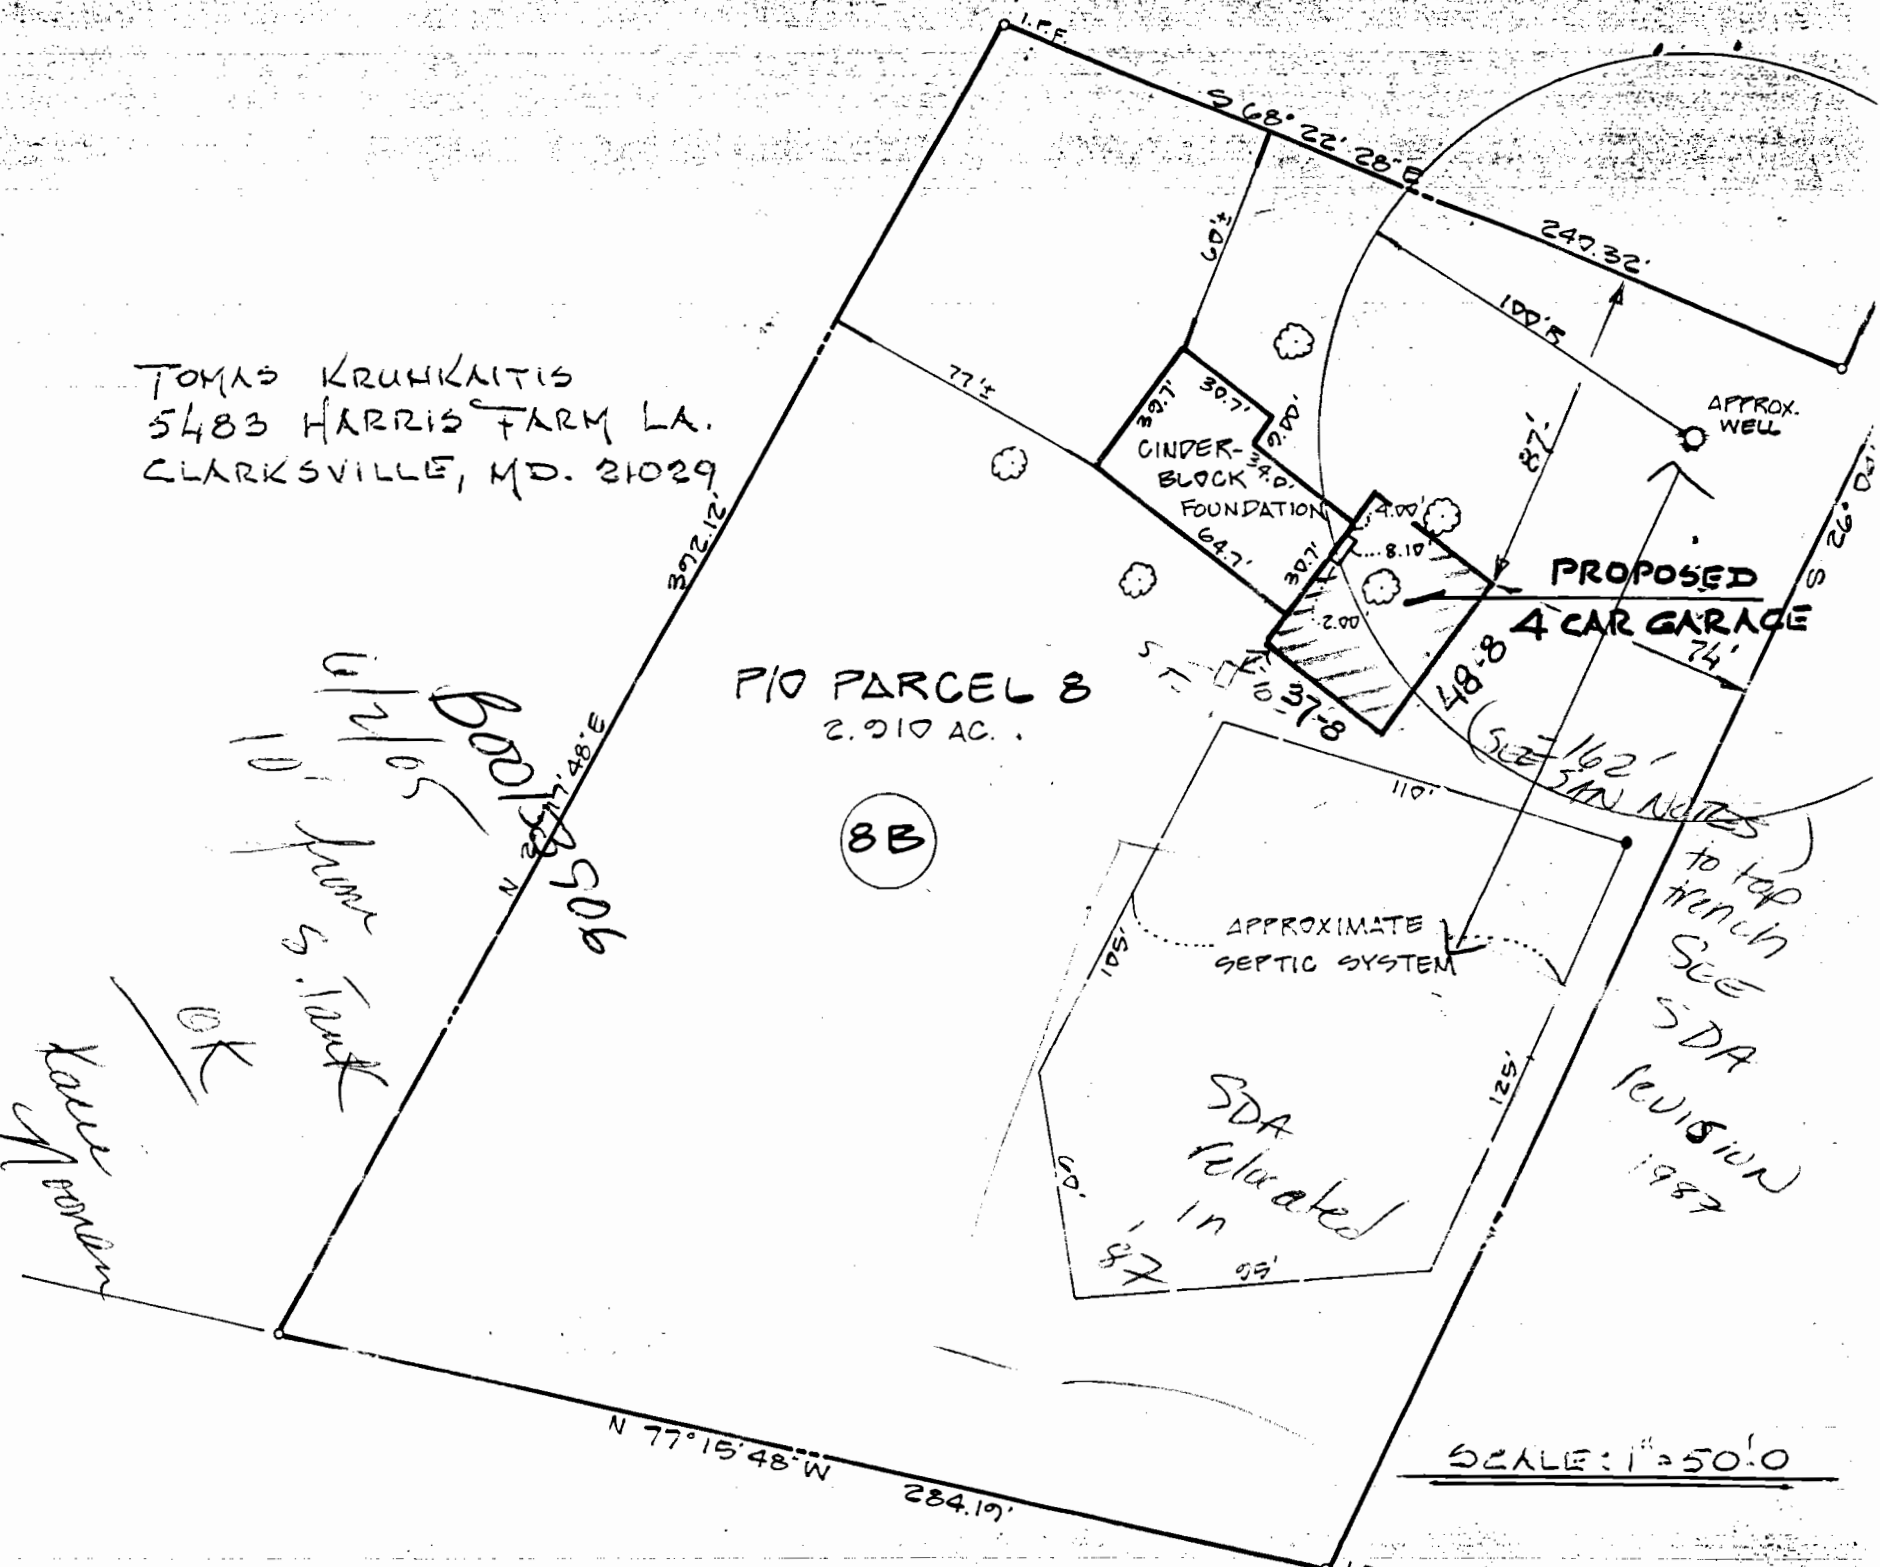

5483 HAMMIS  
FORM 40

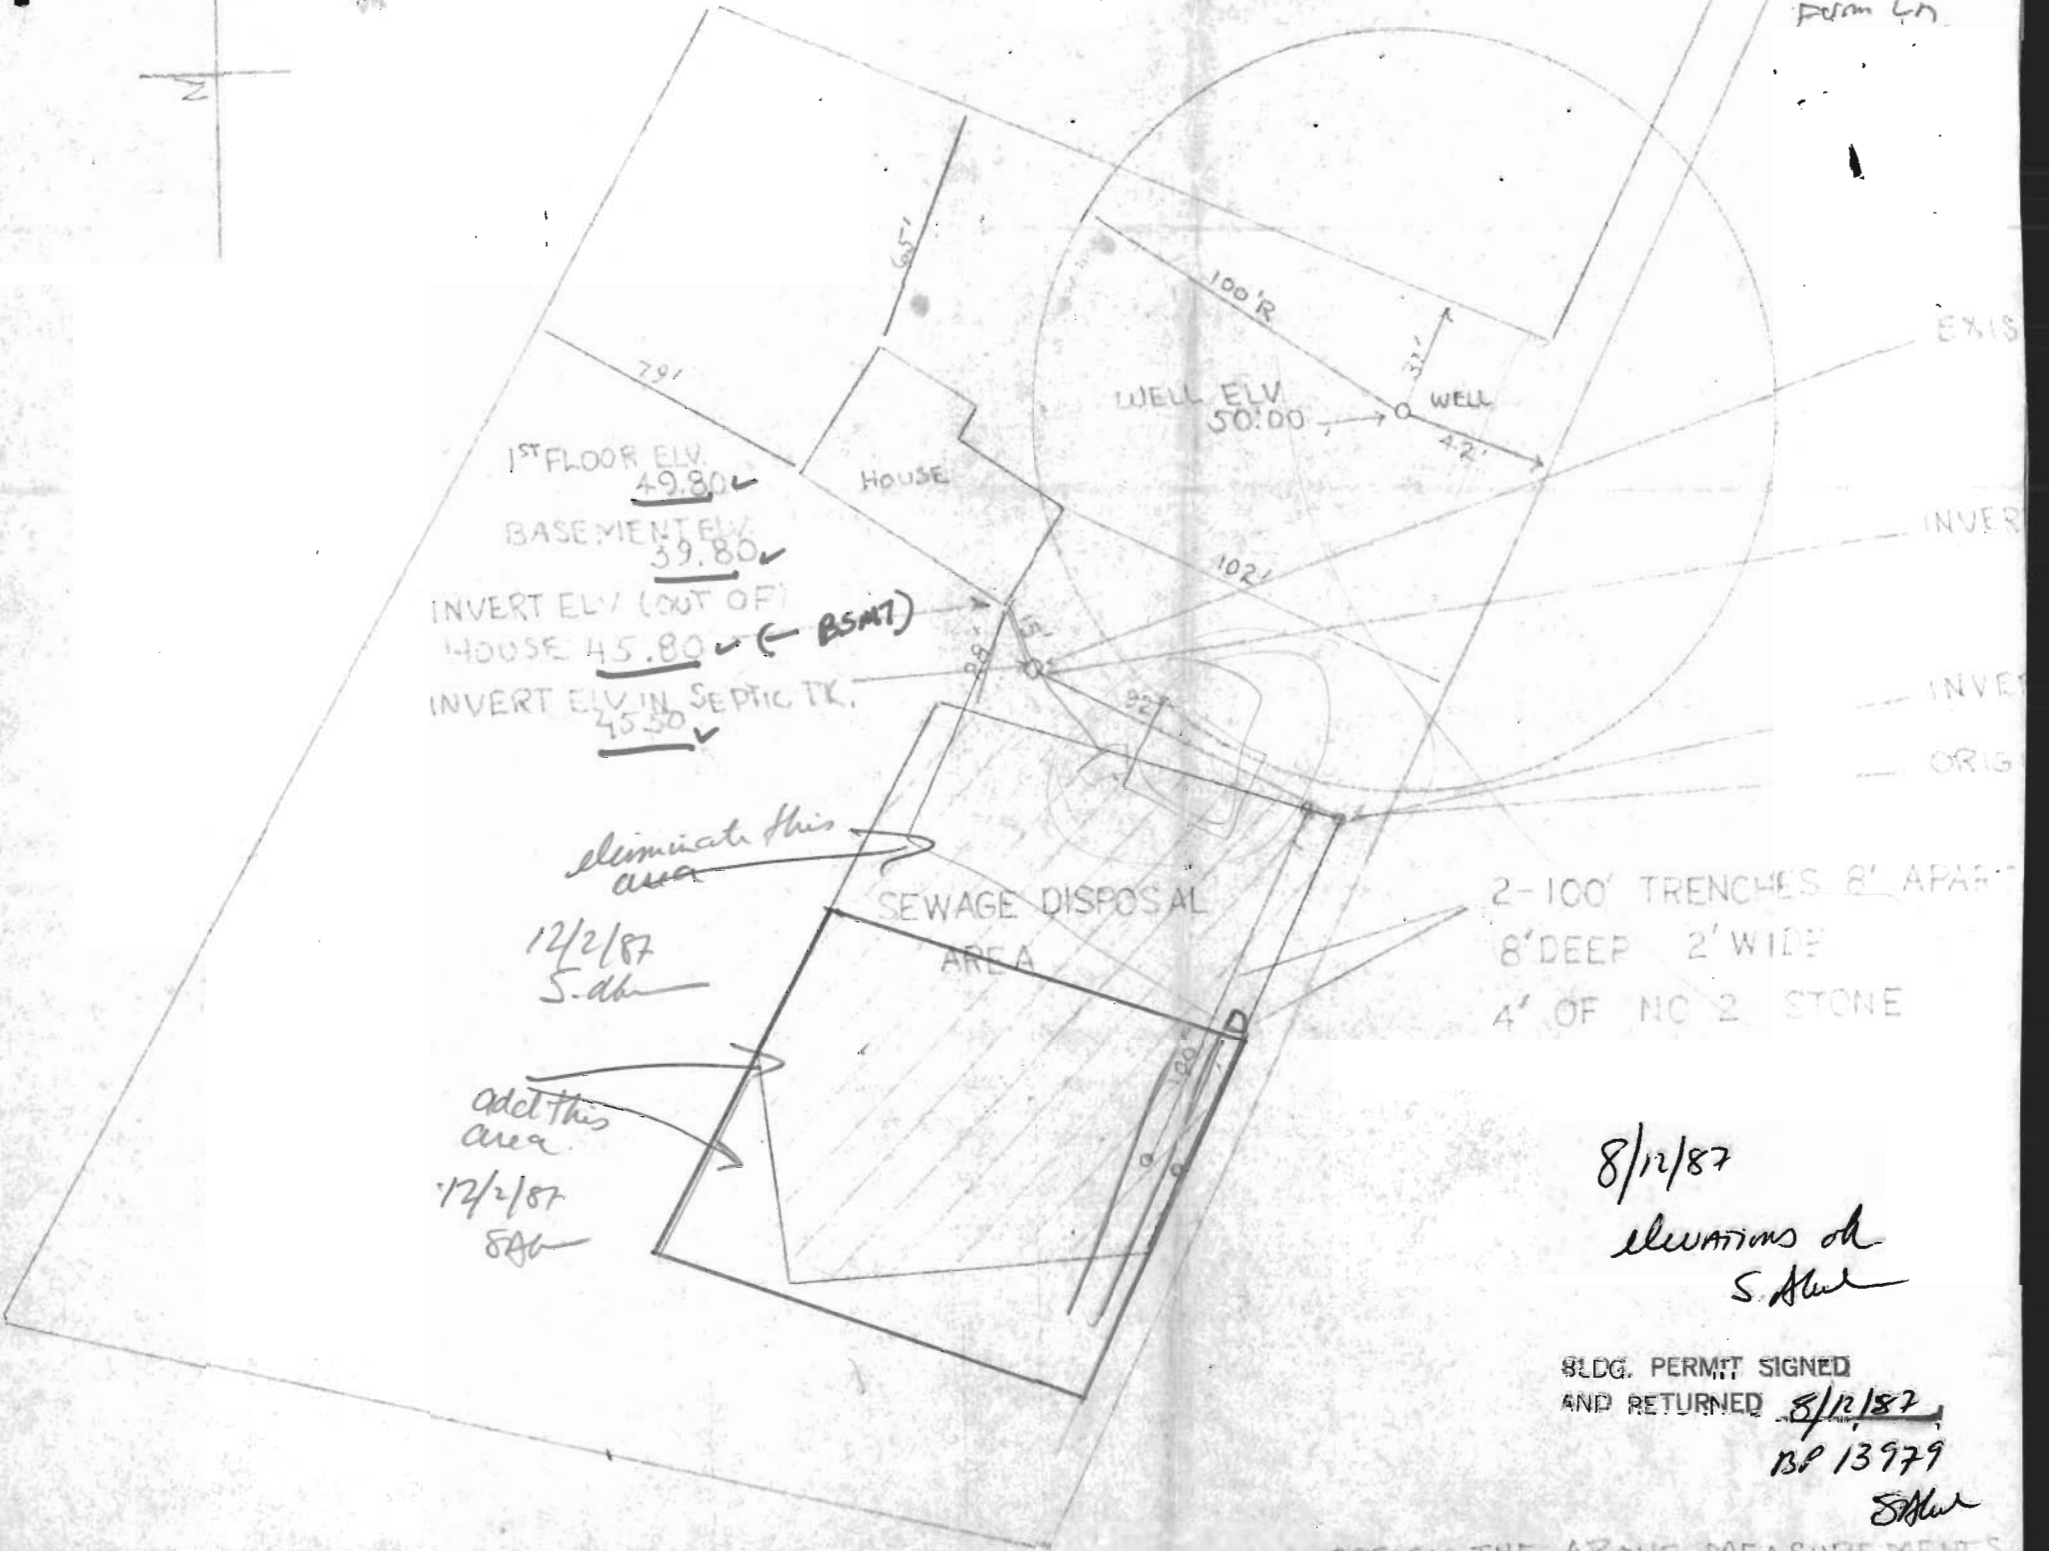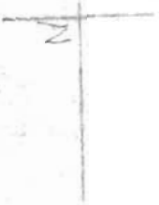

*eliminate this area*  
12/2/87  
S. db

*add this area*  
12/2/87  
S. db

2-100' TRENCHES 8' APART  
8' DEEP 2' WIDE  
4' OF NO 2 STONE

8/12/87  
elevations of  
S. db

BLDG. PERMIT SIGNED  
AND RETURNED 8/12/87  
BP 13979  
S. db

PLEASE VERIFY THE ABOVE MEASUREMENTS