

3/3/04 late 3/15/04

1/6/04 - 9:30

PUB. SEWER STATUS VERIFIED BY _____

ISSUE DATE: 1/2/2004

P 520010

APPROVAL DATE: 3/15/04

A REPAIR

PERMIT INDEXED

ON-SITE SEWAGE DISPOSAL SYSTEM HOWARD COUNTY HEALTH DEPARTMENT BUREAU OF ENVIRONMENTAL HEALTH

05-354374

Jack Fyock Septic Service IS PERMITTED TO INSTALL ALTER

ADDRESS: PO Box 89, Glenelg, MD 21737 PHONE NUMBER: 410-988-9270

SUBDIVISION: Highland Acres LOT NUMBER: 3

ADDRESS: 7606 Browns Bridge Road PROPERTY OWNER: John Rogers

SEPTIC TANK CAPACITY (GALLONS): Existing

PUMP CHAMBER CAPACITY (GALLONS): To Install 1000 gal.

NUMBER OF BEDROOMS: 4

SQUARE FEET PER BEDROOM: 200

*Bed to have 1 foot
of stone and enough to
cover laterals*

LINEAR FEET OF TRENCH REQUIRED: 20'x40' Leach bed

TRENCHES:	Trench to be _____ feet wide. Inlet _____ feet below original grade. Bottom maximum depth _____ feet below original grade. Effective area begins at _____ feet below original grade. _____ feet of stone below distribution pipe.
LOCATION:	
PURPOSE:	Septic system is failing. Call for inspection when the ground has been opened so sanitarian can recommend repair.


PLANS APPROVED: _____ DATE: _____

- NOTE: PERMIT VOID AFTER 2 YEARS
- NOTE: CONTRACTOR RESPONSIBLE FOR SCHEDULING A PRE-CONSTRUCTION INSPECTION FOR ALL INSTALLATIONS
- NOTE: WATERTIGHT SEPTIC TANKS REQUIRED
- NOTE: ALL PARTS OF SEPTIC SYSTEM SHALL BE 100 FEET FROM ANY WATER WELL
- NOTE: MANHOLE RISERS REQUIRED ON ALL SEPTIC TANKS AND PUMP CHAMBERS

NEITHER THE HOWARD COUNTY COUNCIL NOR THE HEALTH DEPARTMENT IS RESPONSIBLE FOR THE SUCCESSFUL OPERATION OF ANY SYSTEM PERMITTEE RESPONSIBLE FOR OBTAINING FINAL APPROVAL ON THIS PERMIT CALL 410-313-2640 FOR INSPECTION OF SEPTIC SYSTEM

P520010

NOT TO SCALE

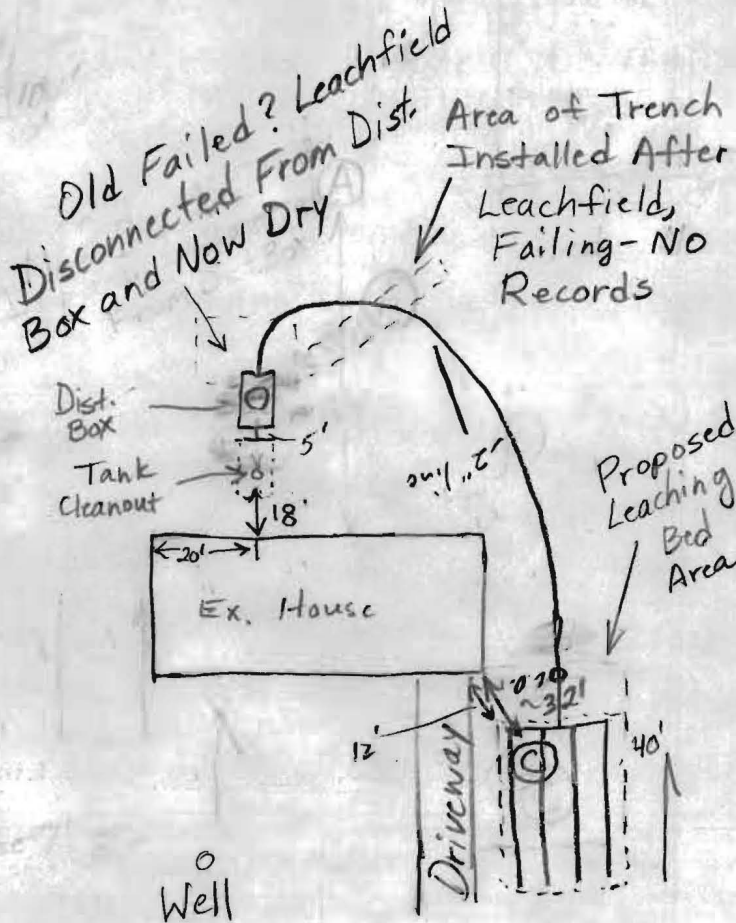

Browns Bridge

TRENCH/DRAINFIELD DATA		
WIDTH	INLET	BOTTOM
20x40	5.5-6.5	7-8
NUMBER OF TRENCHES _____		
TOTAL LENGTH _____		
ABSORPTION AREA _____		
DISTRIBUTION BOX LEVEL _____		
DISTRIBUTION BOX BAFFLE _____		
DISTRIBUTION BOX PORT _____		

SEPTIC TANK DATA	
SEPTIC TANK 1 LEVEL	Existing
CAPACITY	1000 GAL
SEAM LOC	_____
TANK LID DEPTH	_____
BAFFLES	_____
BAFFLE FILTER	_____
MANHOLE LOC	_____
6" PORT LOC	_____
WATERTIGHT TEST	_____
SEPTIC TANK 2 LEVEL	_____
CAPACITY	1000 GAL
SEAM LOC	Top
TANK LID DEPTH	3-3.5
BAFFLES	_____
BAFFLE FILTER	_____
MANHOLE LOC	Center
6" PORT LOC	_____
WATERTIGHT TEST	_____

PRE-CONSTRUCTION 1/6/04 To install pump tank after existing tank and pump to area near test hole (C). To install and pump INSTALLATION to a 20'x40' leachbed with a maximum bottom depth of 8' at the downhill part of the bed that will be parallel to the front of the house. Keep the bottom of the bed level (will be deeper than 8' uphill). Should be enough room for one more bed uphill of the proposed bed if a future repair is needed. (BB) 3/3/04 - P.T. set leaching bed installed. OK to cover. Pump & Alarm needed (SO) 3/15/04 - Pump & Alarm OK (SO)

FINAL INSPECTOR _____

DATE OF APPROVAL _____

3/15/04

5-17-63

5/18/63

05758

~~5/14/63~~

PERMIT

P. 06221
A. 06321

SEWAGE DISPOSAL SYSTEM

MARYLAND STATE DEPARTMENT OF HEALTH

HOWARD COUNTY

ELLICOTT CITY

Incomplete 5/14/63
Carl Barnett

DISTRICT _____

DATE 5/8/63

INDEXED

Carl Barnett
INDEXED

IS PERMITTED TO INSTALL ALTER

ADDRESS _____ PHONE _____

A SEWAGE DISPOSAL SYSTEM LOCATED AT _____

SUBDIVISION Highland Acres ROAD Brown Bridge Rd. LOT 31 20' x 110'

PROPERTY OWNER Carl Barnett Marion + John Rogers

ADDRESS 7606 Brown Bridge Rd. Highland 20777

SPECIFICATIONS Leaching Bed - 20' x 18' (wide)

DRAIN FIELD _____ DEPTH _____ FEET, BOTTOM AREA _____ SQ. FT.

SEEPAGE PITS _____ ABSORBENT SIDE-WALL AREA _____ SQ. FT.

SEPTIC TANK CAPACITY 750 GALLONS

FOR GARAGE GRINDER, INCREASE DISPOSAL AREA 25% & TANK CAPACITY 50%.


OTHER Locate bed 145 ft. from front property line and 55 ft. off the left side line as determined when facing lot from Brown Bridge Rd. Depth of bed 3 feet from top original ground.

PLANS APPROVED BY JHennigan DATE 2/21/63

FILL SEPTIC TANK AND DISTRIBUTION BOX WITH WATER BEFORE CALLING FOR AN INSPECTION. COVER NO WORK UNTIL INSPECTED AND APPROVED.

NEITHER THE HOWARD COUNTY COMMISSIONERS NOR THE HEALTH DEPARTMENT IS RESPONSIBLE FOR THE SUCCESSFUL OPERATION OF ANY SYSTEM.

$$\begin{array}{r} 22 \\ 22 \\ \hline 44 \\ 44 \\ \hline 88 \end{array}$$

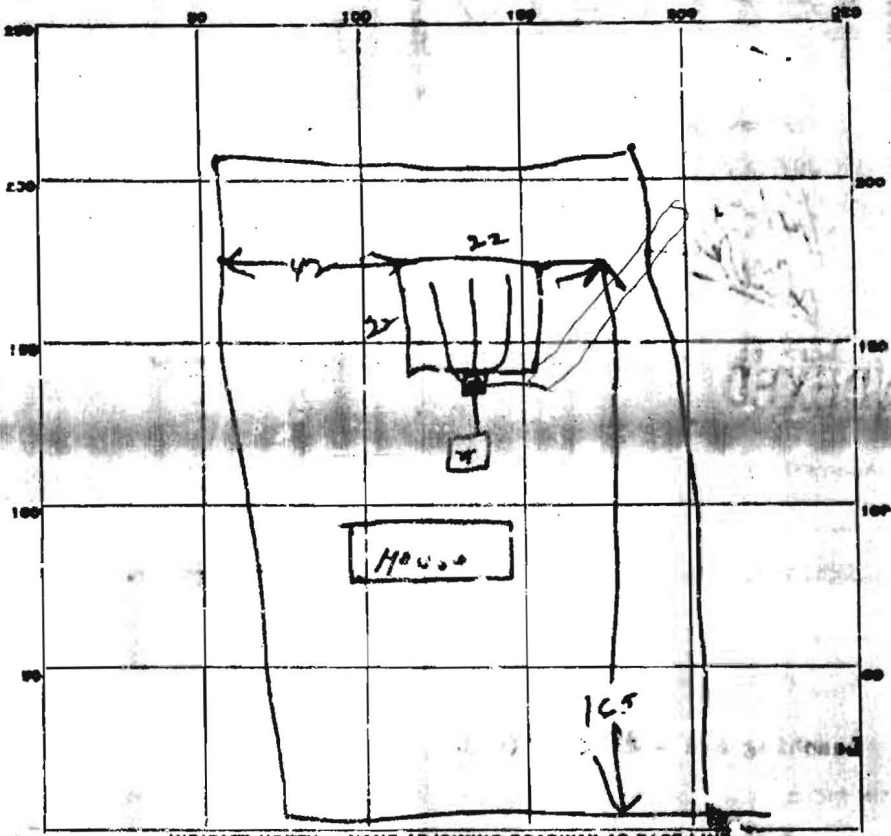

PERMIT CARD OK
 SEPTIC TANK LEVEL OK CLEANOUTS OK 5-17-63
 DISTRIBUTION BOX LEVEL OK
 TILE FIELD, DEPTH .7 FT. TRENCH WIDTH 22 FT.
 GRAVEL DEPTH 36 IN. TOTAL LENGTH 22 FT.
 NUMBER OF TRENCHES _____ TOTAL BOTTOM AREA 484 sq ft
 SEEPAGE PITS, INSIDE DIAMETER _____ FT. DEPTH BELOW INLET _____ FT.
 ABSORBENT AREA _____ SQ. FT.

REMARKS 5/14/63 - need cleanout pipe or septic tank inlet pipe to
septic tank not yet installed. need baffle for dist. box. Paper needs to
be installed over leading end of DM
5-17-63 Work item done

DATE SYSTEM APPROVED 5-17-63 INSPECTOR J. H. [Signature]

High Water Table
Behind House.

Leach bed to have
stone from 7'-8'
in downhill part. Can
be deeper uphill so
that bottom is level.