

APPLICATION

PERCOLATION TESTING

A 514292-C

P _____

HOWARD COUNTY HEALTH DEPARTMENT
BUREAU OF ENVIRONMENTAL HEALTH
3525-H ELLICOTT MILLS DRIVE/ELLICOTT CITY, MARYLAND 21043
TELEPHONE: 313-2640

DISTRICT 5th

DATE _____

TO: THE COUNTY HEALTH OFFICER
ELLICOTT CITY, MARYLAND

I HEREBY APPLY FOR THE NECESSARY TEST PRIOR TO APPLICATION FOR PERMIT TO CONSTRUCT (OR RECONSTRUCT) A SEWAGE DISPOSAL SYSTEM.

PROPERTY OWNER MAPLE LAWN FARMS, INC. c/o MR. GENE JAGER

ADDRESS 11920 ROUTE 216, FULTON, MD 20759 PHONE (301) 674-6327

AGENT OR PROSPECTIVE BUYER (SAME)

ADDRESS _____ PHONE _____

PROPERTY LOCATION:

SUBDIVISION IAGER MANOR LOT NO. 2 & 3

ROAD AND DESCRIPTION SOUTHWEST CORNER OF INTERSECTION OF SIMPSON ROAD
AT PINDELL SCHOOL ROAD

TAX MAP 41 PARCEL # 59

SIZE OF LOT 1.0 Act cluster TYPE BLDG. SFD
(SINGLE FAMILY DWELLING OR COMMERCIAL)

THE SYSTEM INSTALLED UNDER THIS APPLICATION IS ACCEPTABLE ONLY UNTIL PUBLIC FACILITIES BECOME AVAILABLE. I FULLY UNDERSTAND THE FEE CONNECTED WITH THE FILING OF THIS PERC TEST APPLICATION IS NON-REFUNDABLE UNDER ANY CIRCUMSTANCES. I ALSO AGREE TO COMPLY WITH ALL M.O.S.H.A. REQUIREMENTS IN TESTING THIS LOT.

Gene Jager
(SIGNATURE OF APPLICANT)

APPROVED BY _____ FOR _____ DATE _____

DISAPPROVED BY _____ FOR _____ DATE _____

HOLD PENDING FURTHER TESTS _____

REASONS FOR REJECTION OR HOLDING _____

PERCOLATION TEST PLAT/PRELIMINARY PLAT - TITLE OR I.D. # _____ DATE _____

SITE DEVELOPMENT PLAN/FINAL PLAT - TITLE OR I.D. # _____ DATE _____

THIS IS NOT A PERMIT


COUNTY #

LOT No.

SOIL PROFILE

SOIL PROFILE

0' 806
brn red cl
3
brn sa mi loam
10% frags
no mottles discernable
1 1/2
14 H₂O

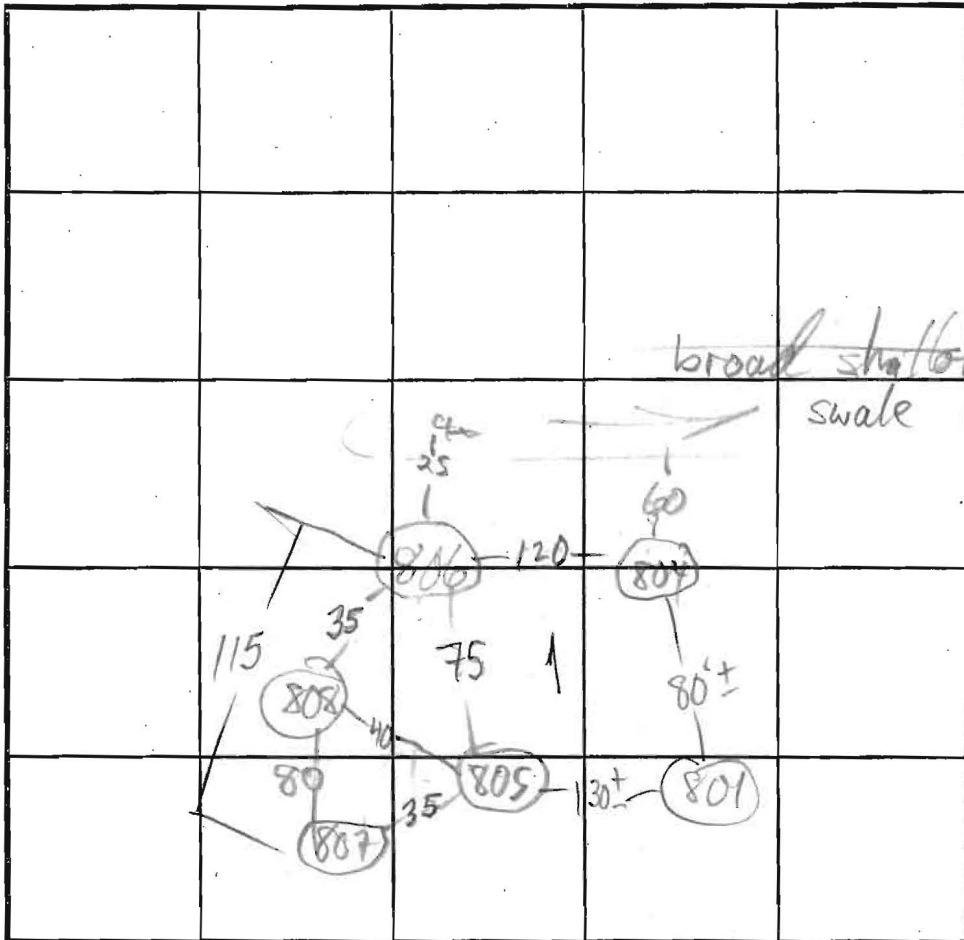

0'
PINEDLL SCHOOL ROAD

INDICATE NORTH - NAME ADJOINING ROADWAY AS BASE LINE.

PROP. ROAD

red yel cl
5
tan yel wh sand
20-30% frags
mottles higher?
14 H₂O

DATE	TEST NO.	DEPTH	PRE-WET		TEST - 1" DROP		TIME
			START	STOP	START	STOP	
12/18/02	804 S	3'9"	11:01	11:15	< 1/4"		
	804 V	14	H ₂ O	@ 14-	HOLD WET SEASON		
	806 S	3'2"	11:54	12:03	12:03	12:16	13
	806 V	14	H ₂ O	12 1/2	HOLD WET SEASON		
	807 S	4'9" 6	12:05 12:23	12:17 12:25	SLOW 12:25	12:30	5
	807 V	13	more tan		40% frags below		11 1/2
	805 V	14'3	OK see profile				
	808 V	13	OK see profile				
	801 S	5' 5'9"	11:19	11:27	11:27	11:39	12
	801 V	15	OK see profile				

REMARKS WST REQ'D @ 804, 806; HOLES PER PLAN

TYPE OF SOIL _____

TESTED BY M. Ritkin ALSO PRESENT J. Fyock crew

TRENCH DESIGN DATA: AVERAGE PERCOLATION TIME _____ TRENCH WIDTH _____

INLET DEPTH 4 MAXIMUM BOTTOM DEPTH 6 SQ. FT./BEDROOM 210 X 0.83

REPAIRS 2.5 4.5 210

805 807 801
808
red brn cl. lm
3-5
brn red
si lm
5-15% frags
13-14