

COUNTY #

SOIL PROFILE

804

beigh
silm

4.0

lgt
orange
silm
w/ feldspar

8.5

or & grey
mottled
silm
feldspar
10%
water

14.0

806

brn
silm

5.0

caving
⊙

11.0

7.5
water

808

red brn
silm


4.0

beigh
to
red
silm

micaceous
no
distinct
H₂O level


13.5

water

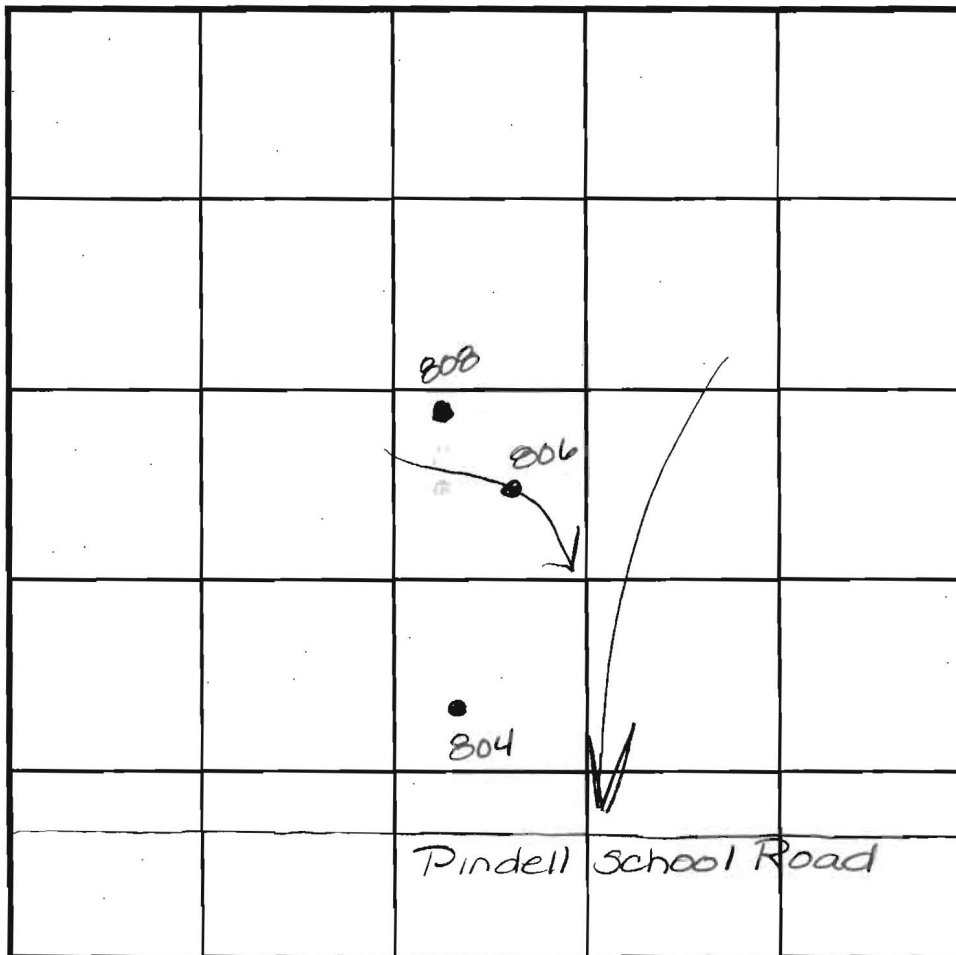

SOIL PROFILE

0'

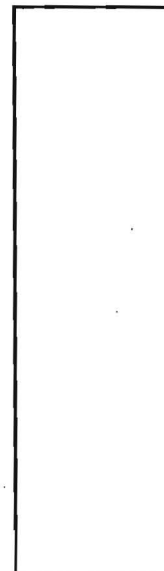

INDICATE NORTH - NAME ADJOINING ROADWAY AS BASE LINE.

DATE	TEST NO.	DEPTH	PRE-WET		TEST - 1" DROP		TIME
			START	STOP	START	STOP	
5-23-01	804	Visual	to 14.0 - see profile		—		OK ✓
	806	Deep clay, insufficient depth to H ₂ O -					F
	808	Visual	to 13.5 - see profile		—		OK ✓

REMARKS An additional 4.0' buffer required due to drought conditions

TYPE OF SOIL _____

TESTED BY Amy McMillen ALSO PRESENT Chuck Crovo

TRENCH DESIGN DATA: AVERAGE PERCOLATION TIME _____ TRENCH WIDTH _____

INLET DEPTH _____ MAXIMUM BOTTOM DEPTH _____ SQ. FT./BEDROOM _____

APPLICATION

PERCOLATION TESTING

A _____

P _____

HOWARD COUNTY HEALTH DEPARTMENT
BUREAU OF ENVIRONMENTAL HEALTH
3525-H ELLICOTT MILLS DRIVE/ELLICOTT CITY, MARYLAND 21043
TELEPHONE: 313-2640

DISTRICT _____

DATE _____

TO: THE COUNTY HEALTH OFFICER
ELLICOTT CITY, MARYLAND

I HEREBY APPLY FOR THE NECESSARY TEST PRIOR TO APPLICATION FOR PERMIT TO CONSTRUCT (OR RECONSTRUCT) A SEWAGE DISPOSAL SYSTEM.

PROPERTY OWNER _____

ADDRESS _____ PHONE _____

AGENT OR PROSPECTIVE BUYER _____

ADDRESS _____ PHONE _____

PROPERTY LOCATION:

SUBDIVISION _____ LOT NO. _____

ROAD AND DESCRIPTION _____

TAX MAP _____ PARCEL # _____

SIZE OF LOT _____ TYPE BLDG. _____
(SINGLE FAMILY DWELLING OR COMMERCIAL)

THE SYSTEM INSTALLED UNDER THIS APPLICATION IS ACCEPTABLE ONLY UNTIL PUBLIC FACILITIES BECOME AVAILABLE. I FULLY UNDERSTAND THE FEE CONNECTED WITH THE FILING OF THIS PERC TEST APPLICATION IS NON-REFUNDABLE UNDER ANY CIRCUMSTANCES. I ALSO AGREE TO COMPLY WITH ALL M.O.S.H.A. REQUIREMENTS IN TESTING THIS LOT.

(SIGNATURE OF APPLICANT)

APPROVED BY _____ FOR _____ DATE _____

DISAPPROVED BY _____ FOR _____ DATE _____


HOLD PENDING FURTHER TESTS _____

REASONS FOR REJECTION OR HOLDING _____

PERCOLATION TEST PLAT/PRELIMINARY PLAT - TITLE OR I.D. # _____ DATE _____

SITE DEVELOPMENT PLAN/FINAL PLAT - TITLE OR I.D. # _____ DATE _____

THIS IS NOT A PERMIT

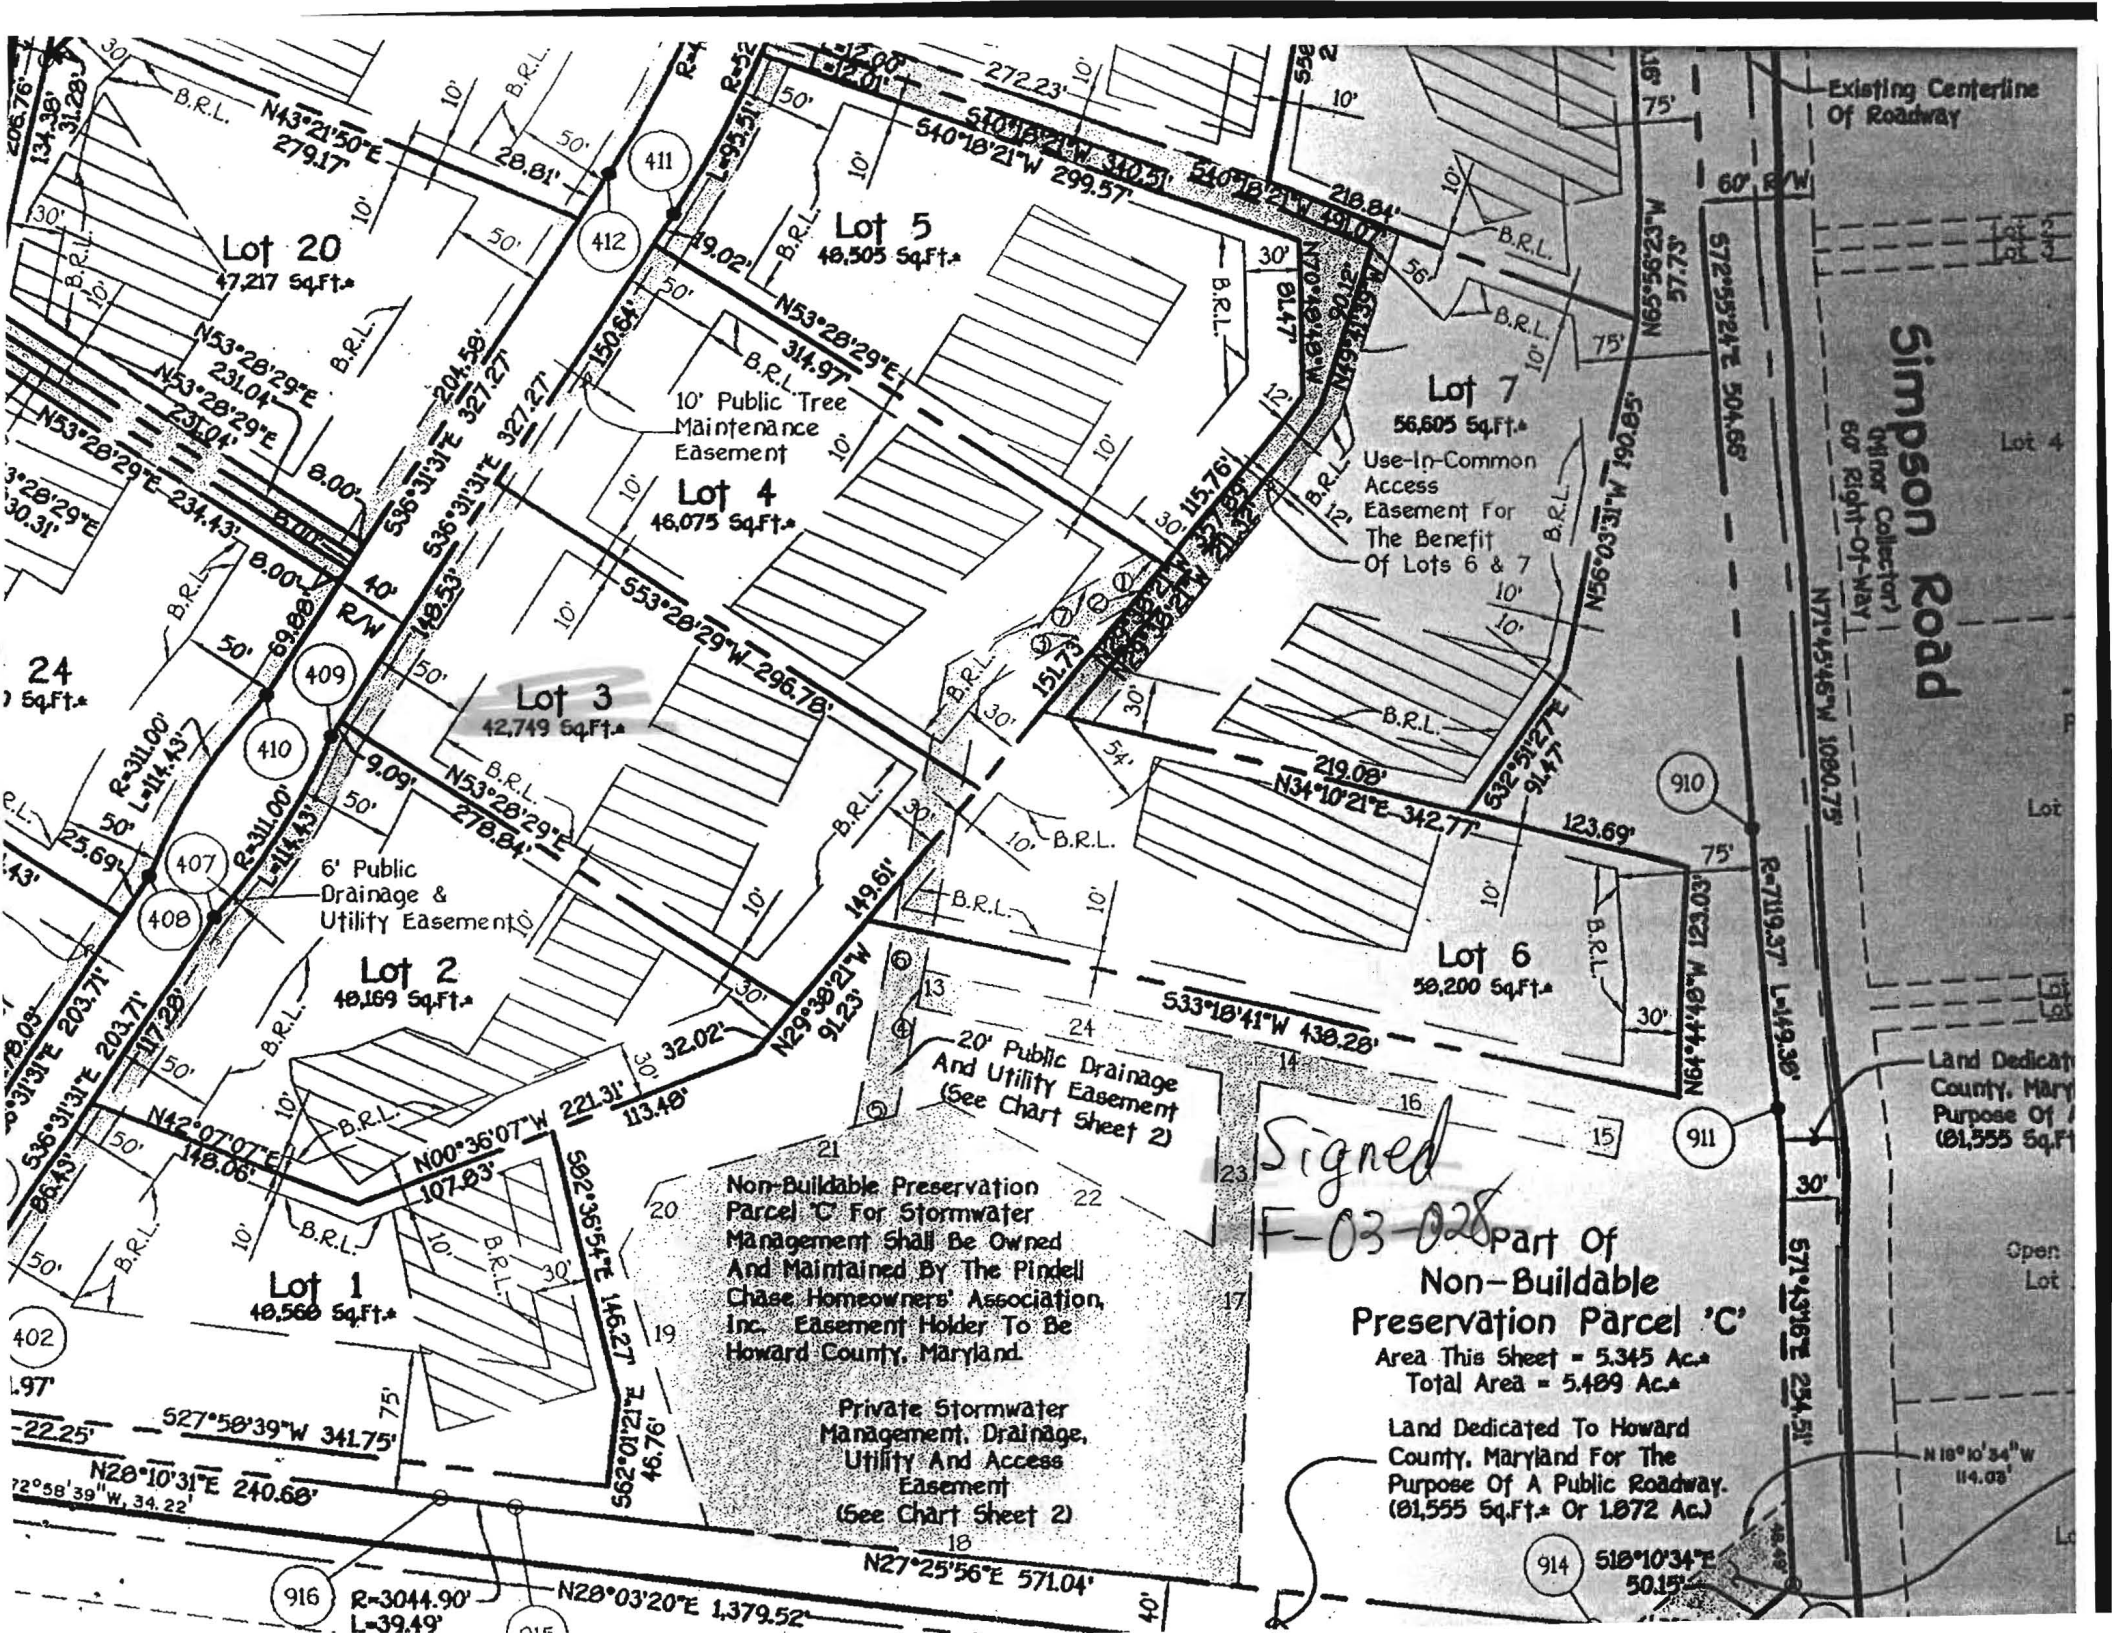

Lot 20
47,217 Sq.Ft.±

Lot 5
48,505 Sq.Ft.±

Lot 7
56,605 Sq.Ft.±

Lot 4
46,075 Sq.Ft.±

Lot 3
42,749 Sq.Ft.±

Lot 2
48,169 Sq.Ft.±

Lot 1
48,568 Sq.Ft.±

Lot 6
58,200 Sq.Ft.±

Non-Buildable Preservation Parcel 'C' For Stormwater Management Shall Be Owned And Maintained By The Pindell Chase Homeowners' Association, Inc. Easement Holder To Be Howard County, Maryland.

Private Stormwater Management, Drainage, Utility And Access Easement (See Chart Sheet 2)

20' Public Drainage And Utility Easement (See Chart Sheet 2)

Use-In-Common Access Easement For The Benefit Of Lots 6 & 7

6' Public Drainage & Utility Easement

10' Public Tree Maintenance Easement

Signed
F-03-028 part of
Non-Buildable
Preservation Parcel 'C'

Area This Sheet = 5.345 Ac.±
Total Area = 5.489 Ac.±

Land Dedicated To Howard County, Maryland For The Purpose Of A Public Roadway. (81,555 Sq.Ft.± Or 1.872 Ac.)


Existing Centerline Of Roadway


Simpson Road
Minor Collector
60' Right-Of-Way

Land Dedicated To Howard County, Maryland For The Purpose Of A Public Roadway. (81,555 Sq.Ft.± Or 1.872 Ac.)

Open Lot

N 18° 10' 34" W
114.03'

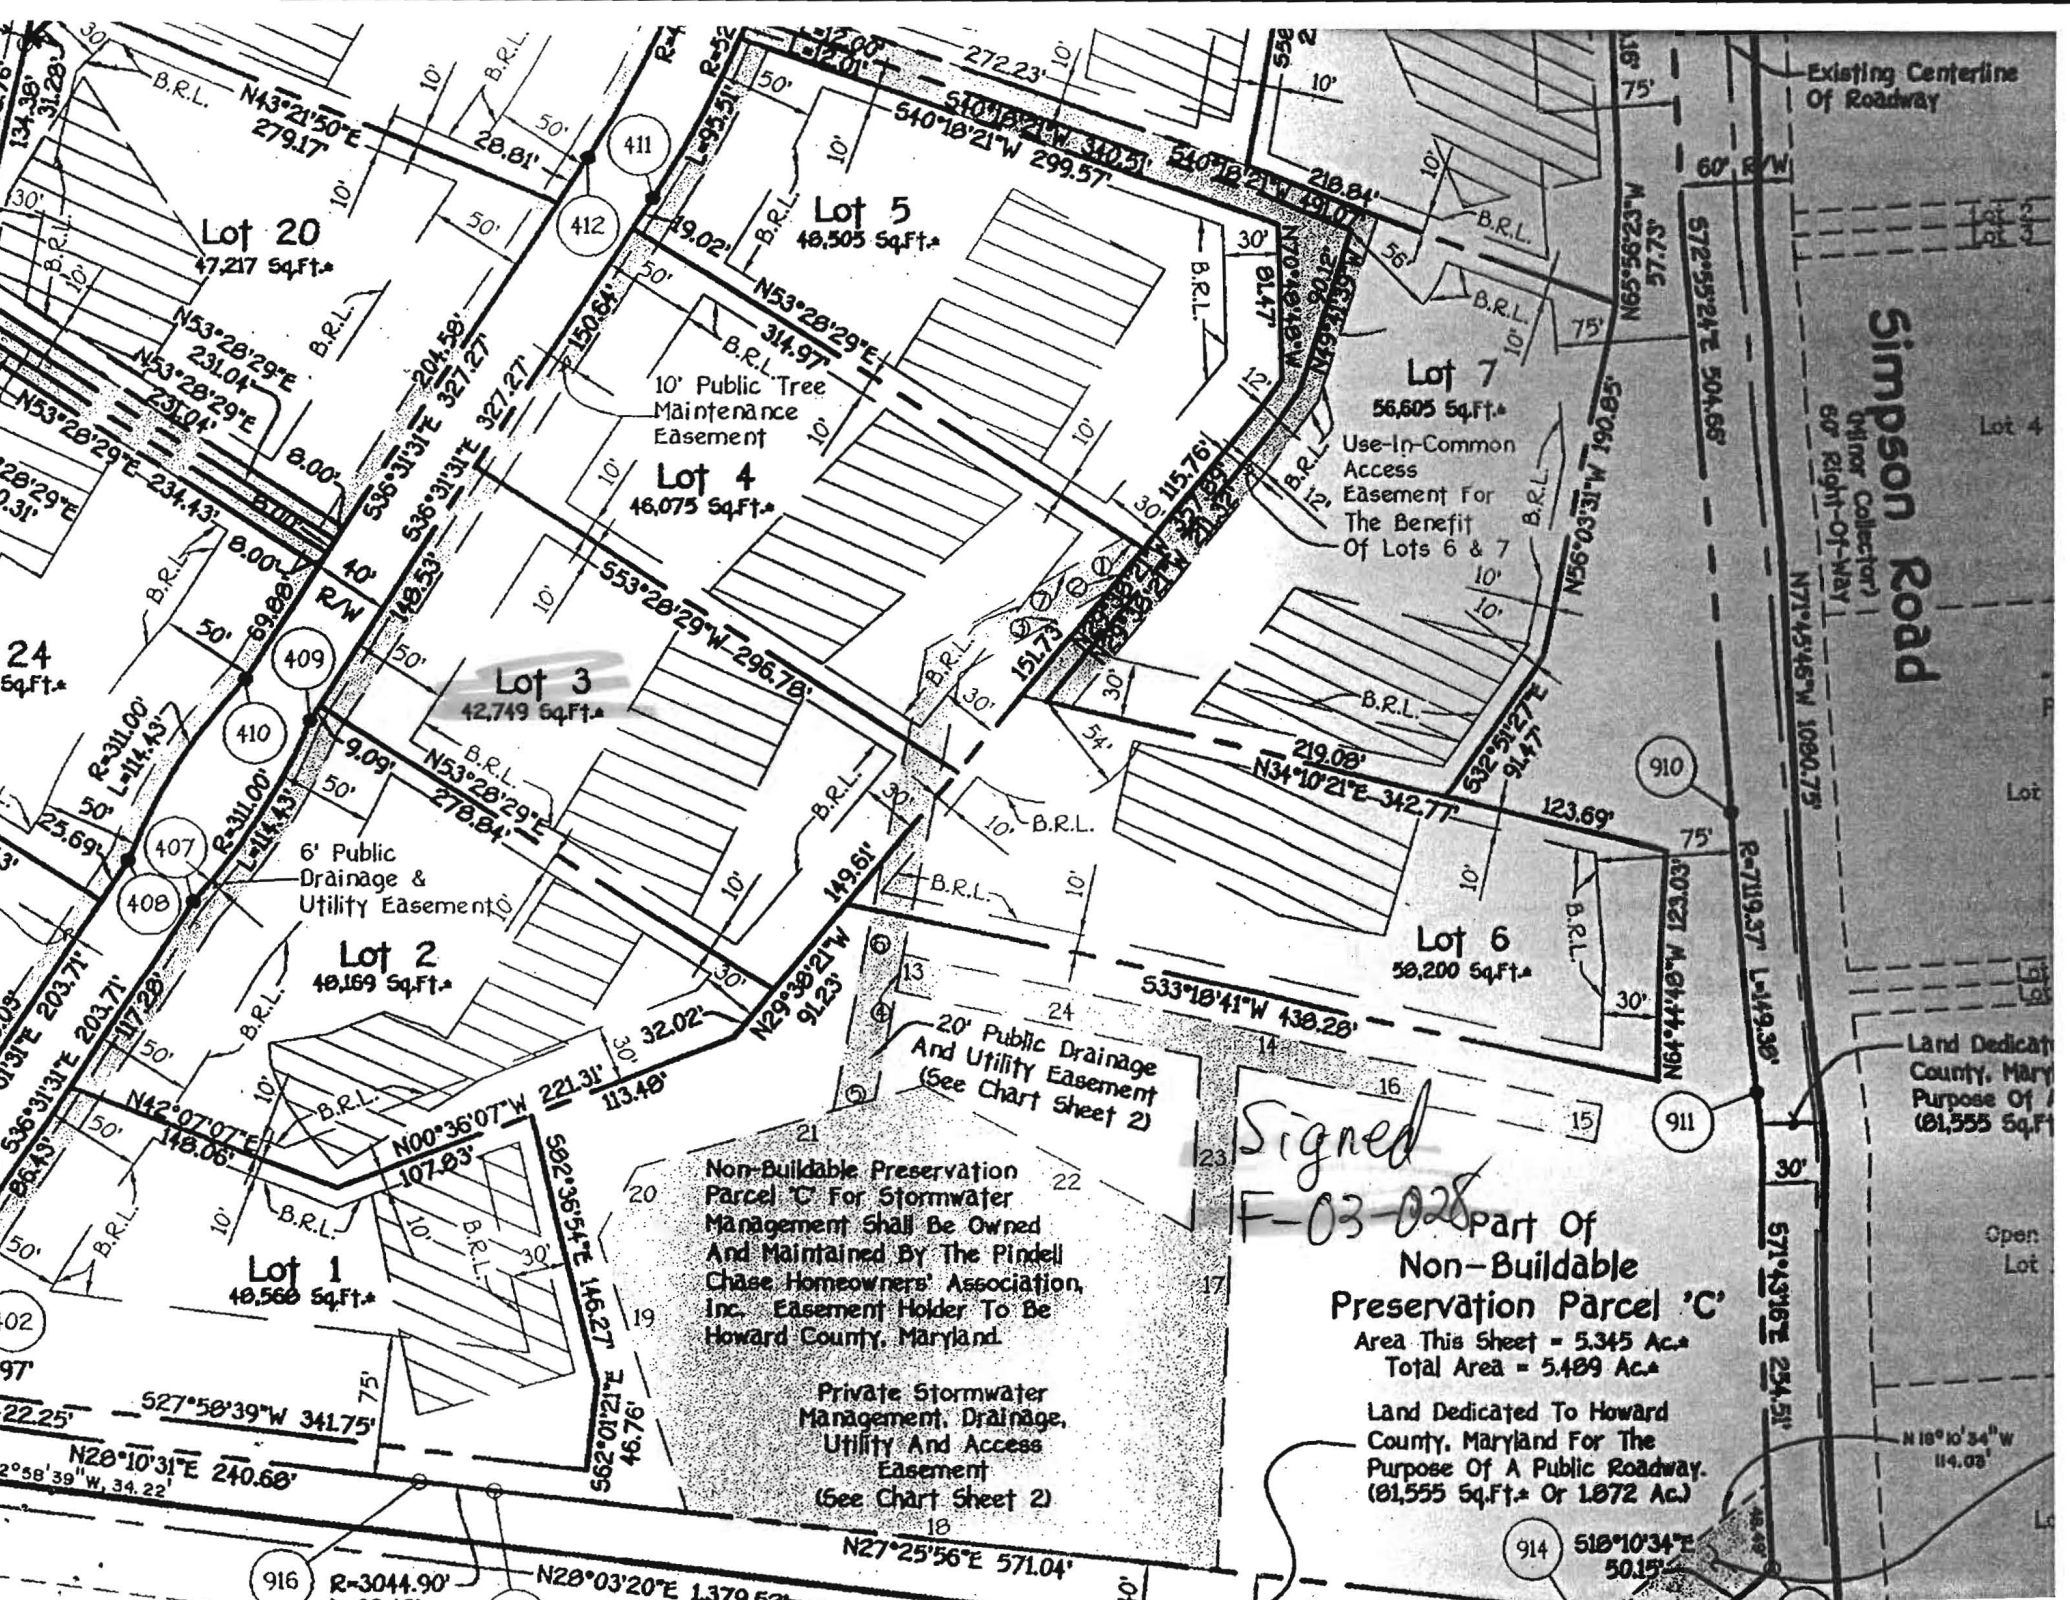

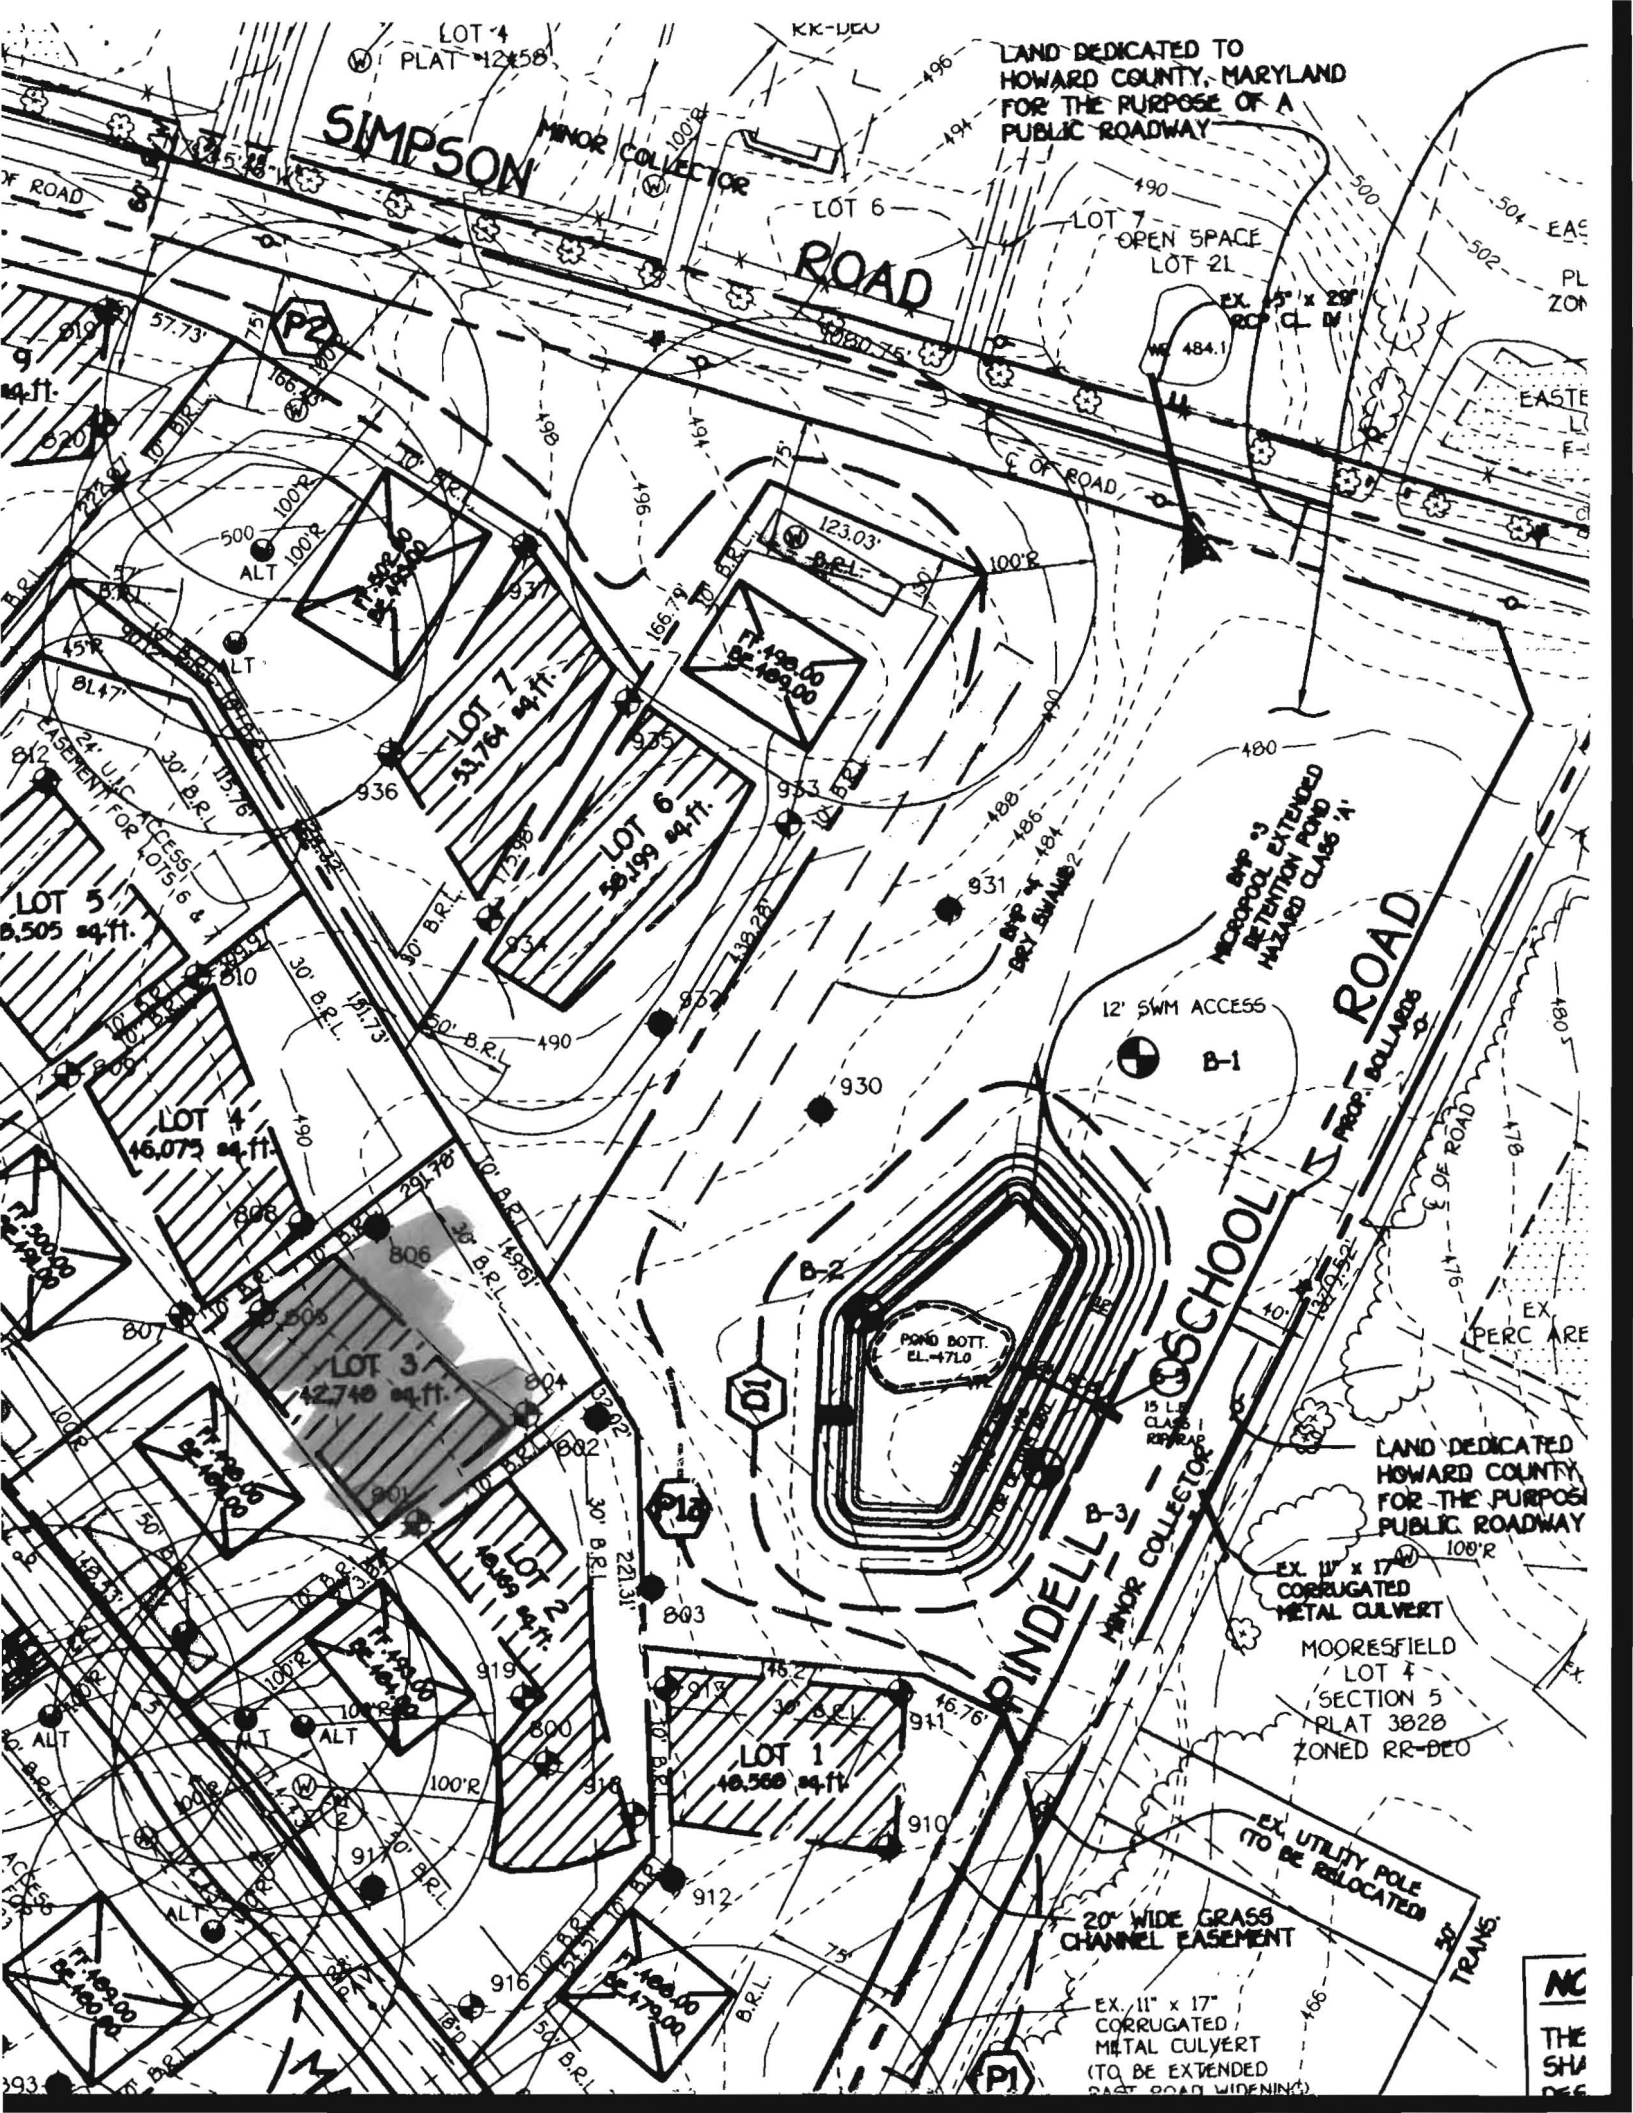

LOT 4
PLAT 12458

KK-DEU

LAND DEDICATED TO
HOWARD COUNTY, MARYLAND
FOR THE PURPOSE OF A
PUBLIC ROADWAY

SIMPSON ROAD

LOT 6
ROAD

LOT 7
OPEN SPACE
LOT 21

LOT 5
5,505 sq. ft.

LOT 7
33,764 sq. ft.

LOT 6
38,199 sq. ft.

LOT 4
46,075 sq. ft.

LOT 3
42,748 sq. ft.

LOT 2
40,469 sq. ft.

LOT 1
40,560 sq. ft.

PINDELL ROAD

ROAD

EX. 11" x 17"
CORRUGATED
METAL CULVERT

MOORESFIELD
LOT 4
SECTION 5
PLAT 3828
ZONED RR-DEO

20' WIDE GRASS
CHANNEL EASEMENT

EX. 11" x 17"
CORRUGATED
METAL CULVERT
(TO BE EXTENDED
EAST ROAD WIDENING)

NC
THE SH
DE