

4/26/73

Permitted 1/26/73
R. Tom 2/24/73
Permitted C.K.

(3)

PERMIT

P 17751

A 10323

SEWAGE DISPOSAL SYSTEM

MARYLAND STATE DEPARTMENT OF HEALTH

HOWARD COUNTY

ELLICOTT CITY

DISTRICT 5

DATE 12/4/72

12/18/72
2/26/73
2/1/74
OK WWZ

12/15/72 - 14 noon
visual hole insp.

11:30 INDEXED

Index completed but not app'd; as per P.W. WWZ.

Edwards Construction Co. IS PERMITTED TO INSTALL X ALTER

ADDRESS _____ PHONE 286-3725

A SEWAGE DISPOSAL-SYSTEM LOCATED AT _____

SUBDIVISION Green Hill Manor ROAD Montell Court LOT 2, Blk. A

PROPERTY OWNER V. L. Vinella

ADDRESS _____

SPECIFICATIONS - 3 bedrooms

DRAIN FIELD _____ DEPTH _____ FEET, BOTTOM AREA _____ SQ. FT.

SEEPAGE PITS _____ ABSORBENT SIDE-WALL AREA _____ SQ. FT.

SEPTIC TANK CAPACITY 1,000 GALLONS

FOR GARBAGE GRINDER, INCREASE DISPOSAL AREA 22% & TANK CAPACITY 50%.

OTHER Dry well - 300 sq. ft. sidewall area below inlet ⁵ ft. deep. Max. depth
permitted ¹³ ft. unless visual inspection of hole allows you to go further down.

Place the dry well 100 ft. to 130 ft. from the back lot line and 20 ft. to 50 ft.
from the left side of the lot as seen when facing the lot from Montell Court.

PERMIT VOID AFTER THREE YEARS. NOTHING TO BE INSTALLED IN EXCAVATION UNTIL INSPECTED
NOTE: ALL PIPE FROM HOUSE TO SEPTIC TANK MUST BE CAST IRON.

PLANS APPROVED BY Raymond Hodges/Frommelt DATE 3/17/66 - 12/4/72


NOTE: INSTALL STAND PIPE ON SEPTIC TANK AND DRY WELL.

FILL SEPTIC TANK AND DISTRIBUTION BOX WITH WATER BEFORE CALLING FOR AN INSPECTION. COVER NO WORK UNTIL INSPECTED AND APPROVED.

NEITHER THE HOWARD COUNTY COMMISSIONERS NOR THE HEALTH DEPARTMENT IS RESPONSIBLE FOR THE SUCCESSFUL OPERATION OF ANY SYSTEM.

12-15-72. depth & inlet changes per visual hole S.F.

A 10323

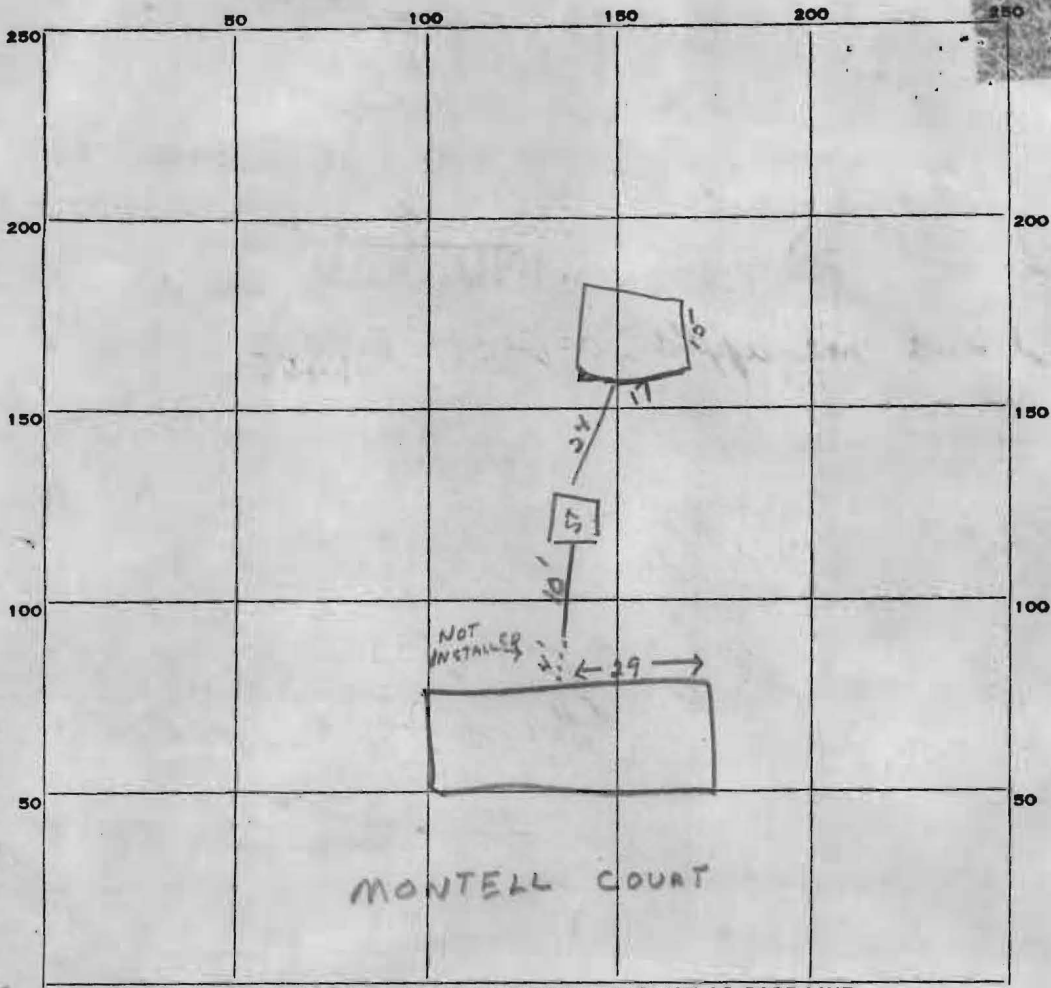

INDICATE NORTH. - NAME ADJOINING ROADWAY AS BASE LINE.

PERMIT CARD _____

SEPTIC TANK, LEVEL 1000gal CLEANOUTS OK (X)

DISTRIBUTION BOX, LEVEL _____

TILE FIELD, DEPTH _____ FT. TRENCH WIDTH _____ FT.

GRAVEL DEPTH _____ IN. TOTAL LENGTH _____ FT.

NUMBER OF TRENCHES _____ TOTAL BOTTOM AREA _____

SEEPAGE PITS, outside perimeter 64 FT. DEPTH BELOW INLET 8 1/4 FT.

ABSORBENT AREA 528 SQ. FT.

REMARKS 1/26/73 - To call for final after crack in dry well lid is closed and dry well is completely backfilled with stone
2/26/73 D. Well completely covered. Needs RT cap for dry well cleanout. Hold & discuss with Supervisor or R.T. OK

DATE SYSTEM APPROVED _____ INSPECTOR _____