


**LEON A. PODOLAK AND ASSOCIATES**  
**SURVEYING AND CIVIL ENGINEERING**

63 EAST MAIN STREET, P.O. BOX 266  
 WESTMINSTER, MARYLAND 21157  
 TELEPHONES: WESTMINSTER 848-2229 BALTIMORE 876-1226

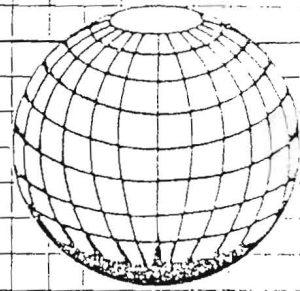


B00145987

1/28/04



Proposed Deck  
 Location O.K.

(BB)

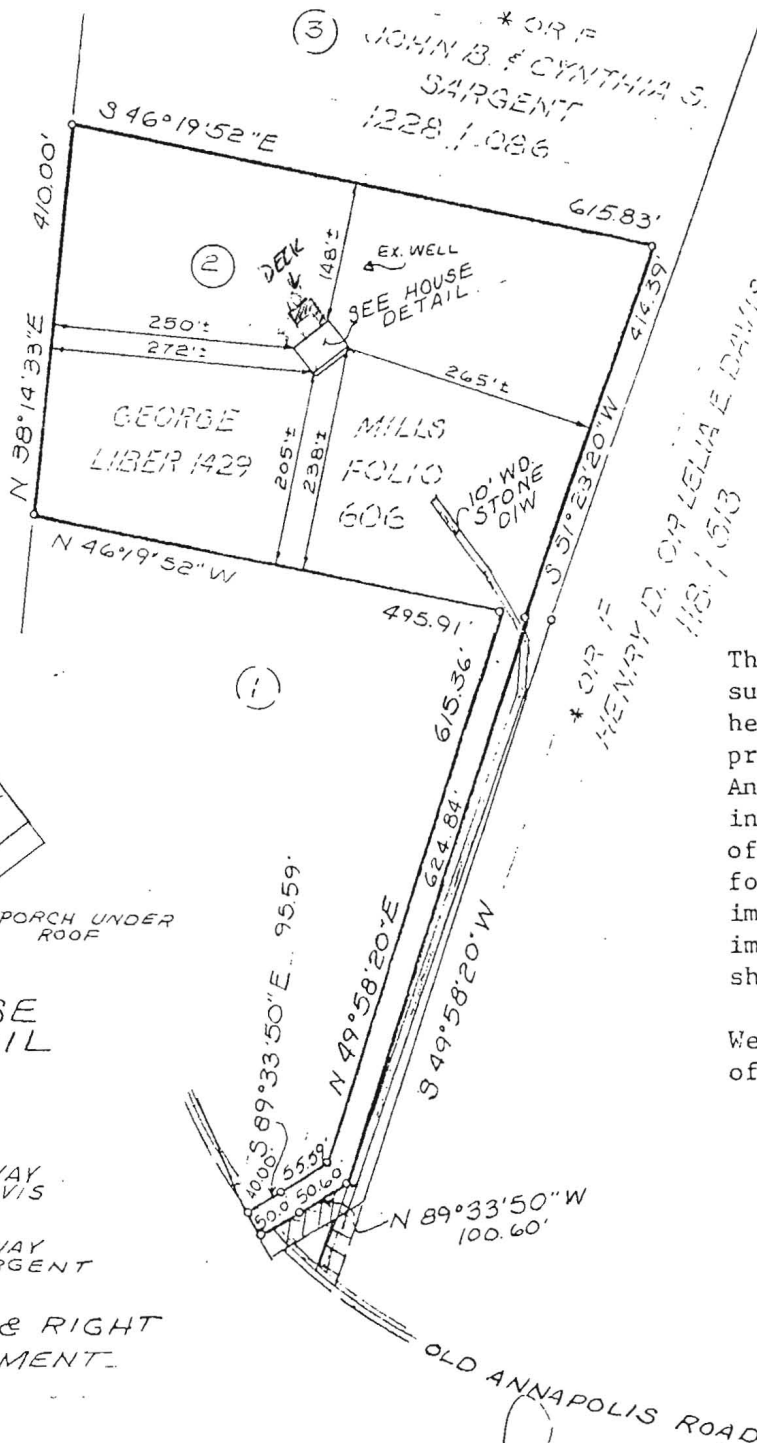

This is to certify that I have surveyed the property shown hereon, known as George Mills property, located at 1947 Old Annapolis Road, near Woodbine in the 4-th Election District of Howard County, Maryland for the purpose of locating improvements only and that the improvements are located as shown.

Westminster, this 24-th day of September, 1986.

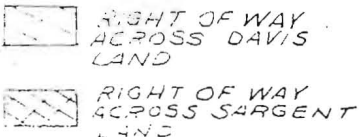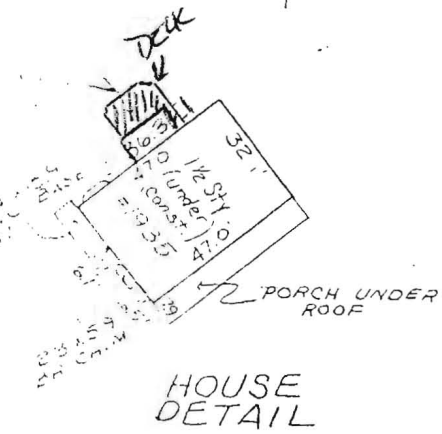

EASEMENT & RIGHT OF WAY AGREEMENT  
 1429 / 610



*Leon A. Podolak*