


Testing the same groundwater conditions are
 under the same property.
 George D. Mills III 525-2255
 P35 OLD ANNAPOLIS RD.
 WINDHOLM MD 21797
 445.91'

Home - 9 bedrooms
 OLD ANNAPOLIS RD.

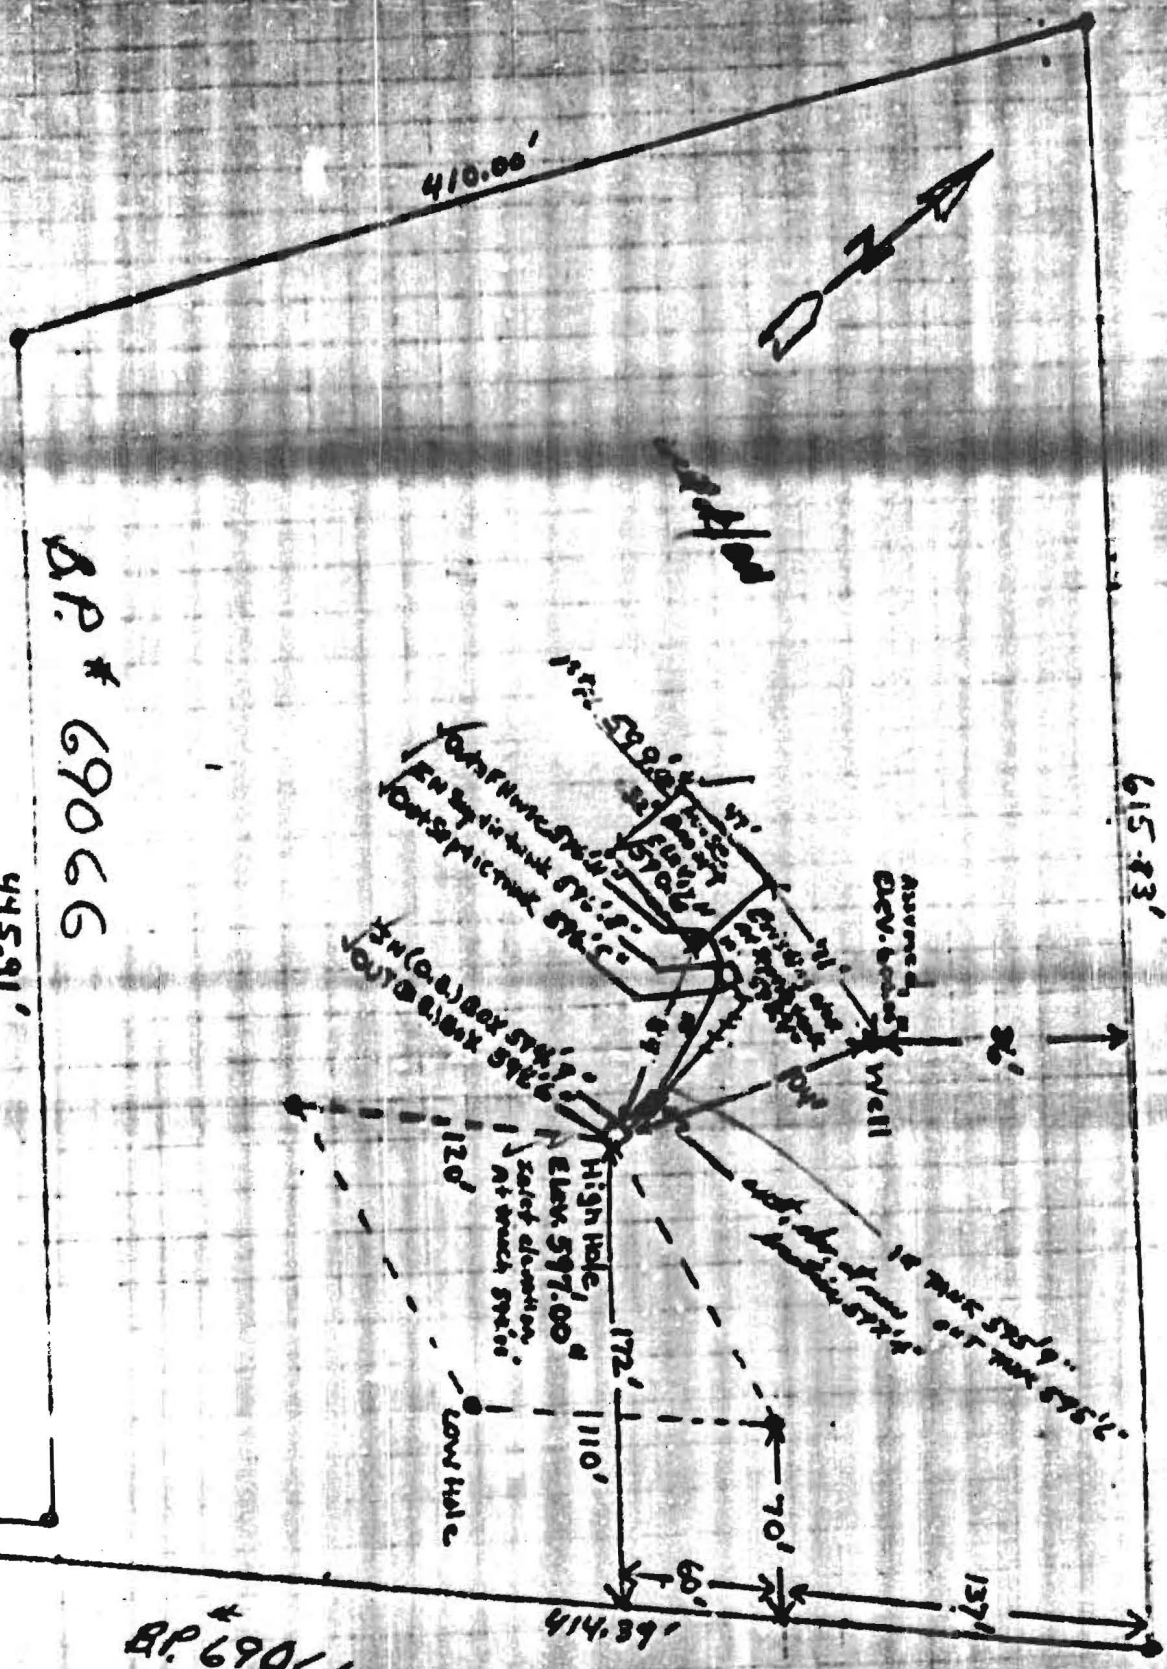

BP # 69066

BP # 69066