

# APPLICATION

A 1964

## SEWAGE DISPOSAL TESTING

F \_\_\_\_\_

STATE OF MARYLAND - DEPARTMENT OF HEALTH AND MENTAL HYGIENE

HOWARD COUNTY HEALTH DEPARTMENT  
ENVIRONMENTAL HEALTH SERVICES  
P. O. BOX 670, ELLICOTT CITY, MARYLAND 21040  
TELEPHONE: 486-6000, EXT. 300

DISTRICT 1

DATE 1/21/64

TO: THE COUNTY HEALTH OFFICER  
ELLICOTT CITY, MARYLAND

I, HEREBY, APPLY FOR THE NECESSARY TEST IN ORDER TO CONSTRUCT (OR RECONSTRUCT) A SEWAGE DISPOSAL SYSTEM.

PROPERTY OWNER MR. & MRS. RUBY LEE BIRD, JR.

ADDRESS 18116 Union Street Road, Middleburg, Md. 21767 PHONE 482-2822

PROPERTY LOCATION:

SUBDIVISION \_\_\_\_\_ LOT NO. 2

ROAD AND DESCRIPTION Old Jerusalem Road (across from Sutter's Christmas tree farm)

SIZE OF LOT 3.722 acres TYPE BLDG. 1 1/2

IF NOT SINGLE RESIDENCE RESORCE \_\_\_\_\_  
(Single Only, Bldg.)

THE SYSTEM INSTALLED UNDER THIS APPLICATION IS ACCEPTABLE ONLY UNTIL PUBLIC FACILITIES BECOME AVAILABLE.

SIGNATURE OF APPLICANT /s/ Ruby Lee

APPROVED BY \_\_\_\_\_ FOR \_\_\_\_\_ DATE \_\_\_\_\_

(KIND OF SYSTEM)

REJECTED BY \_\_\_\_\_ FOR \_\_\_\_\_ DATE \_\_\_\_\_


(KIND OF SYSTEM)

HOLD PENDING FURTHER TESTS \_\_\_\_\_ DATE \_\_\_\_\_

REASONS FOR REJECTION OR HOLDING \_\_\_\_\_

# THIS IS NOT A PERMIT

# APPLICATION

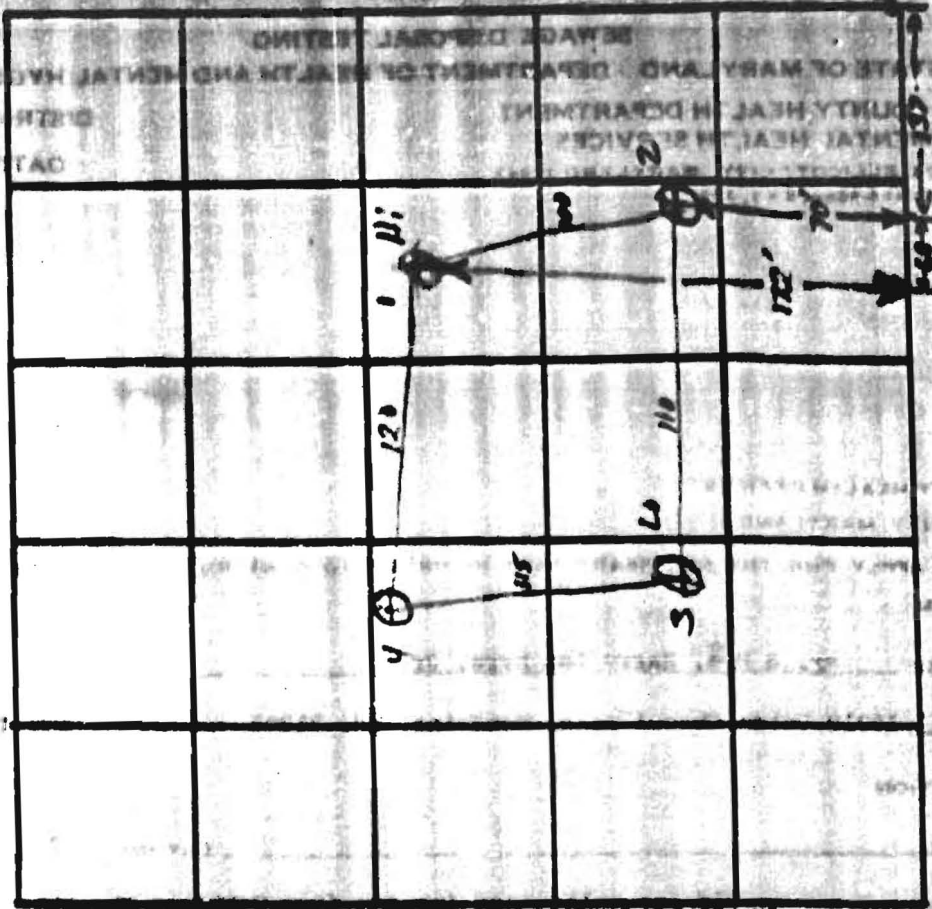

(Old Amp. R/W)

DATE	TEST NO.	DEPTH	PRE-WET		TEST - 1" DROP		TIME
			START	STOP	START	STOP	
3/10	1	12	11 <sup>16</sup>	11 <sup>19</sup>	11 <sup>19</sup>	11 <sup>28</sup>	17
	1A	3	11 <sup>58</sup>	12 <sup>05</sup>	12 <sup>00</sup>	12 <sup>14</sup>	9
	2	10	VIS	Shale			
	3	11	11 <sup>30</sup>	52nd	12 <sup>05</sup>		28 shale
	3A	4	11 <sup>39</sup>	11 <sup>41</sup>	11 <sup>41</sup>	11 <sup>46</sup>	5
	4	12	As	red loam			

REMARKS \_\_\_\_\_  
 TYPE OF SOIL Shale, shale, clay and red loam  
relative to other tests