

LAYOUT _____ INSP 4 _____
INSP 2 _____ INSP 5 _____
INSP 3 _____ INSP 6 _____

ISSUE DATE: _____
APPROVAL DATE: _____

PERMIT INDEXED

P _____
A 520090-A

ON-SITE SEWAGE DISPOSAL SYSTEM HOWARD COUNTY HEALTH DEPARTMENT BUREAU OF ENVIRONMENTAL HEALTH

05-343194

IS PERMITTED TO INSTALL ALTER

ADDRESS: _____ PHONE NUMBER: _____

SUBDIVISION: Beaufort Park LOT NUMBER: 7, Blk E

ADDRESS: 8510 Edenton Road PROPERTY OWNER: Rudolph Biro

SEPTIC TANK CAPACITY (GALLONS): _____ OUTLET BAFFLE FILTER REQUIRED

PUMP CHAMBER CAPACITY (GALLONS): _____ COMPARTMENTED TANK REQUIRED

NUMBER OF BEDROOMS: _____

SQUARE FEET PER BEDROOM: _____

LINEAR FEET OF TRENCH REQUIRED: _____

| | |
|-----------|---|
| TRENCHES: | Trench to be _____ feet wide. Inlet _____ feet below original grade. Bottom maximum depth _____ feet below original grade. Effective area begins at _____ feet below original grade. _____ feet of stone below distribution pipe. |
| LOCATION: | |
| NOTES: | |

PLANS APPROVED: _____ DATE: _____

- NOTE: PERMIT VOID AFTER 2 YEARS
- NOTE: CONTRACTOR RESPONSIBLE FOR SCHEDULING A PRE-CONSTRUCTION INSPECTION FOR ALL INSTALLATIONS
- NOTE: WATERTIGHT SEPTIC TANKS REQUIRED
- NOTE: ALL PARTS OF SEPTIC SYSTEM SHALL BE 100 FEET FROM ANY WATER WELL
- NOTE: MANHOLE RISERS REQUIRED ON ALL SEPTIC TANKS AND PUMP CHAMBERS UNLESS SPECIFICALLY AUTHORIZED

**NEITHER THE HOWARD COUNTY COUNCIL NOR THE HEALTH DEPARTMENT IS
RESPONSIBLE FOR THE SUCCESSFUL OPERATION OF ANY SYSTEM
PERMITTEE RESPONSIBLE FOR OBTAINING FINAL APPROVAL ON THIS PERMIT
CALL 410-313-2640 FOR INSPECTION OF SEPTIC SYSTEM**

4520090-A

12/12/73

12/10/73 *terminal*
12/10/73 *terminal*

PERMIT

P 19029

A 09906

SEWAGE DISPOSAL SYSTEM

MARYLAND STATE DEPARTMENT OF HEALTH

HOWARD COUNTY

ELLICOTT CITY

DISTRICT 5th

DATE 10/2/73

12/10/73

INDEXED

Cumberland and Co., In.c.

IS PERMITTED TO INSTALL ALTER

ADDRESS 701 Midland Road, Silver Spring, Md. 20904 PHONE 985 384-1770

A SEWAGE DISPOSAL SYSTEM LOCATED AT _____

SUBDIVISION Beaufort Park ROAD Edenton Road LOT 7, Blk. E, Plat 2

PROPERTY OWNER Mr. and Mrs. Rudolph P. Biro

ADDRESS _____

SPECIFICATIONS 4 bedrooms

DRAIN FIELD _____ DEPTH _____ FEET, BOTTOM AREA _____ SQ. FT.

SEEPAGE PITS _____ ABSORBENT SIDE-WALL AREA _____ SQ. FT.

SEPTIC TANK CAPACITY 1200 GALLONS

FOR GARBAGE GRINDER, INCREASE DISPOSAL AREA 22% & TANK CAPACITY 50%.

OTHER DRY WELL - Dig pit 15 ft. square - set block and top for 12 ft. diameter and fill in rest of pit with gravel. Dry well to have 8 ft. effective depth below the first 4 ft. of original grade. Maximum depth permitted for dry well is 12 ft. below original grade. Come off dry well with 4 ft. solid pipe and begin trench - trench to be 15 ft. long - 12 ft. deep - with 8 ft. gravel under pipe. Call for inspection of trench before gravel is installed. Place dry well 130 ft. from rear lot line and 60 ft. from left side line as seen when facing lot from the front - trench to go toward left sideline.


NOTE: ALL PIPE FROM HOUSE TO DRY WELL MUST BE CAST IRON. PERMIT VOID AFTER THREE YEARS. NOTE: INSTALL STAND PIPE ON SEPTIC TANK AND DRY WELL.

PLANS APPROVED BY Donald W. Monaghan DATE 7/31/73

FILL SEPTIC TANK AND DISTRIBUTION BOX WITH WATER BEFORE CALLING FOR AN INSPECTION. COVER NO WORK UNTIL INSPECTED AND APPROVED.

NEITHER THE HOWARD COUNTY COMMISSIONERS NOR THE HEALTH DEPARTMENT IS RESPONSIBLE FOR THE SUCCESSFUL OPERATION OF ANY SYSTEM.

A
149966

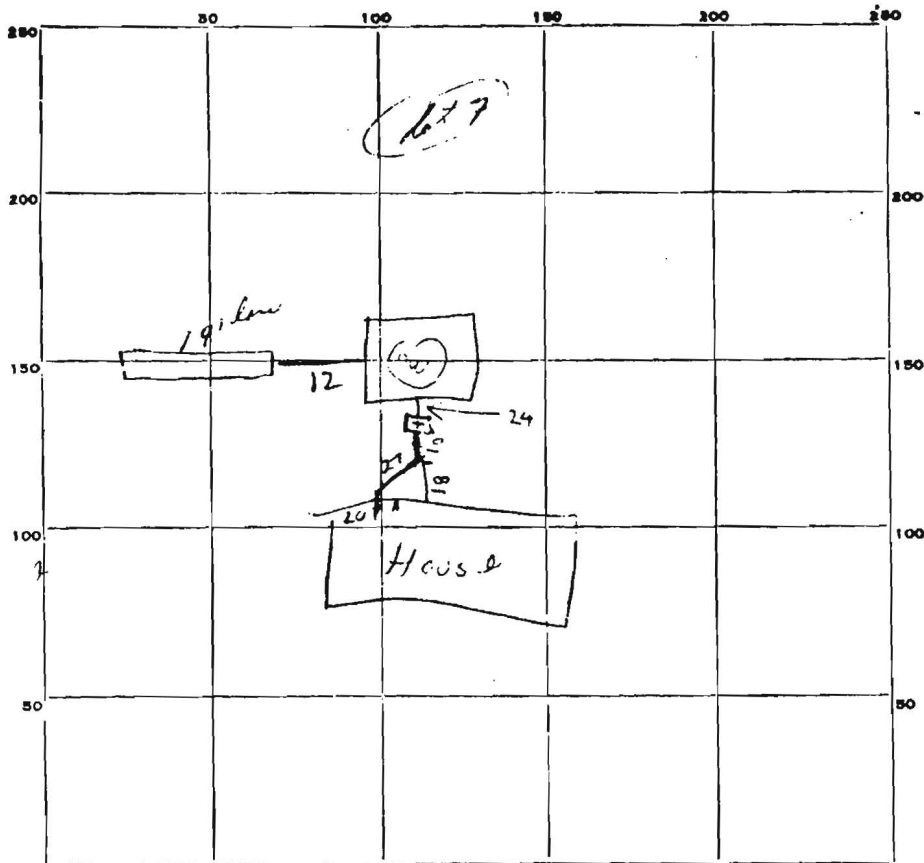

PERMIT CARD P/4

SEPTIC TANK, LEVEL OK - concrete 120 CLEANOUTS 4' drilled 18" in 2

DISTRIBUTION BOX, LEVEL Top is 9' above ground 7' up R. should be 9'

FILE FIELD, DEPTH 19 1/2 FT. TRENCH WIDTH 2 FT.

GRAVEL DEPTH 9 FT IN. TOTAL LENGTH 19 FT.

NUMBER OF TRENCHES 1 SIDEWALL TOTAL BOTTOM AREA 334

SEEPAGE PITS, INSIDE DIAMETER 7 FT. DEPTH BELOW INLET 9 FT.

ABSORBENT AREA 198 SQ. FT. not counting slo.

REMARKS 12/6/73 OK to put gravel in trench 12/10/73 Gravel
put in trench. Gravel used covered with soil
and r. ...
...
...
...

DATE SYSTEM APPROVED 1/23/74 INSPECTOR Harmond Hodges

Cumberland and Company, Inc.

PLUMBING AND HEATING CONTRACTORS

701 MIDLAND ROAD • SILVER SPRING, MARYLAND 20904

TELEPHONE 384-1770 • 384-4821

January 1, 1974

Dear Sir We have

Mr. Carl Trumbull
Howard County Health Department
Pillnitz City, Maryland 21122

Dear Sir:

In response to your letter of January 11, 1974, regarding the septic system installed on Leauford Park, Edenton Road, Lot 2, Block 7, Plat 2. I have today discussed this matter with Mr. Raymond Bridges.

He has advised me that these pre-cast concrete rings are still in an experimental stage. I did not know this. I am therefore advising you that I will be responsible for the pre-cast rings used in this septic system if for any reason they cave in.

Sincerely yours,

William Cumberland
William Cumberland

1/23/74 FF rust system

no go approval

called Cumberland

Sealed, signed, dated 1/23/74

R.H.