

7108
 1 2 3 (SEQ. NO.) 4
 THIS NUMBER IS TO BE PUNCHED
 IN COLS. 3, 4 ON ALL CARDS

STATE OF MARYLAND
 WATER RESOURCES ADMINISTRATION
 TAWES STATE OFFICE BLDG., ANNAPOLIS, MD. 21401
 WELL COMPLETION REPORT

THIS REPORT MUST BE SUBMITTED WITHIN
 IN 30 DAYS AFTER WELL COMPLETION

FILL IN THIS FORM COMPLETELY

COUNTY NUMBER **A 09906**

DATE RECEIVED _____ DATE WELL COMPLETED 2-17-74 DEPTH OF WELL 300
 22 (TO NEAREST FOOT) 26

PERMIT NO. FROM "PERMIT TO DRILL WELL" **H0-73-0575**
 28 29 30 31 32 33 34 35 36 37

DRILLERS IDENTIFICATION NO. _____

OWNER Bino LOT # 7 Beaufort Pt. FIRST NAME _____
 LAST NAME _____
 STREET OR RFD. 2514 POST OFFICE _____

WELL LOG

STATE THE KIND OF FORMATIONS PENETRATED, THEIR
 R. DEPTH, THICKNESS AND IF WATER BEARING

DESCRIPTION FEET (CHECK IF WATER BEARING)
 USE ADDITIONAL SHEETS IF NECESSARY: FROM TO

Handwritten notes:
 sandstone - 31'
 no rock 31' - 300'

GROUTING RECORD

WELL HAS BEEN GROUTED (CIRCLE APPROPRIATE BOX) Y N

TYPE OF GROUTING MATERIAL (CIRCLE BOX):
 CEMENT M BENTONITE CLAY BC

NO. OF BAGS 11 NO. OF POUNDS 1134

GALLONS OF WATER 25

DEPTH OF GROUT SEAL (TO NEAREST FOOT)
 FROM 0 FT. TO 300 FT.
 (ENTER 0 IF FROM SURFACE)

CASING RECORD

(INSERT APPROPRIATE CODE BELOW)

STEEL S1 C0 CONCRETE
 PLASTIC PL OT OTHER

MAIN CASING TYPE NOMINAL DIAMETER OF MAIN CASING (NEAREST INCH) 1 7/8 TOTAL DEPTH OF MAIN CASING (NEAREST FOOT) 23

OTHER CASING

DIAMETER (INCH) _____ IF USED: DEPTH (FEET) FROM _____ TO _____

SCREEN RECORD

(INSERT APPROPRIATE CODE BELOW)

STEEL ST BR BRASS OR BRONZE HO OPEN HOLE
 PLASTIC PL OT OTHER

DEPTH (NEAREST WHOLE FOOT)

FROM TO

1 2 3 4 5 6 7 8 9 10 11 12 13 14 15 16 17 18 19 20 21 22 23 24 25 26 27 28 29 30 31 32 33 34 35 36 37 38 39 40 41 42 43 44 45 46 47 48 49 50 51

SLOTS SIZE 1. _____ 2. _____ 3. _____

PUMPING TEST

HOURS PUMPED (TO NEAREST HOUR) _____

PUMPING RATE (GALLONS PER MINUTE TO NEAREST GALLON) _____

METHOD USED TO MEASURE PUMPING RATE air

WATER LEVEL (DISTANCE FROM LAND SURFACE)

BEFORE PUMPING 80 (NEAREST FOOT)
 WHEN PUMPING 10 (NEAREST FOOT)

TYPE OF PUMP USED (CIRCLE APPROPRIATE BOX) (FOR PUMPING TEST):
 A AIR P PISTON T TURBINE
 C CENTRIFUGAL R ROTARY O OTHER (DESCRIBE BELOW)
 J JET S SUBMERSIBLE

PUMP INSTALLED

TYPE OF PUMP (WRITE APPROPRIATE LETTER IN BOX - SEE ABOVE: A, C, J, P, R, S, T, O) _____

DRILLER WILL INSTALL PUMP (CIRCLE APPROPRIATE BOX) Y N

CAPACITY: GALLONS PER MINUTE (TO NEAREST GALLON) _____

PUMP HORSE POWER _____

PUMP COLUMN LENGTH (NEAREST FOOT) _____

CASING HEIGHT (CIRCLE APPROPRIATE BOX AND ENTER CASING HEIGHT)

+ ABOVE - BELOW } LAND SURFACE _____ (NEAREST FOOT)

LOCATION OF WELL ON LOT

SHOW PERMANENT STRUCTURE SUCH AS BUILDINGS, SEPTIC TANKS, AND/OR OTHER LAND MARKS AND INDICATE NOT LESS THAN TWO DISTANCES (MEASUREMENTS TO WELL).

CIRCLE APPROPRIATE BOXES

A WELL WAS ABANDONED AND SEALED WHEN THIS WELL WAS COMPLETED

B ELECTRIC LOG OBTAINED

C BEST WELL CONVERTED TO PRODUCTION WELL

I HEREBY CERTIFY THAT I HAVE COMPLIED WITH ALL CONDITIONS STATED ON THE ABOVE-CAPTIONED "PERMIT TO DRILL WELL", AND THAT INFORMATION CONTAINED IN THIS REPORT IS TRUE, ACCURATE, AND COMPLETE TO THE BEST OF MY KNOWLEDGE, INFORMATION AND BELIEF.

DRILLER NAME _____

DATE _____

SIGNATURE _____

DIAMETER OF SCREEN _____ (NEAREST INCH) FROM _____ TO _____

GRAVEL PACK _____

IF WELL DRILLED WAS A FLOWING WELL (CIRCLE BOX) F N

BAR USE ONLY (NOT TO BE FILLED IN BY DRILLER):
 Y (I.P.O.S.) W 2
 73 72 74 75 76 OTHER DATA AVAILABLE

TELESCOPE CASING LOG INDICATOR

Handwritten notes:
 grout 1-30-74
 15' open - 23 cases, not grouted to clean out
 2-17-74 20 1/2' open
 11' open cement - C.B.S.

MARYLAND DEPARTMENT OF THE ENVIRONMENT, WATER MANAGEMENT ADMINISTRATION
2500 BROENING HIGHWAY, BALTIMORE, MARYLAND 21224, (410) 631-3784

WATER WELL ABANDONMENT-SEALING REPORT FORM

SUBMIT COPIES OF COMPLETED FORM TO:

- * COUNTY ENVIRONMENT AGENCY (contact MDE, WMA if address needed)
- * WELL OWNER
- * MDE, WATER MANAGEMENT ADMINISTRATION, WELL PROGRAM

DATE WELL ABANDONED: July 8, 2003 (month/day/year)

* PERMIT NUMBER OF ABANDONED WELL (if any) HO - 73 - 0575


* PERMIT NUMBER OF REPLACEMENT WELL _____

* PERSON ABANDONING WELL: Richard A. Crumolt WELL DRILLERS LICENSE NUMBER: WR0014

CIRCLE: MWD/MSD/MGD

* OWNER'S NAME: Rudy Biko

SITE LOCATION MAP

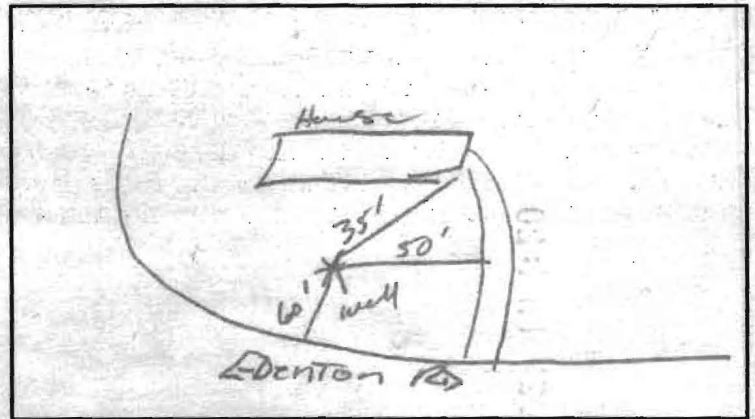

* WELL LOCATION:
 COUNTY: HOWARD
 NEAREST TOWN: FULTON
 TAX MAP _____ BLOCK _____ PARCEL _____
 SUBDIVISION: _____
 SECTION: _____ LOT: _____
 NEAREST ROAD: 8510 Edenton Rd

Lot 7 BQE Plat 2
Beaufort Park
Built 1974

* TYPE OF WELL BEING ABANDONED:

- DRILLED _____ JETTED
- _____ BORED/AUGERED _____ HAND DUG
- _____ OTHER (specify) _____

* USE CODE:

- DOMESTIC _____ MUNICIPAL/PUBLIC
- _____ IRRIGATION _____ INDUSTRIAL
- _____ TEST/OBSERVATION _____ GEOTHERMAL

* TYPE OF CASING:

- STEEL _____ PLASTIC
- _____ CONCRETE _____ OTHER (specify) _____

* SIZE OF CASING: 6 INCHES IN DIAMETER

* DEPTH OF WELL: 300 FEET DEEP

* WAS ANY CASING REMOVED? YES _____ NO
if yes, length removed, in feet: 3

* WAS CASING RIPPED OR PERFORATED? _____ YES NO

LOG OF SEALING MATERIAL

MATERIAL	FEET	
	FROM	TO
Gravel	300	160
Bestonite	160	5
Cement	5	1
DIT	1	0

VOLUME OF MATERIAL USED

Gravel - 100
 Bestonite - 3 bags
 Cement - 1 bag

SIGNATURE-MASTER WELL DRILLER OR SUPERVISING SANITARIAN
George F. [Signature]

LICENSE # 040

CIRCLE ONE MWD/MSD/MGD

DATE 7-23-03

