

W-4
2-65

STATE OF MARYLAND
DEPARTMENT OF
WATER RESOURCES

State Office Building
ANNAPOLIS, MARYLAND 21401

THIS REPORT
MUST BE SUBMITTED
WITHIN 30 DAYS
AFTER COMPLETION
OF THE WELL

Elmer Bras WELL COMPLETION REPORT **A 09298**

WELL DESCRIPTION

Permit Number HO-66-W-272
Owner Elmer Bras
Address 517 W. Capitol St
Subdivision Belmont Park
Section 2 Lot 475

WELL LOG
State the kind of formations penetrated, their color, their depth, their thickness, and if water-bearing

CASING AND SCREEN RECORD
State the kind and size and position of casing, liner, shoe, screen, and other accessories. (If no casing used, give diameter of well).

PUMPING TEST
Hours Pumped 2
Type of Pump Used 1 1/2"
Pumping Rate _____
Gallons per Minute 2

WATER LEVEL
Distance from land surface to water:
Before Pumping 50 Ft.
When Pumping 300 Ft.


APPEARANCE OF WATER
Clear _____ Cloudy _____
Taste _____
Odor _____

Height of Casing Above Land
Surface 2 Ft.

PUMP INSTALLED
Type _____
Capacity _____
Gallons per Minute _____
Gallons per Hour _____
Pump Column Length _____ Ft.

	FEET from ___ to ___		DIAM. (inches)	FEET from ___ to ___
Top Soil	0-3	Steel	6 1/2"	78 to 88
Sandy	3-25			
Sand Stone	25-60			
Hicker Rock	60-70			
Water	80			

LOCATION OF WELL ON LOT
Show permanent structures such as building(s), septic tank, and/or other landmarks and indicate not less than 2 distances (measurements) to well.

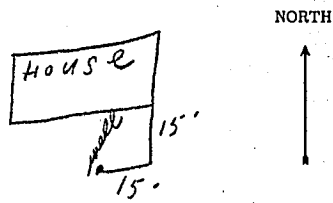

HO 66-W-272

Date Well Was Completed 4/20/66

Well Driller Signature *Elmer Bras*

HO
It