


A18221

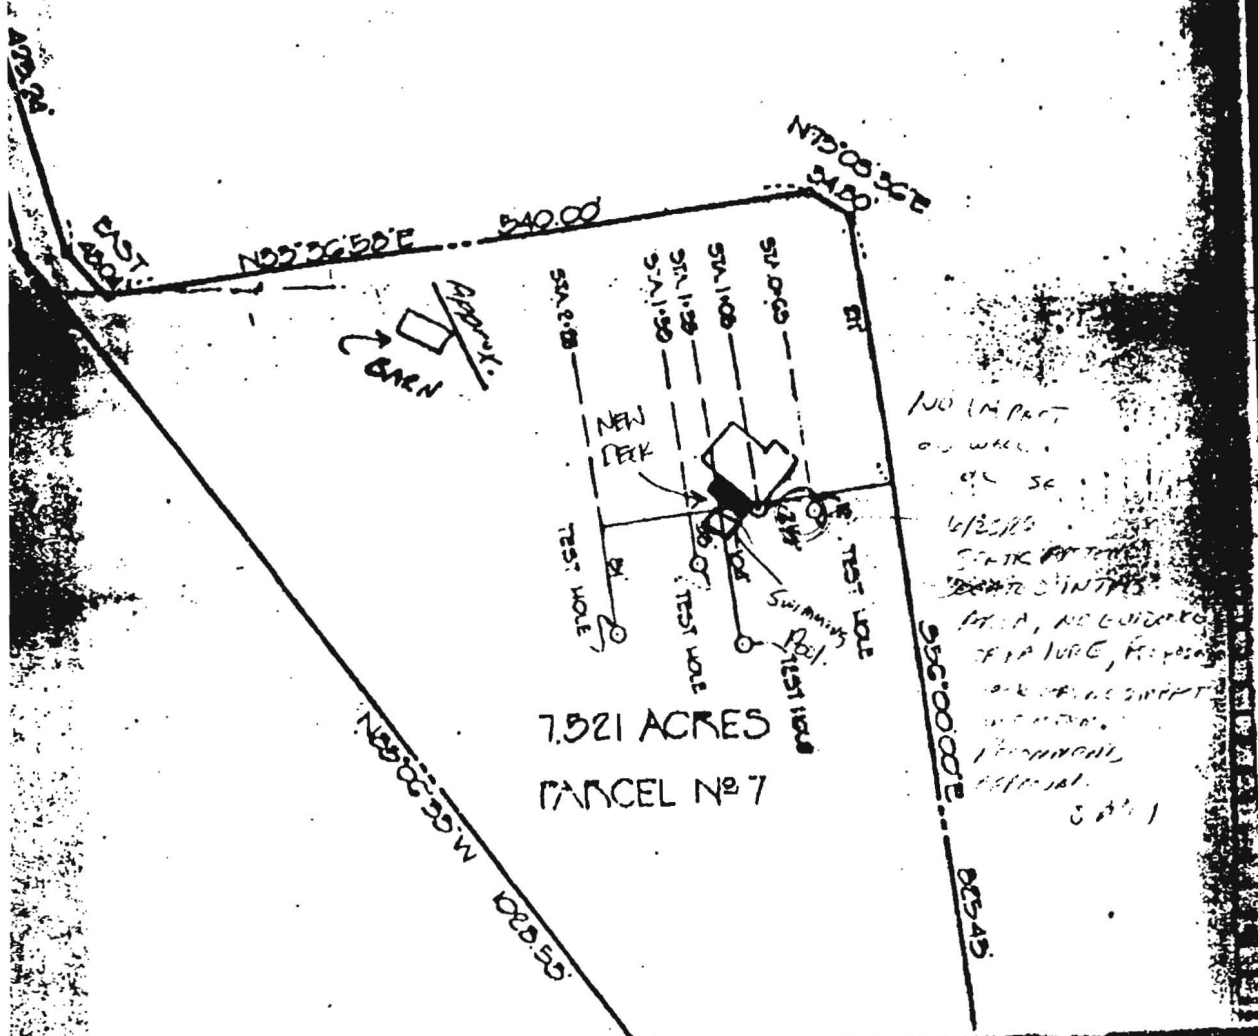

7.521 ACRES
PARCEL No 7

NO IMPACT
 ON WELL
 OR SE
 4/25/73
 SINK AT THE
 DEPT. INTAS
 AT A, NO EVIDENCE
 OF A LURE, FISHING
 OR FISHING
 FISHING
 FISHING

SECTION 0000E

00545

APPLICATION

A 18221

SEWAGE DISPOSAL TESTING

P _____

STATE OF MARYLAND - DEPARTMENT OF HEALTH AND MENTAL HYGIENE

HOWARD COUNTY HEALTH DEPARTMENT
ENVIRONMENTAL HEALTH SERVICES

DISTRICT 5th

P. O. BOX 476, ELLICOTT CITY, MARYLAND 21043
TELEPHONE: 465-5000, EXT. 356

DATE 4/6/73

TO: THE COUNTY HEALTH OFFICER
ELLICOTT CITY, MARYLAND

I, HEREBY, APPLY FOR THE NECESSARY TEST IN ORDER TO CONSTRUCT (OR RECONSTRUCT) A SEWAGE DISPOSAL SYSTEM.

PROPERTY OWNER Raymond E. & Dorothy B. Anderson

ADDRESS 5703 -36th Avenue, Hyattsville, Md. PHONE 277-1573

PROPERTY LOCATION:

SUBDIVISION _____ LOT NO. Parcel # 7

ROAD AND DESCRIPTION Deer Valley Road - Route 216 to Ink Hollow Road to Deer Valley Road - about 1/2 mile in on left hand side.

SIZE OF LOT 7.521 acres TYPE BLDG. 3 or 4 bedrooms
NUMBER OF BEDROOMS _____

IF NOT SINGLE RESIDENCE DESCRIBE _____

THE SYSTEM INSTALLED UNDER THIS APPLICATION IS ACCEPTABLE ONLY UNTIL PUBLIC FACILITIES BECOME AVAILABLE.

SIGNATURE OF APPLICANT Raymond E. Anderson

APPROVED BY _____ FOR _____ DATE _____
(KIND OF SYSTEM)

REJECTED BY _____ FOR _____ DATE _____
(KIND OF SYSTEM)

HOLD PENDING FURTHER TESTS _____ DATE _____

REASONS FOR REJECTION OR HOLDING _____

THIS IS NOT A PERMIT

